


#12318

Mills Avenue

RD

W

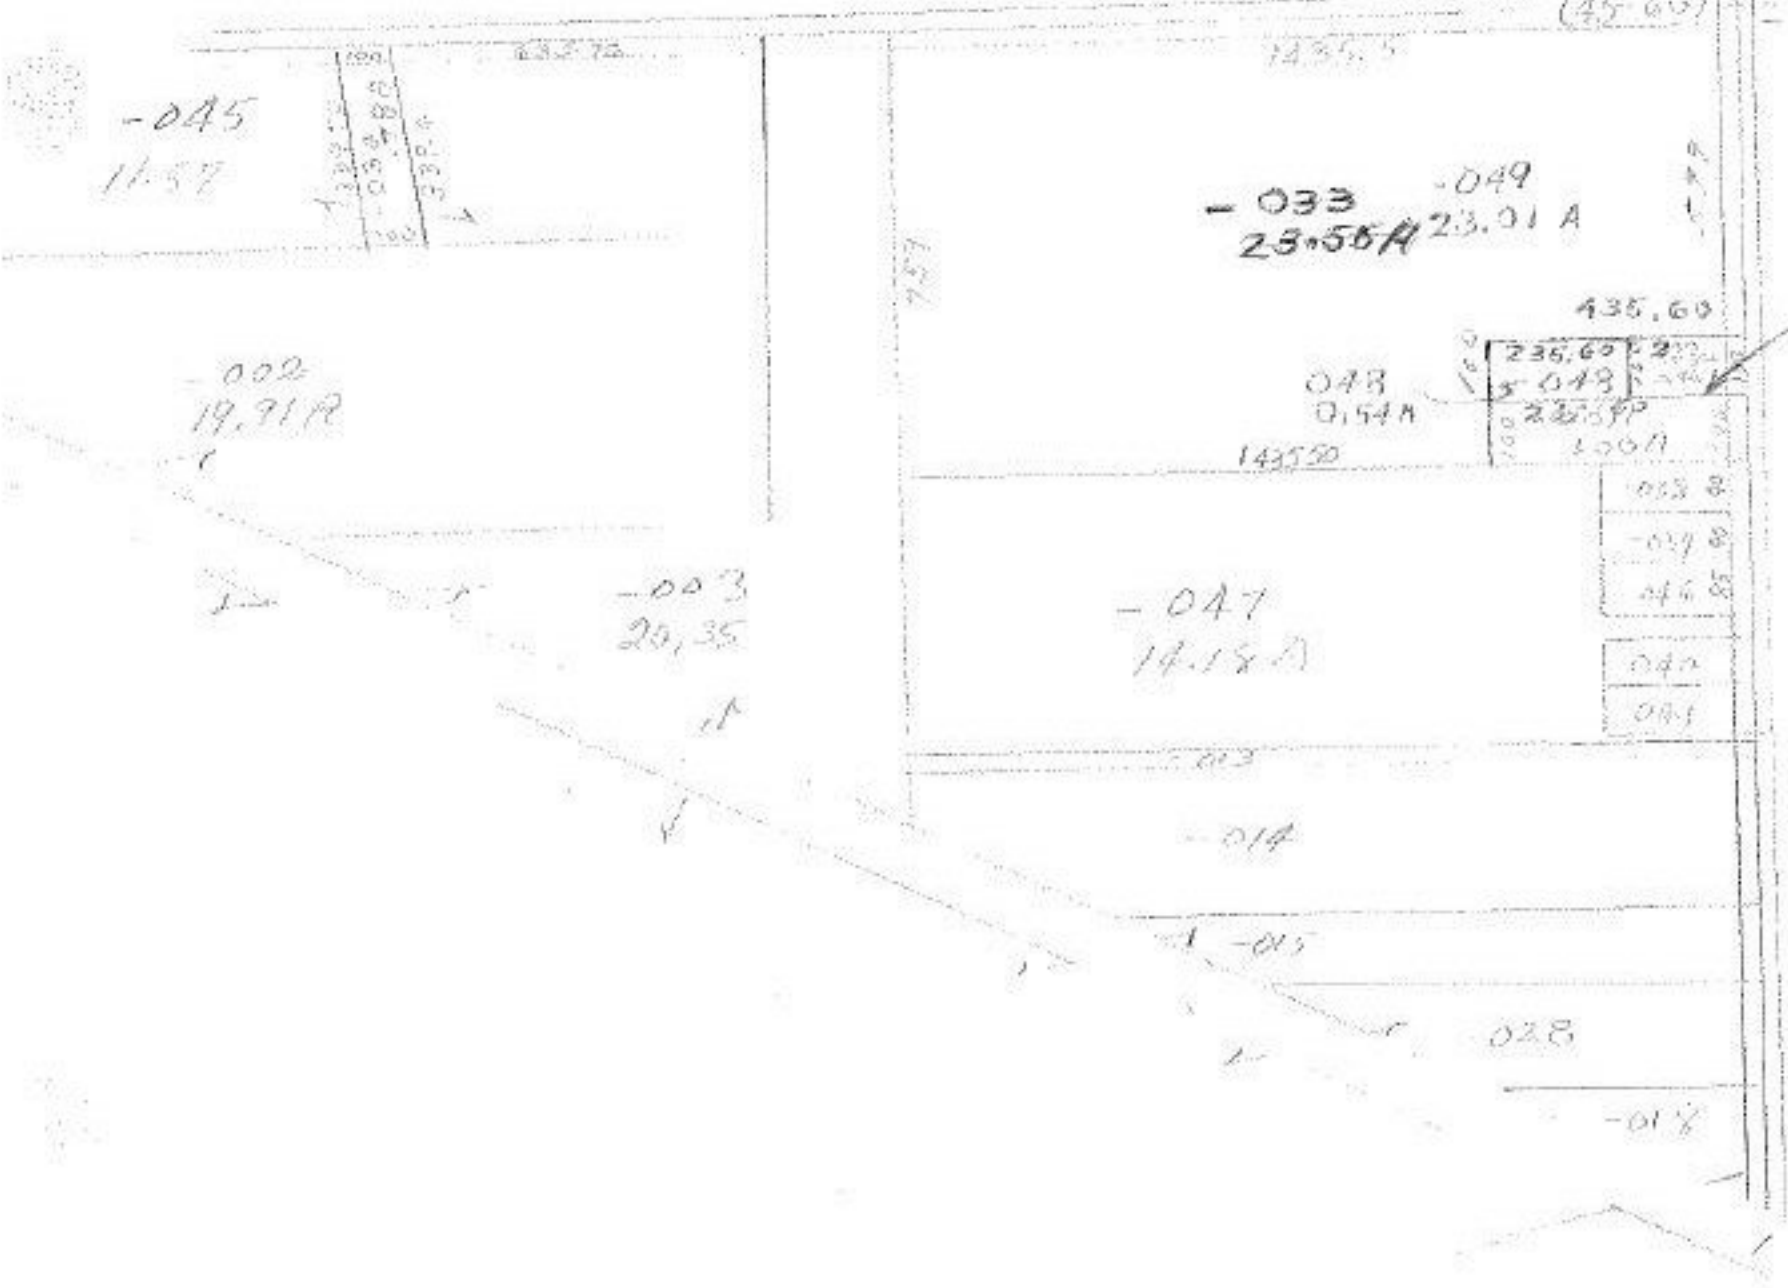

Westerly Avon Lake

#12318

APPROVED  
 LOANED  
 DATE 12-6-78  
 PAGE 1-B  
 BY Carolyn J.  
 12318  
 MR 4 25 79