


29

#12336

#12336

APPROVED
LOAN CO.
1320 DEPT.
DATE 12-14-78
NO. 4-D
BY Carolyn J
VOID AFTER 12336

MR 3/27/79

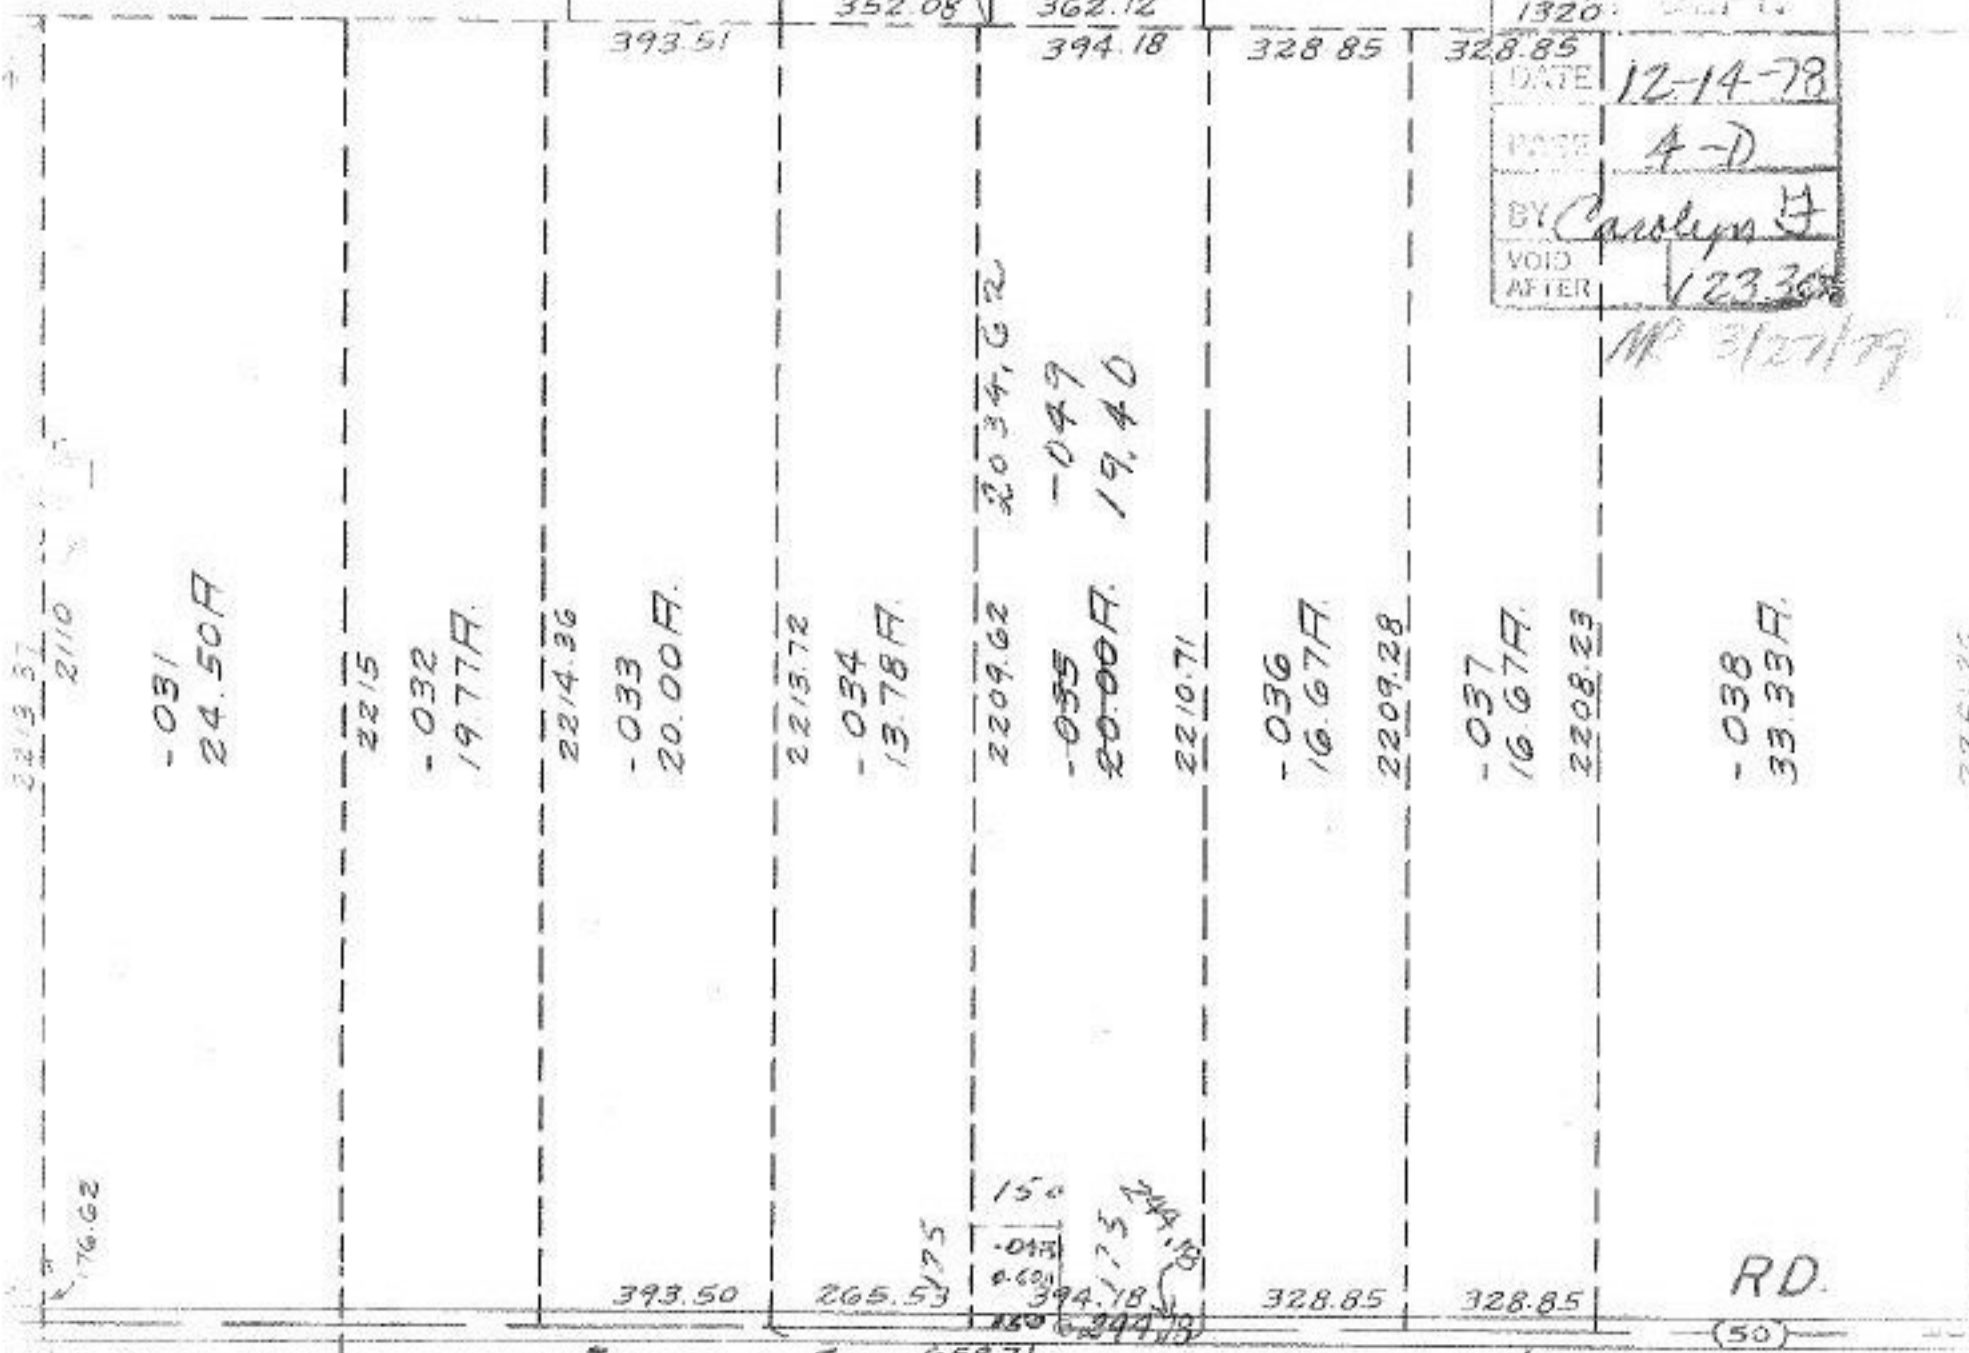

L. SEE (500) 4-H -001 7.99F. RD. R. R.

ITY

SECTION NO. 00 0 30