


PARCEL 2
FROM DEED.

T.M.
3-9-79

12345
APR 1979

12-26-78
10-00-014-14
T.M. Hair

14.76
0.22
14.54
22
19.76

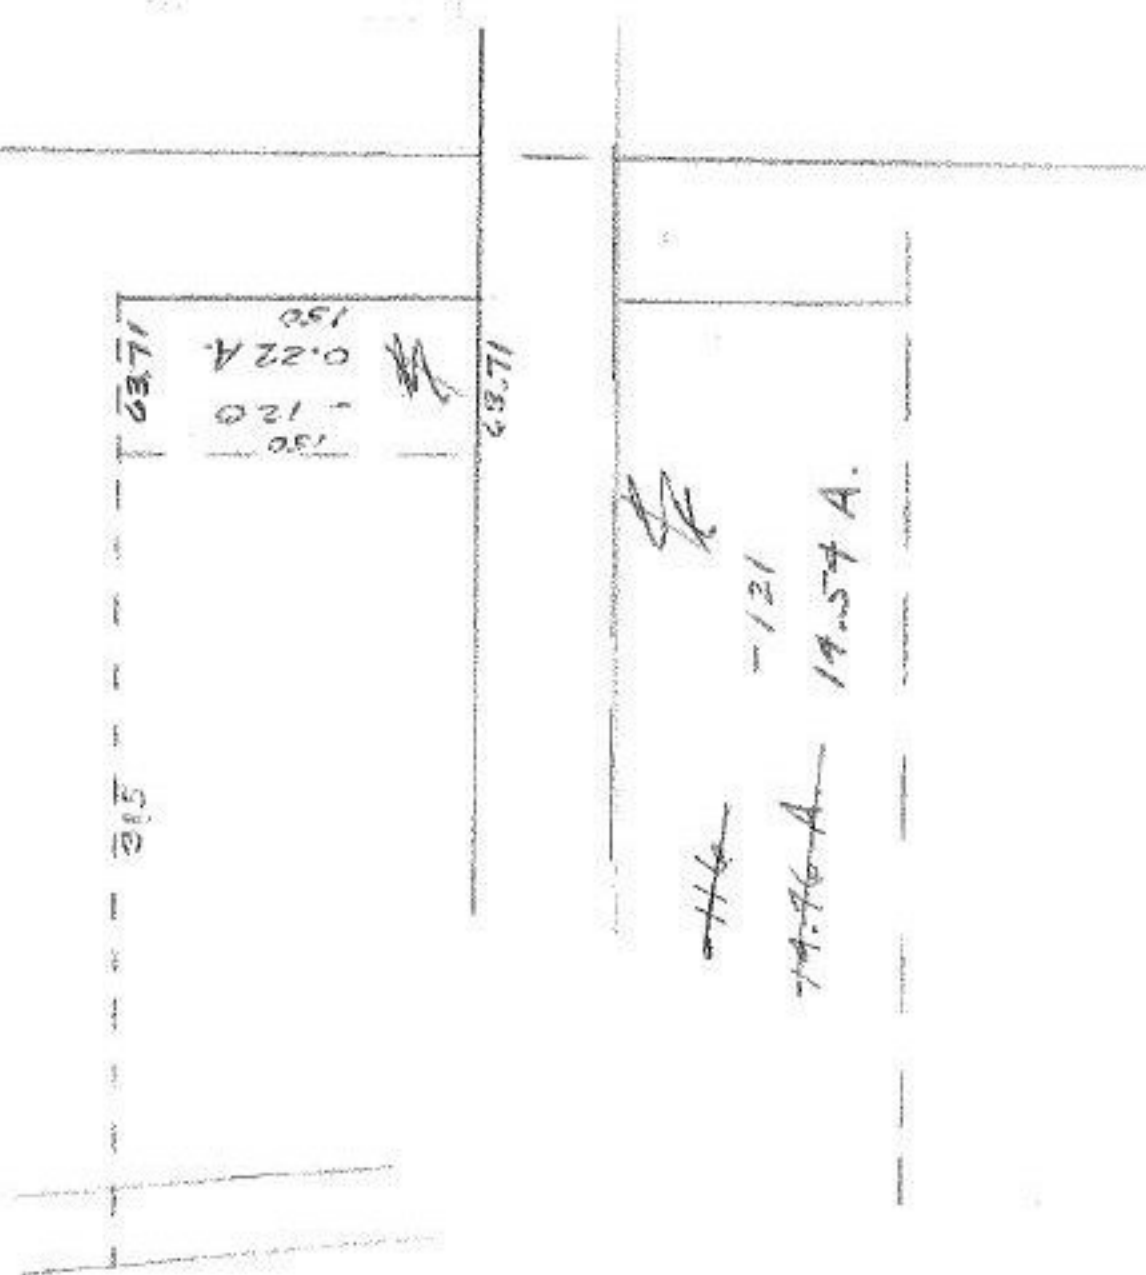

APR 1979
T.M. Hair