


#12853

R.D. 06

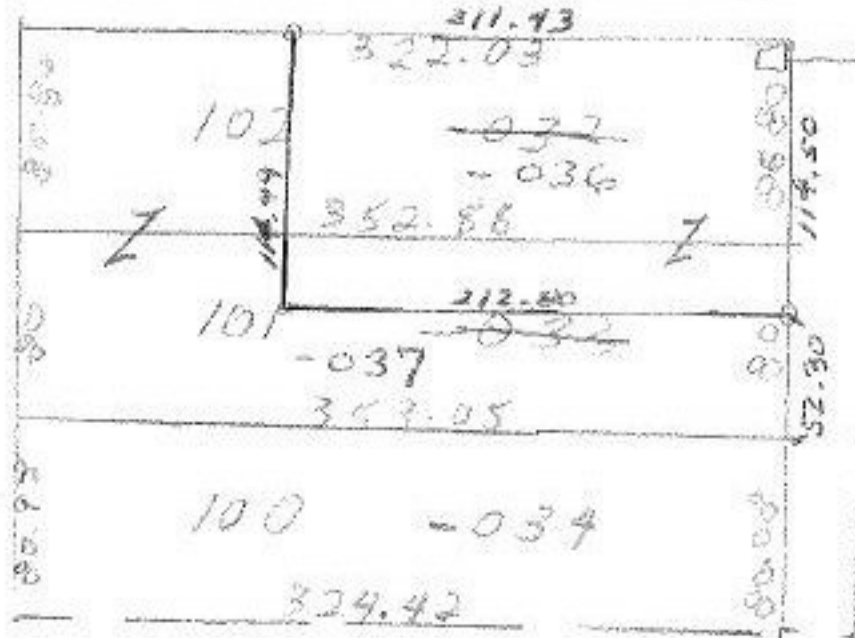

02/ Building only

#12853

APPROVED
 FOR THE
 CITY DEPT
 DATE 12-27-78
 BY H-O-09-B
 T. McLean

MAR 31 1979

[Handwritten signature]