

#12393

FILE

#12393


APPROVED	
LORAIN CO.	
MAP DEPT.	
DATE	1-23-79
PAGE	11-A 11-00-088-B
BY	T. McNeil
VOID AFTER	

MAR 22 1979



29.00
 .06

 28.94

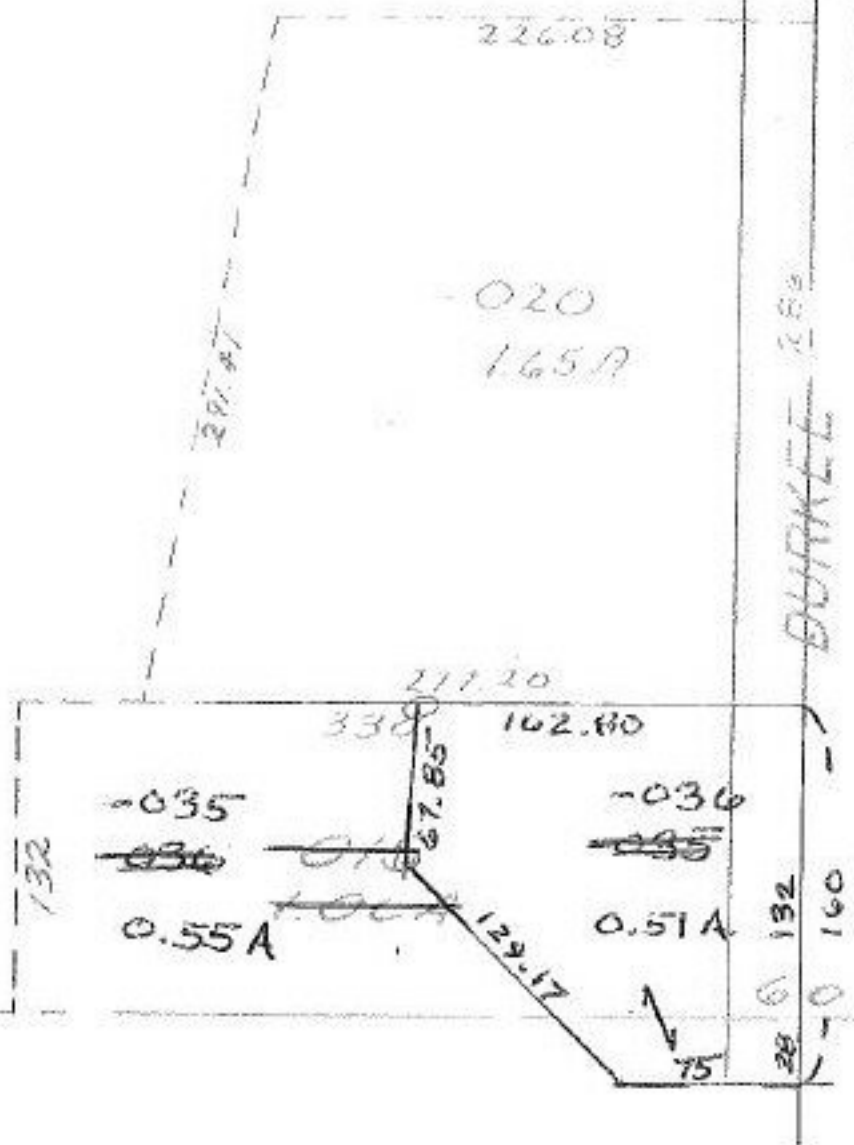

.45
 .06

 .51

1.00
 .45

 0.55