

#12393

88

SEE 11-00-00

#12393


APPROVED
LORAIN CO.
MAP DEPT.
DATE 1-23-79
PAGE 11-A 11-00-0000
BY T. McNeil
VOID
REVER

MAR 21 1979

*[Handwritten signature]*

991  
167  
731

132  
28  
160

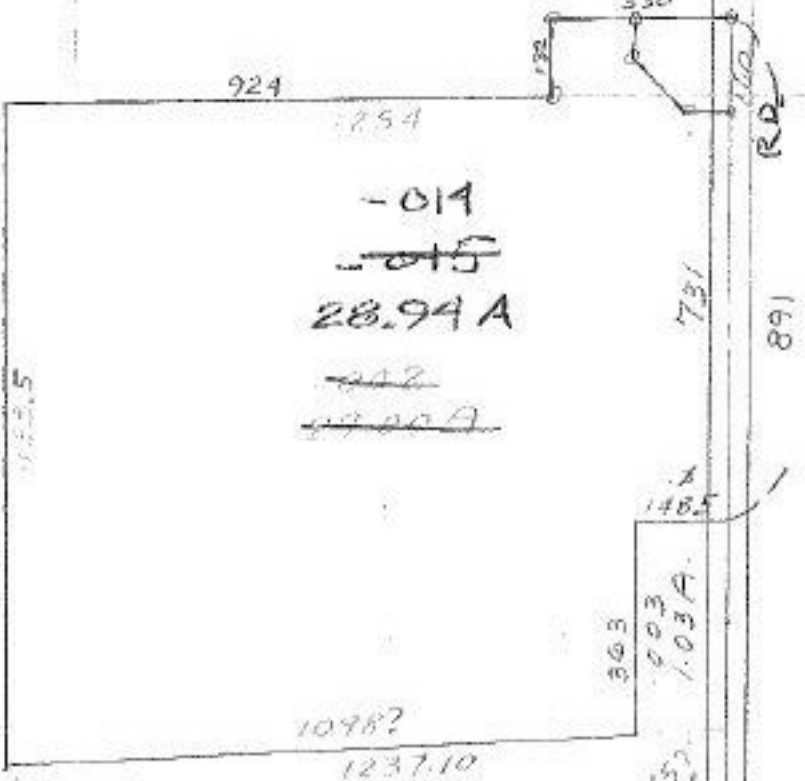

87

DURKEE

037.42  
03.45.42

001  
001.0

002  
22.81 A

003  
003.0

004  
2.91 A

005  
8.00 A

006

007  
22.55 A

006  
3.97 A

008  
25.00 A

004  
004.0  
005  
005.0  
006  
006.0  
007  
007.0  
008  
008.0

003  
1.03 A  
004  
004.0  
005  
005.0  
006  
006.0  
007  
007.0  
008  
008.0