


CHANGE → 1-00-004-B REMAINDER = -004 35.57 A.

LAKE — **6** 544.88 — CLEVELAND — SANDUSKY — **2** R. 3055.91 200 R. 2291.83 141.33

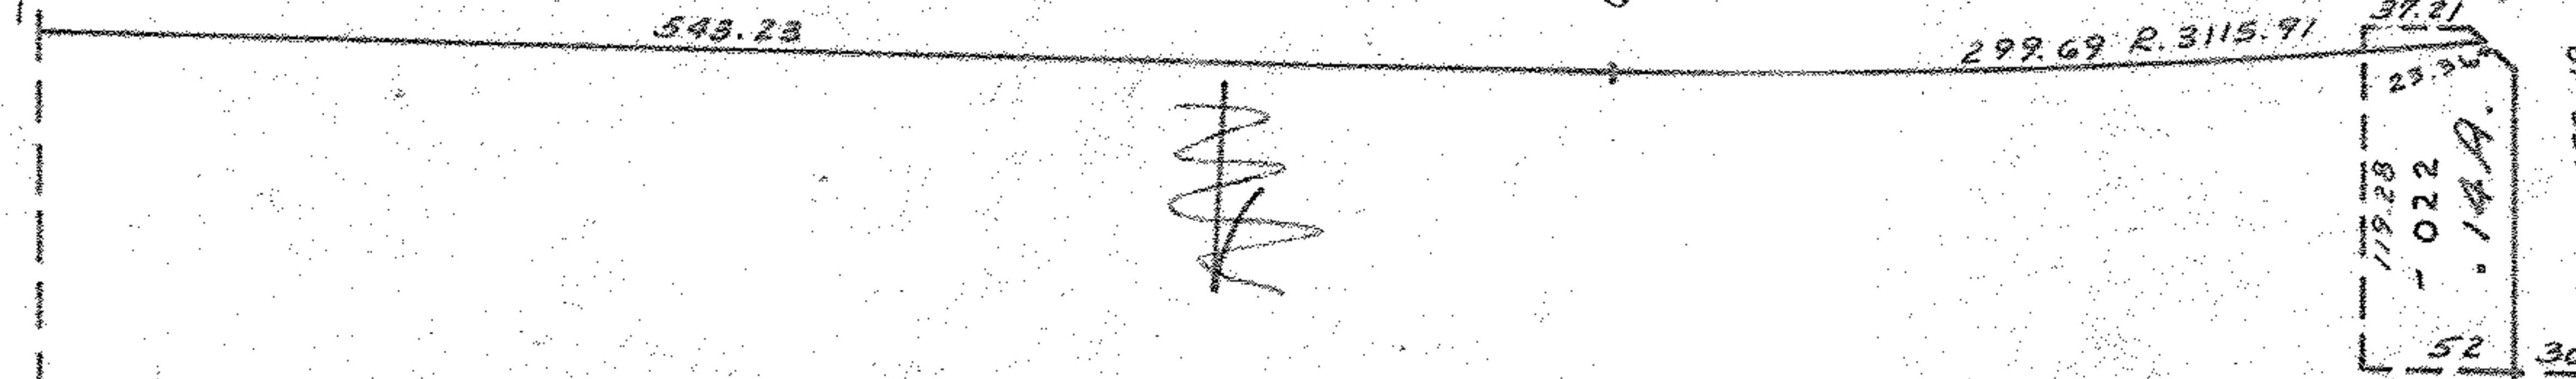

TOM CHANGE  
THIS NUMBER TO  
Block **120**

SEE  
#12580

**120** - 048  
19.58 A.

55.15  
69.58  
35.57  
19.58  
**55.15**

~~003~~  
~~19.58 A.~~

Pt. 01-00-004-115-001

Pt. ~~55-15A.~~  
12405


#12580  
#12405

APPROVED  
LORAIN CO.  
MAP DEPT.  
4-9-79

DATE 1-24-79

PAGE 1-00-004-B<sup>4</sup>D

BY T. McDan  
VOID  
METER 1/10/79

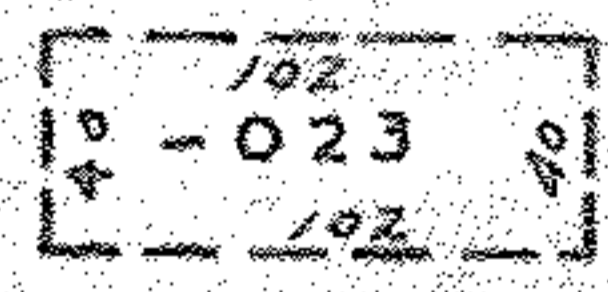

RD.

**997.63**

993.69 TO SOUTH LOT LINE OF 0.2.9

#12405  
C-500-00-1

