


#12409

#12409

1-24-79  
5-00-018-A+B  
T. McNeil

OK  
6-13-79

22.97
22.45
52
22.97

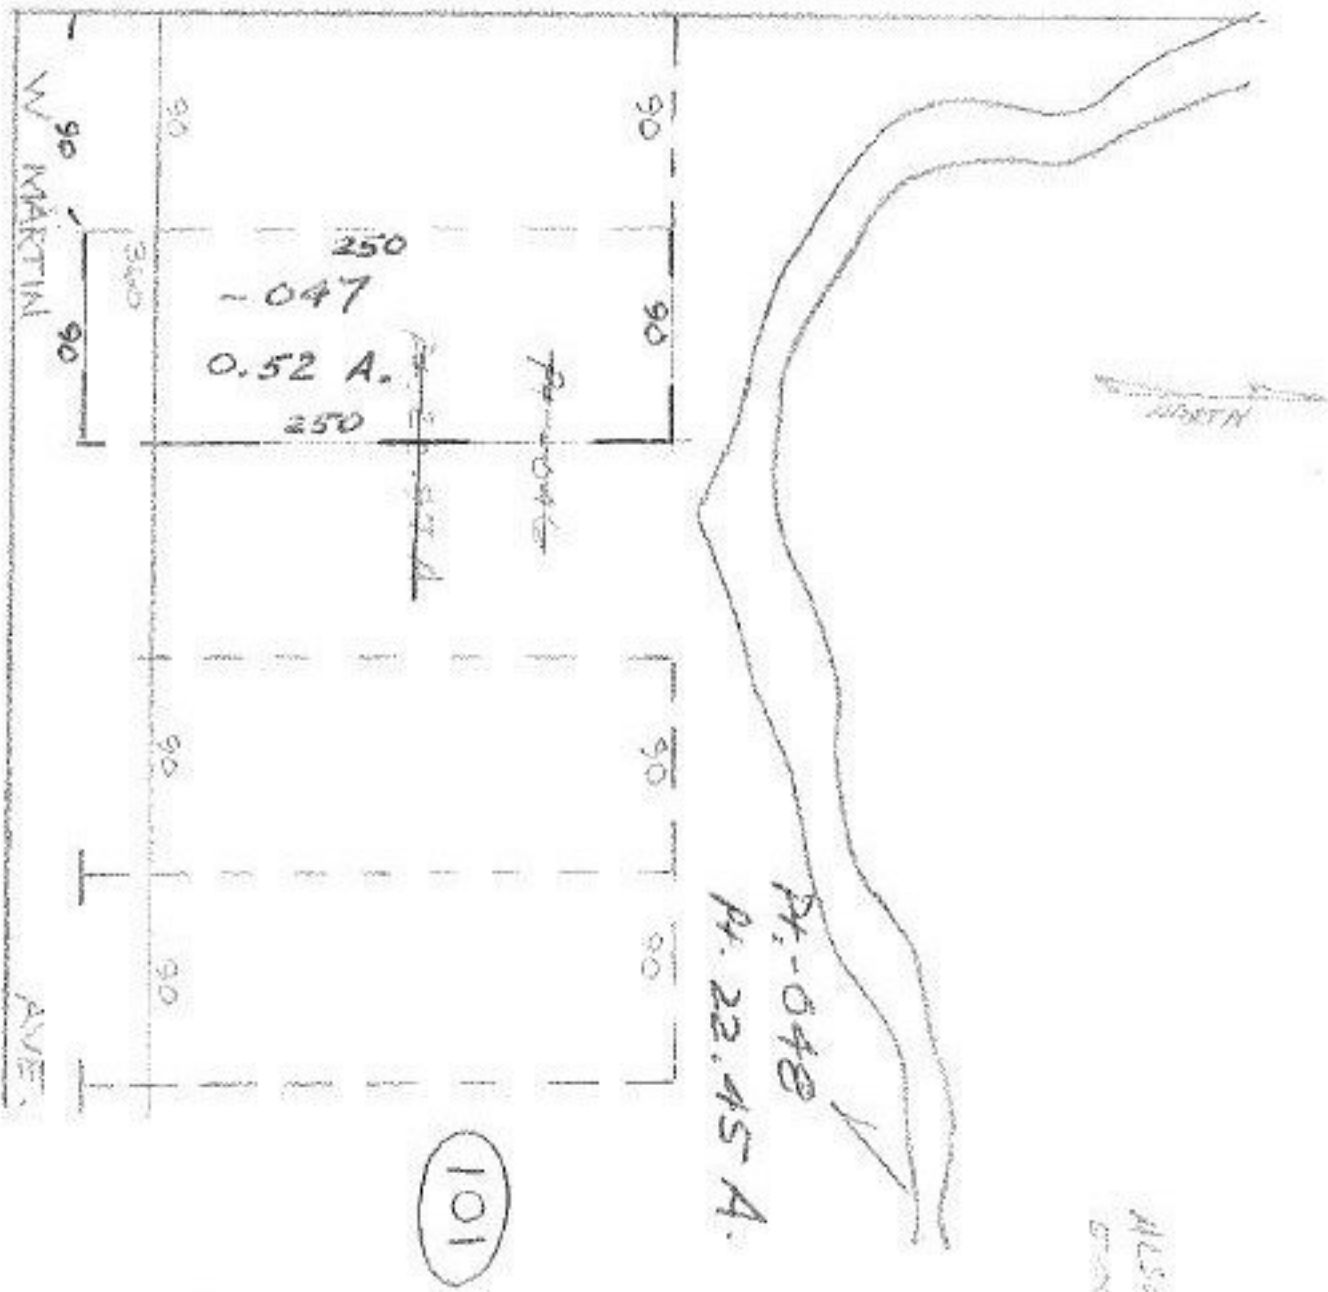

ALSO PG  
5-00-018-B