


#1241

27.52

#12307

SEE SAIT #12326

1021.75

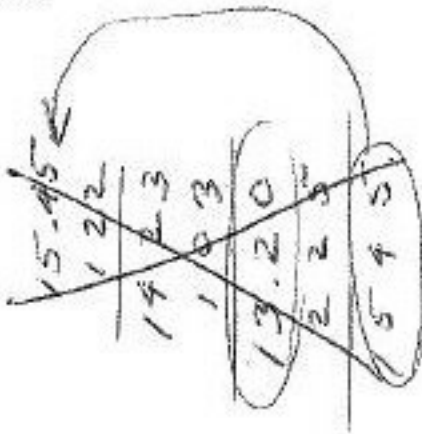

5.12
 1.22
 3.90
 -1.03
 2.87

MAR 19 1979

502.60
 129.60
 373.160
 115.60
 115.60
 58.58

502.60
 258
 4.60

~~0.26~~
~~15.45~~

~~19.20 A~~
~~0.92~~
~~5.12~~

REMAINDER -0.35

2-87 A #1241

APPROVED
LORAIN CO.
MAP DEPT.
DATE 1-25-79
PAGE 12-00-038-B
BY T. McNamee
VOID AFTER

908.10

357.70

-024
1.03 A

357.70

-025
1.03 A

357.70
357.70

-033
1-22 A

357.70

-031
1.03

357.70

-034
1.03 A

343.77

VILLAGE

BAY

CREEK

MALLET

252

4.35

284.20

4030

10
2A