


100

Pt. 10.96A  
Pt. 09-00-087-500-001  
314.4

-002  
2.00F.

251.66

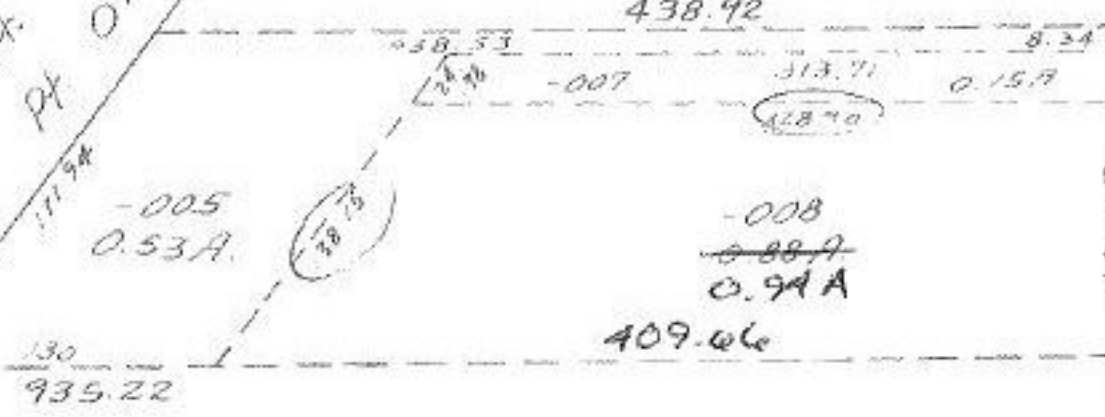

102

#12413

APPROVED LORAIN CO. MAP DEPT.	
DATE 1-24-79	
PAGE 9-00-077-13	
BY <i>H.P. Callist</i>	
VOID AFTER	MR 4-23-79

-004  
12.66F.

695.51

CROSBY

ST. 50