
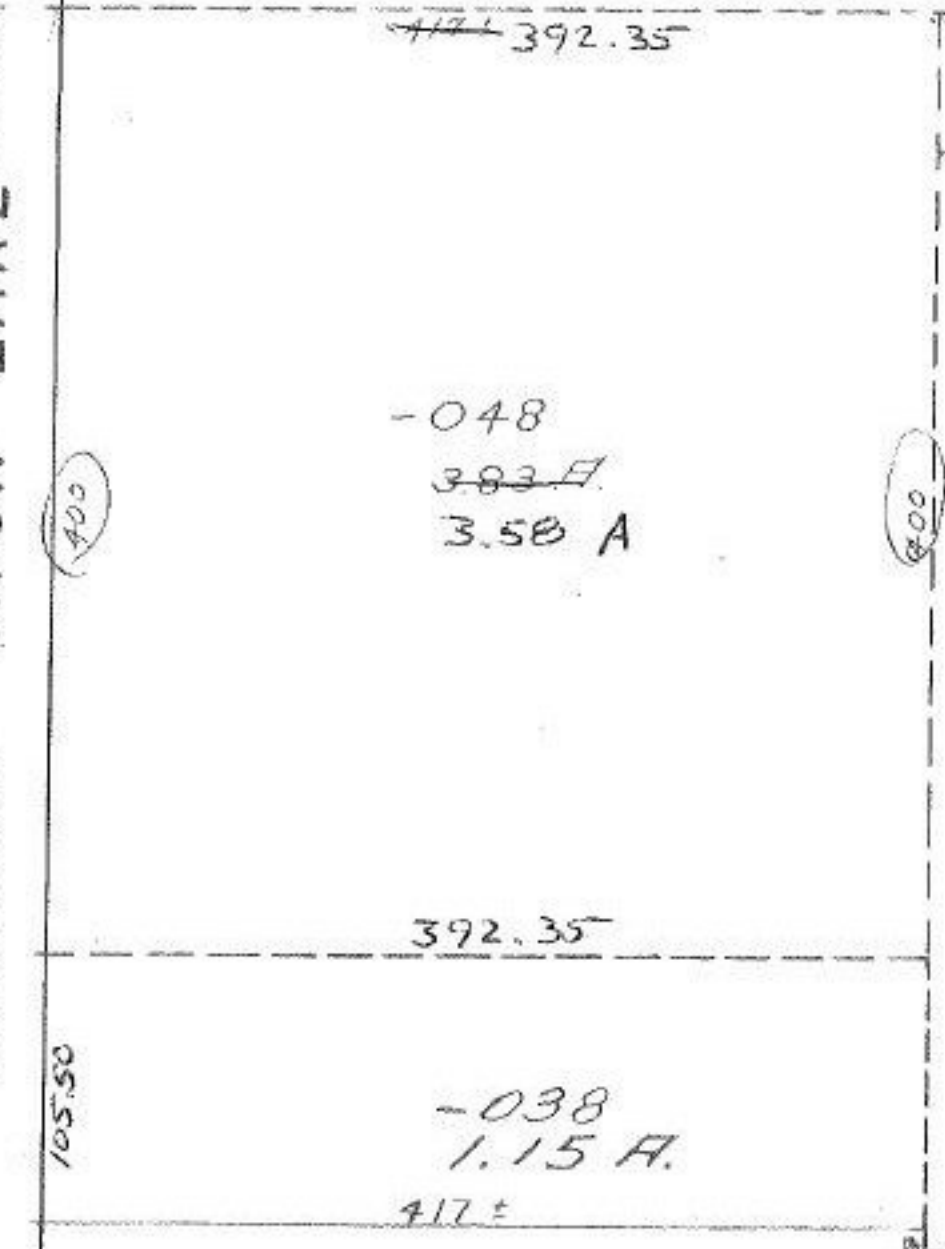


#12413

SEE 7-

WOOSTER AVON LAKE

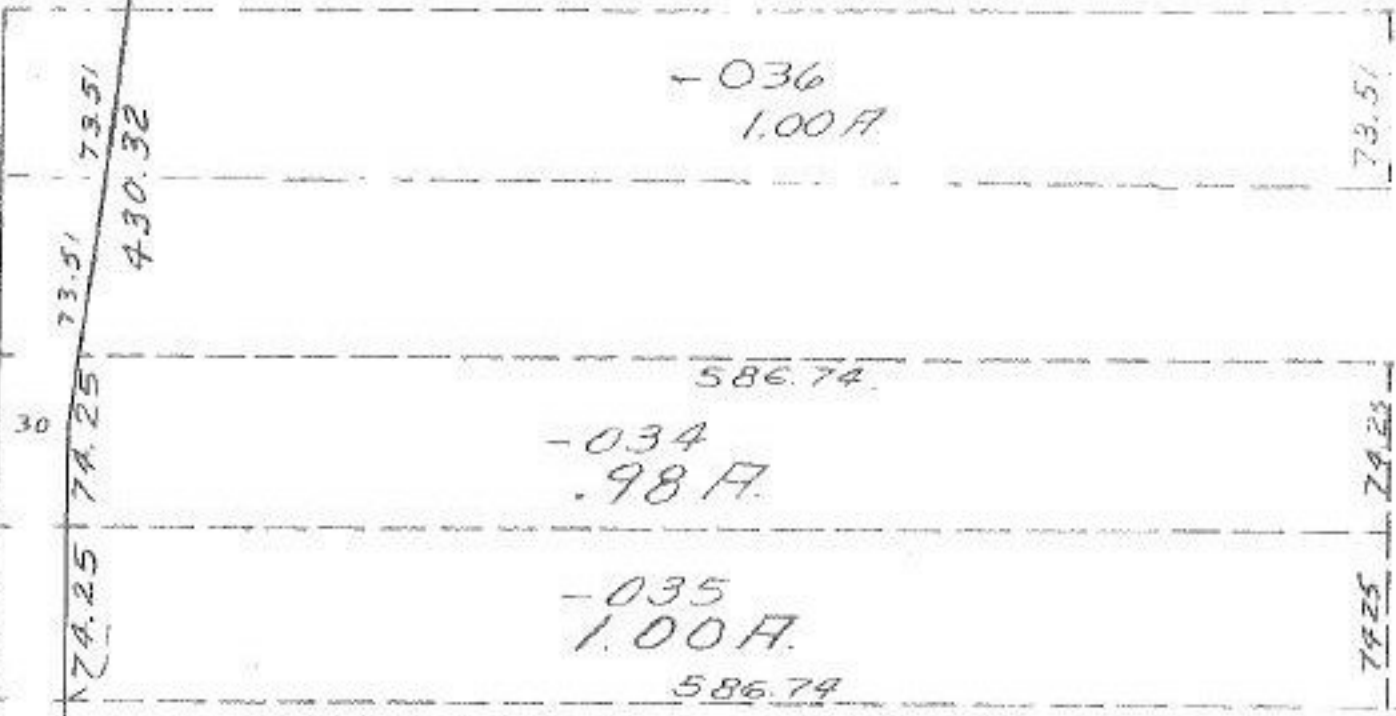

#12413
 APPROVED
 LORAIN CO.
 MAP DEPT.
 DATE 1-24-79
 PAGE 7-00-022-e
 BY J.P. Colburn
 VOID AFTER

5-2-79
T.M.

N. Y. 120 E.

83

SEE