

#12420


102

#12420

2-9-79
4-00-028-E
T. McRau
1-13-79

THIS MAP CORRECTS ACREAGE ON
-082 PER SURVEY & SPLITS
OUT -084 LEAVING -085 AS
A REMAINDER.

ACREAGE PER SURVEY
VINCENT B. McGRIVER
2-9-79

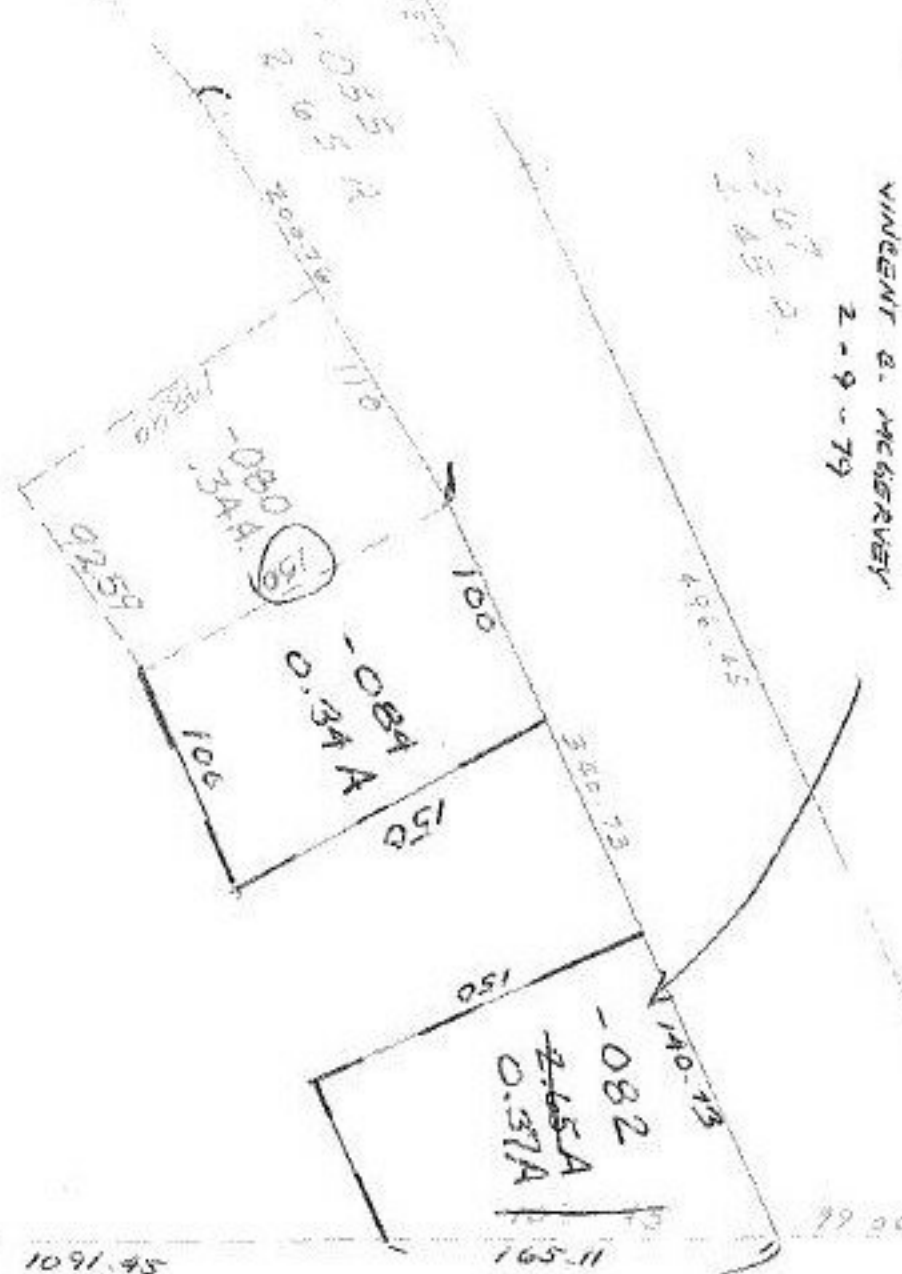

~~0.01~~
~~0.03~~
~~8.03~~
 -085
 7.69 A.

8.40
 0.37
 8.03

4-00-027-A

59825

1091.45

11.591

99.26