


12429

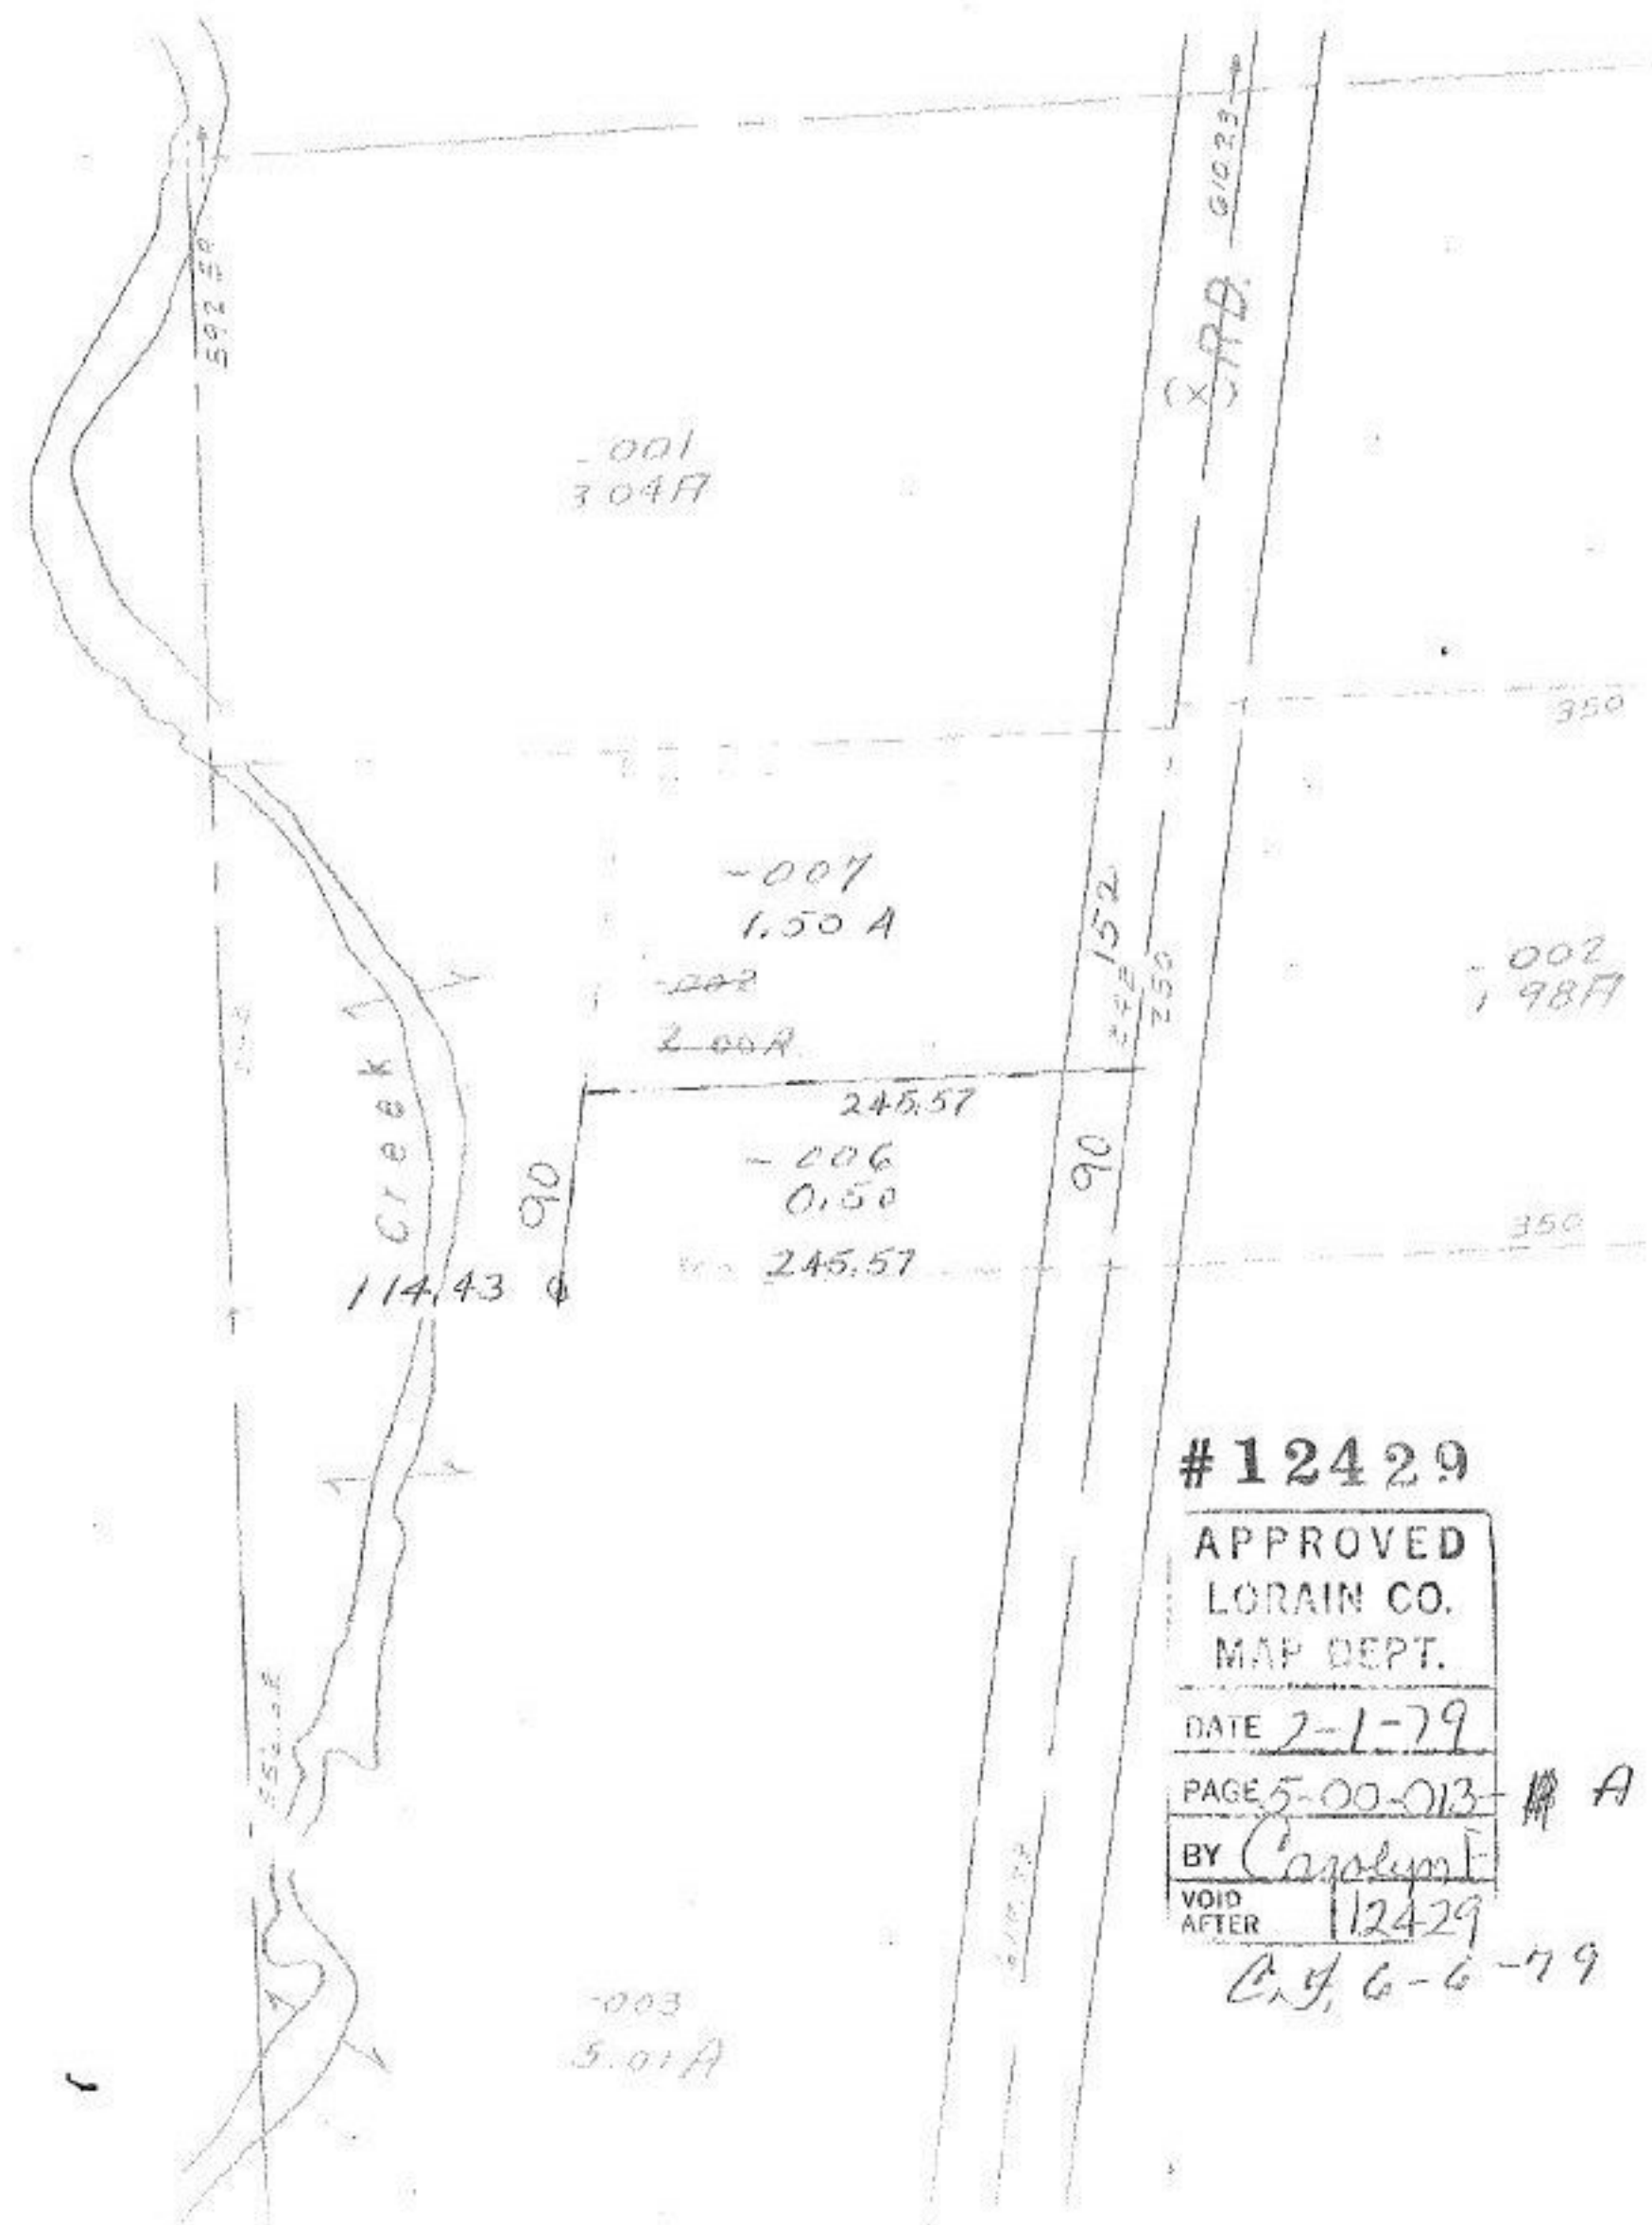

#12429

| |
|------------------|
| APPROVED |
| LORAIN CO. |
| MAP DEPT. |
| DATE 2-1-79 |
| PAGE 5-00-013 |
| BY Carolyn F. |
| VOID AFTER 12429 |

C.Y. 6-6-79

A