

12447

SEE 10-00-0000-F

12447

2-9-79

PAGE 10-00-013-B


Carolyn F
12447

NOV 4 20 1979

R. 202.18
R. 112.08
R. 81.68
R. 275.18
R. 189.18

-159
131A

~~-160~~
~~-9.54A~~
~~-9.04A~~
~~-166~~

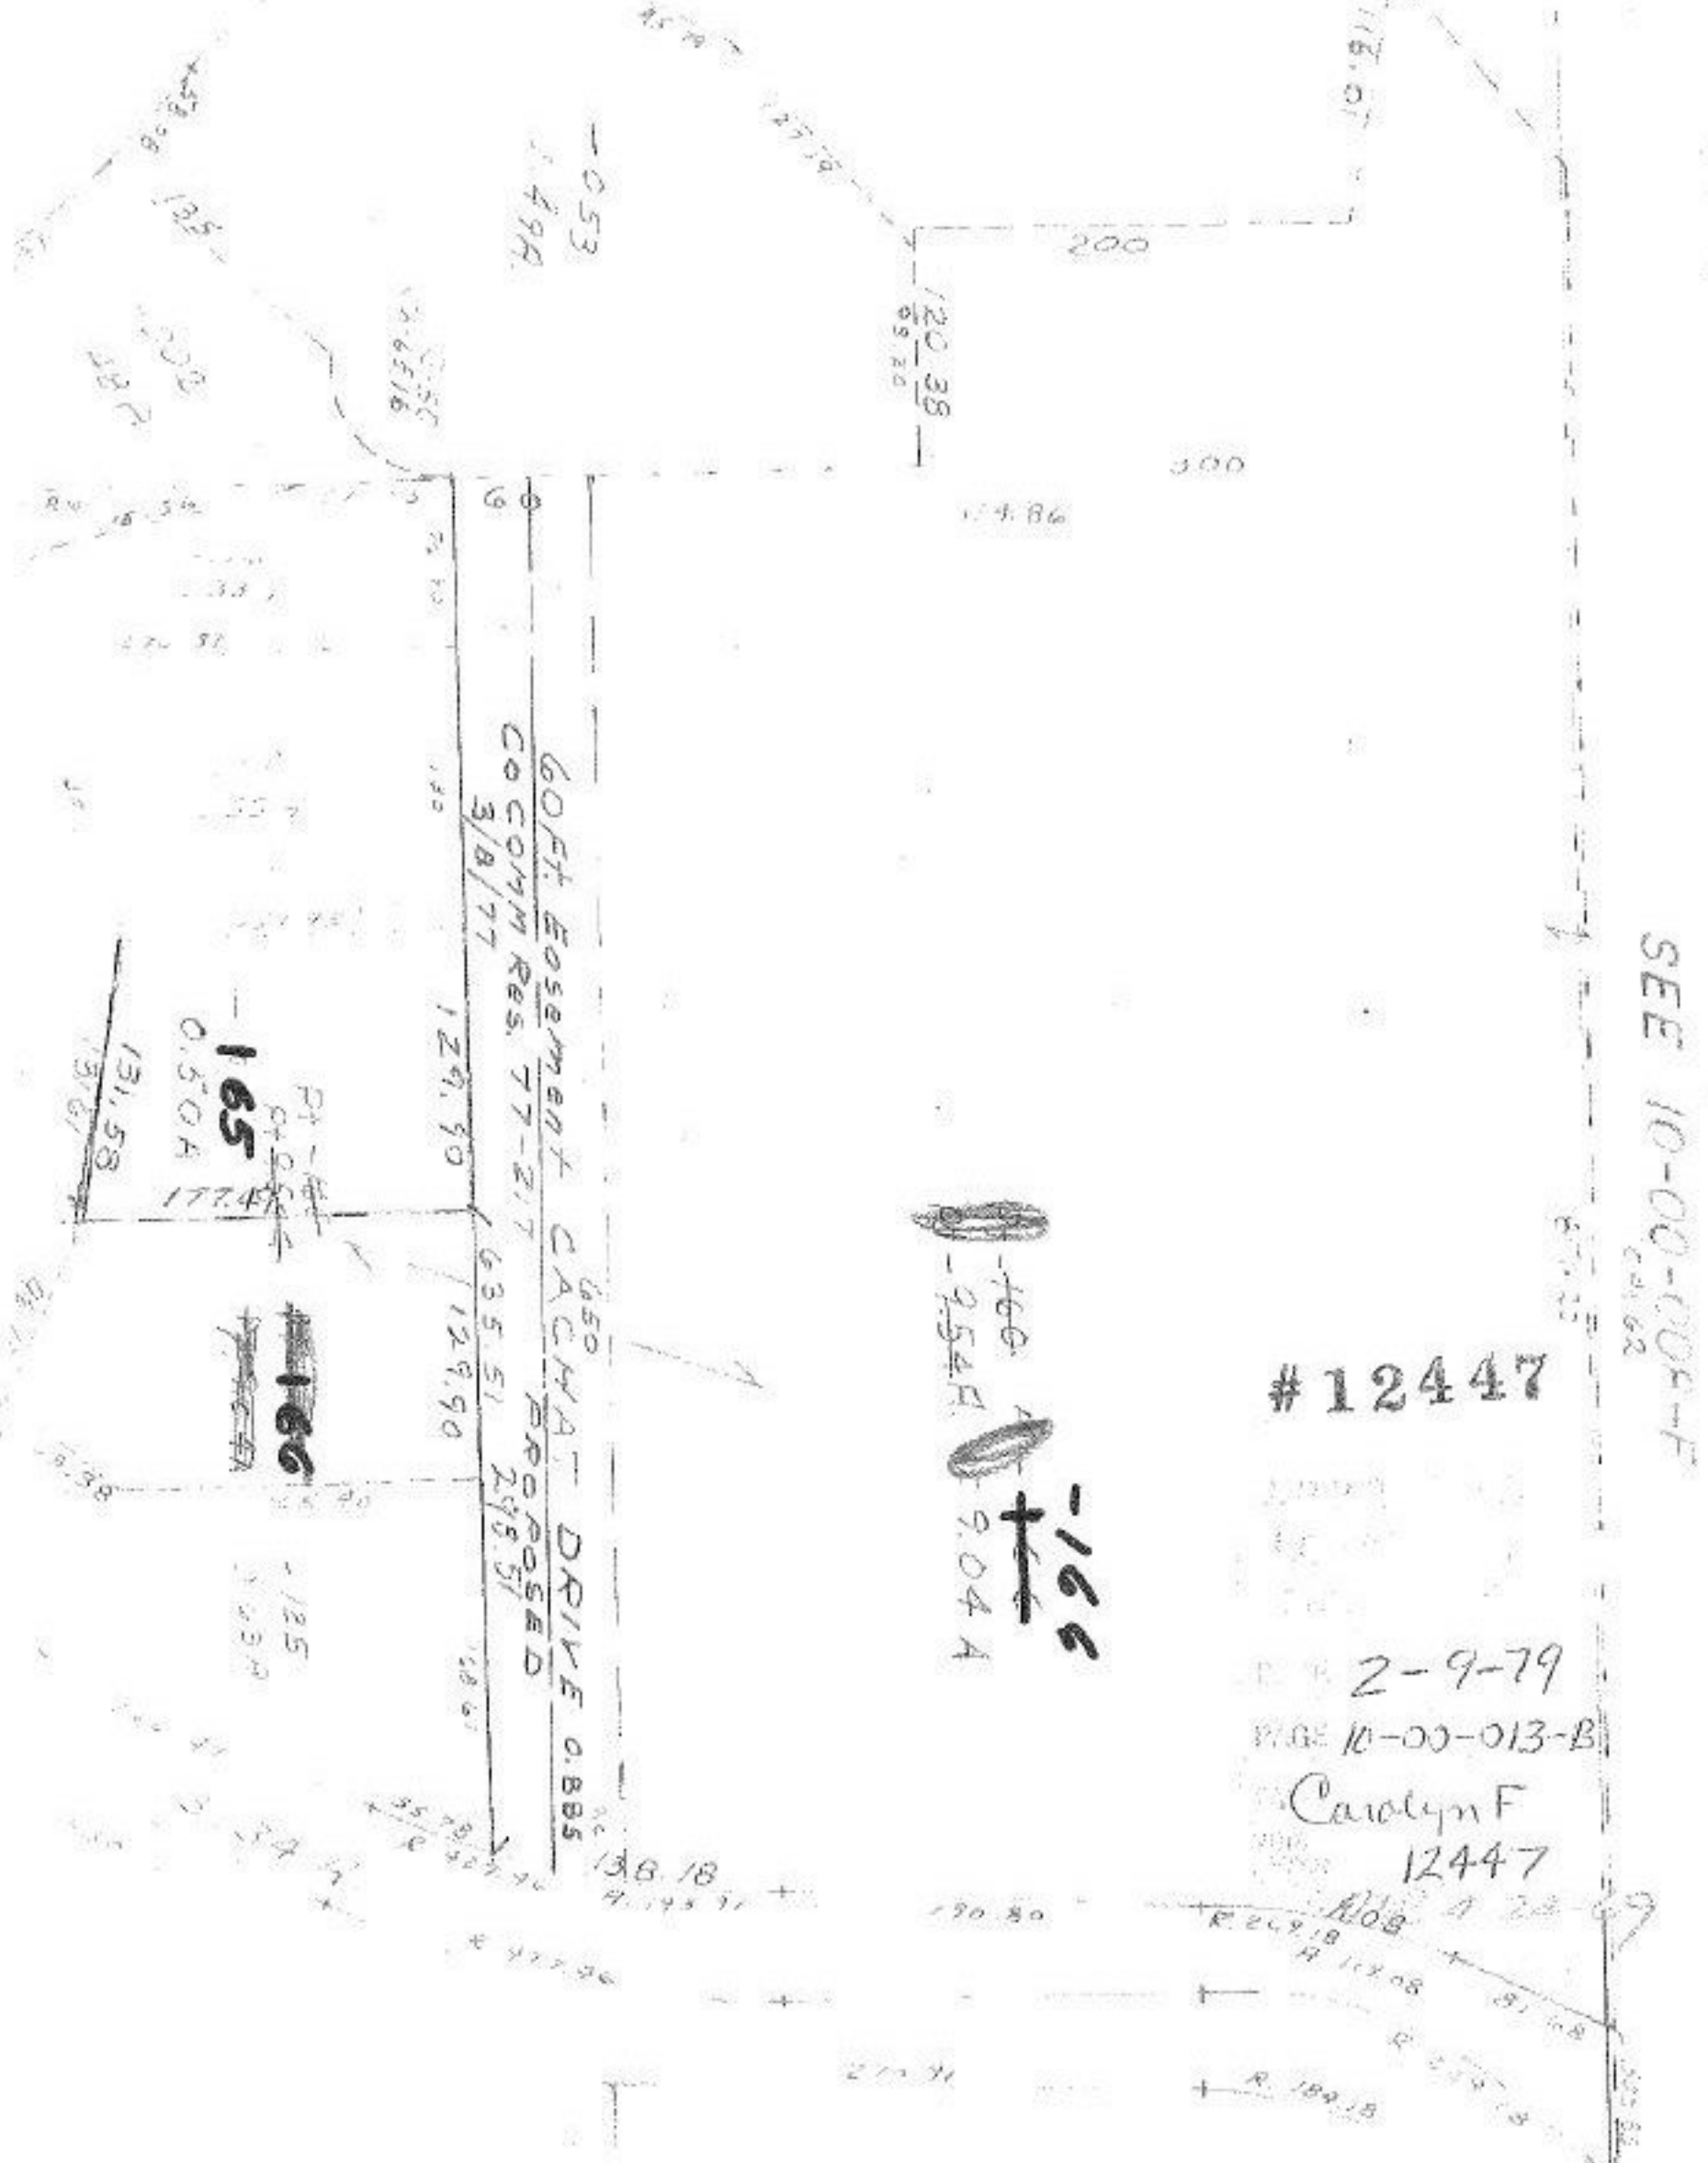

-053
149A

-165
0.5704

~~-166~~

-125

60 FT EASEMENT
CACHAT DRIVE 0.885
PROPOSED
3/8/77
129.90
635.51
298.51

131.58
137.67
177.47

120.35
69.20

300

174.86

136.18
4.25.77

170.80

272.71

107.20