


#12451

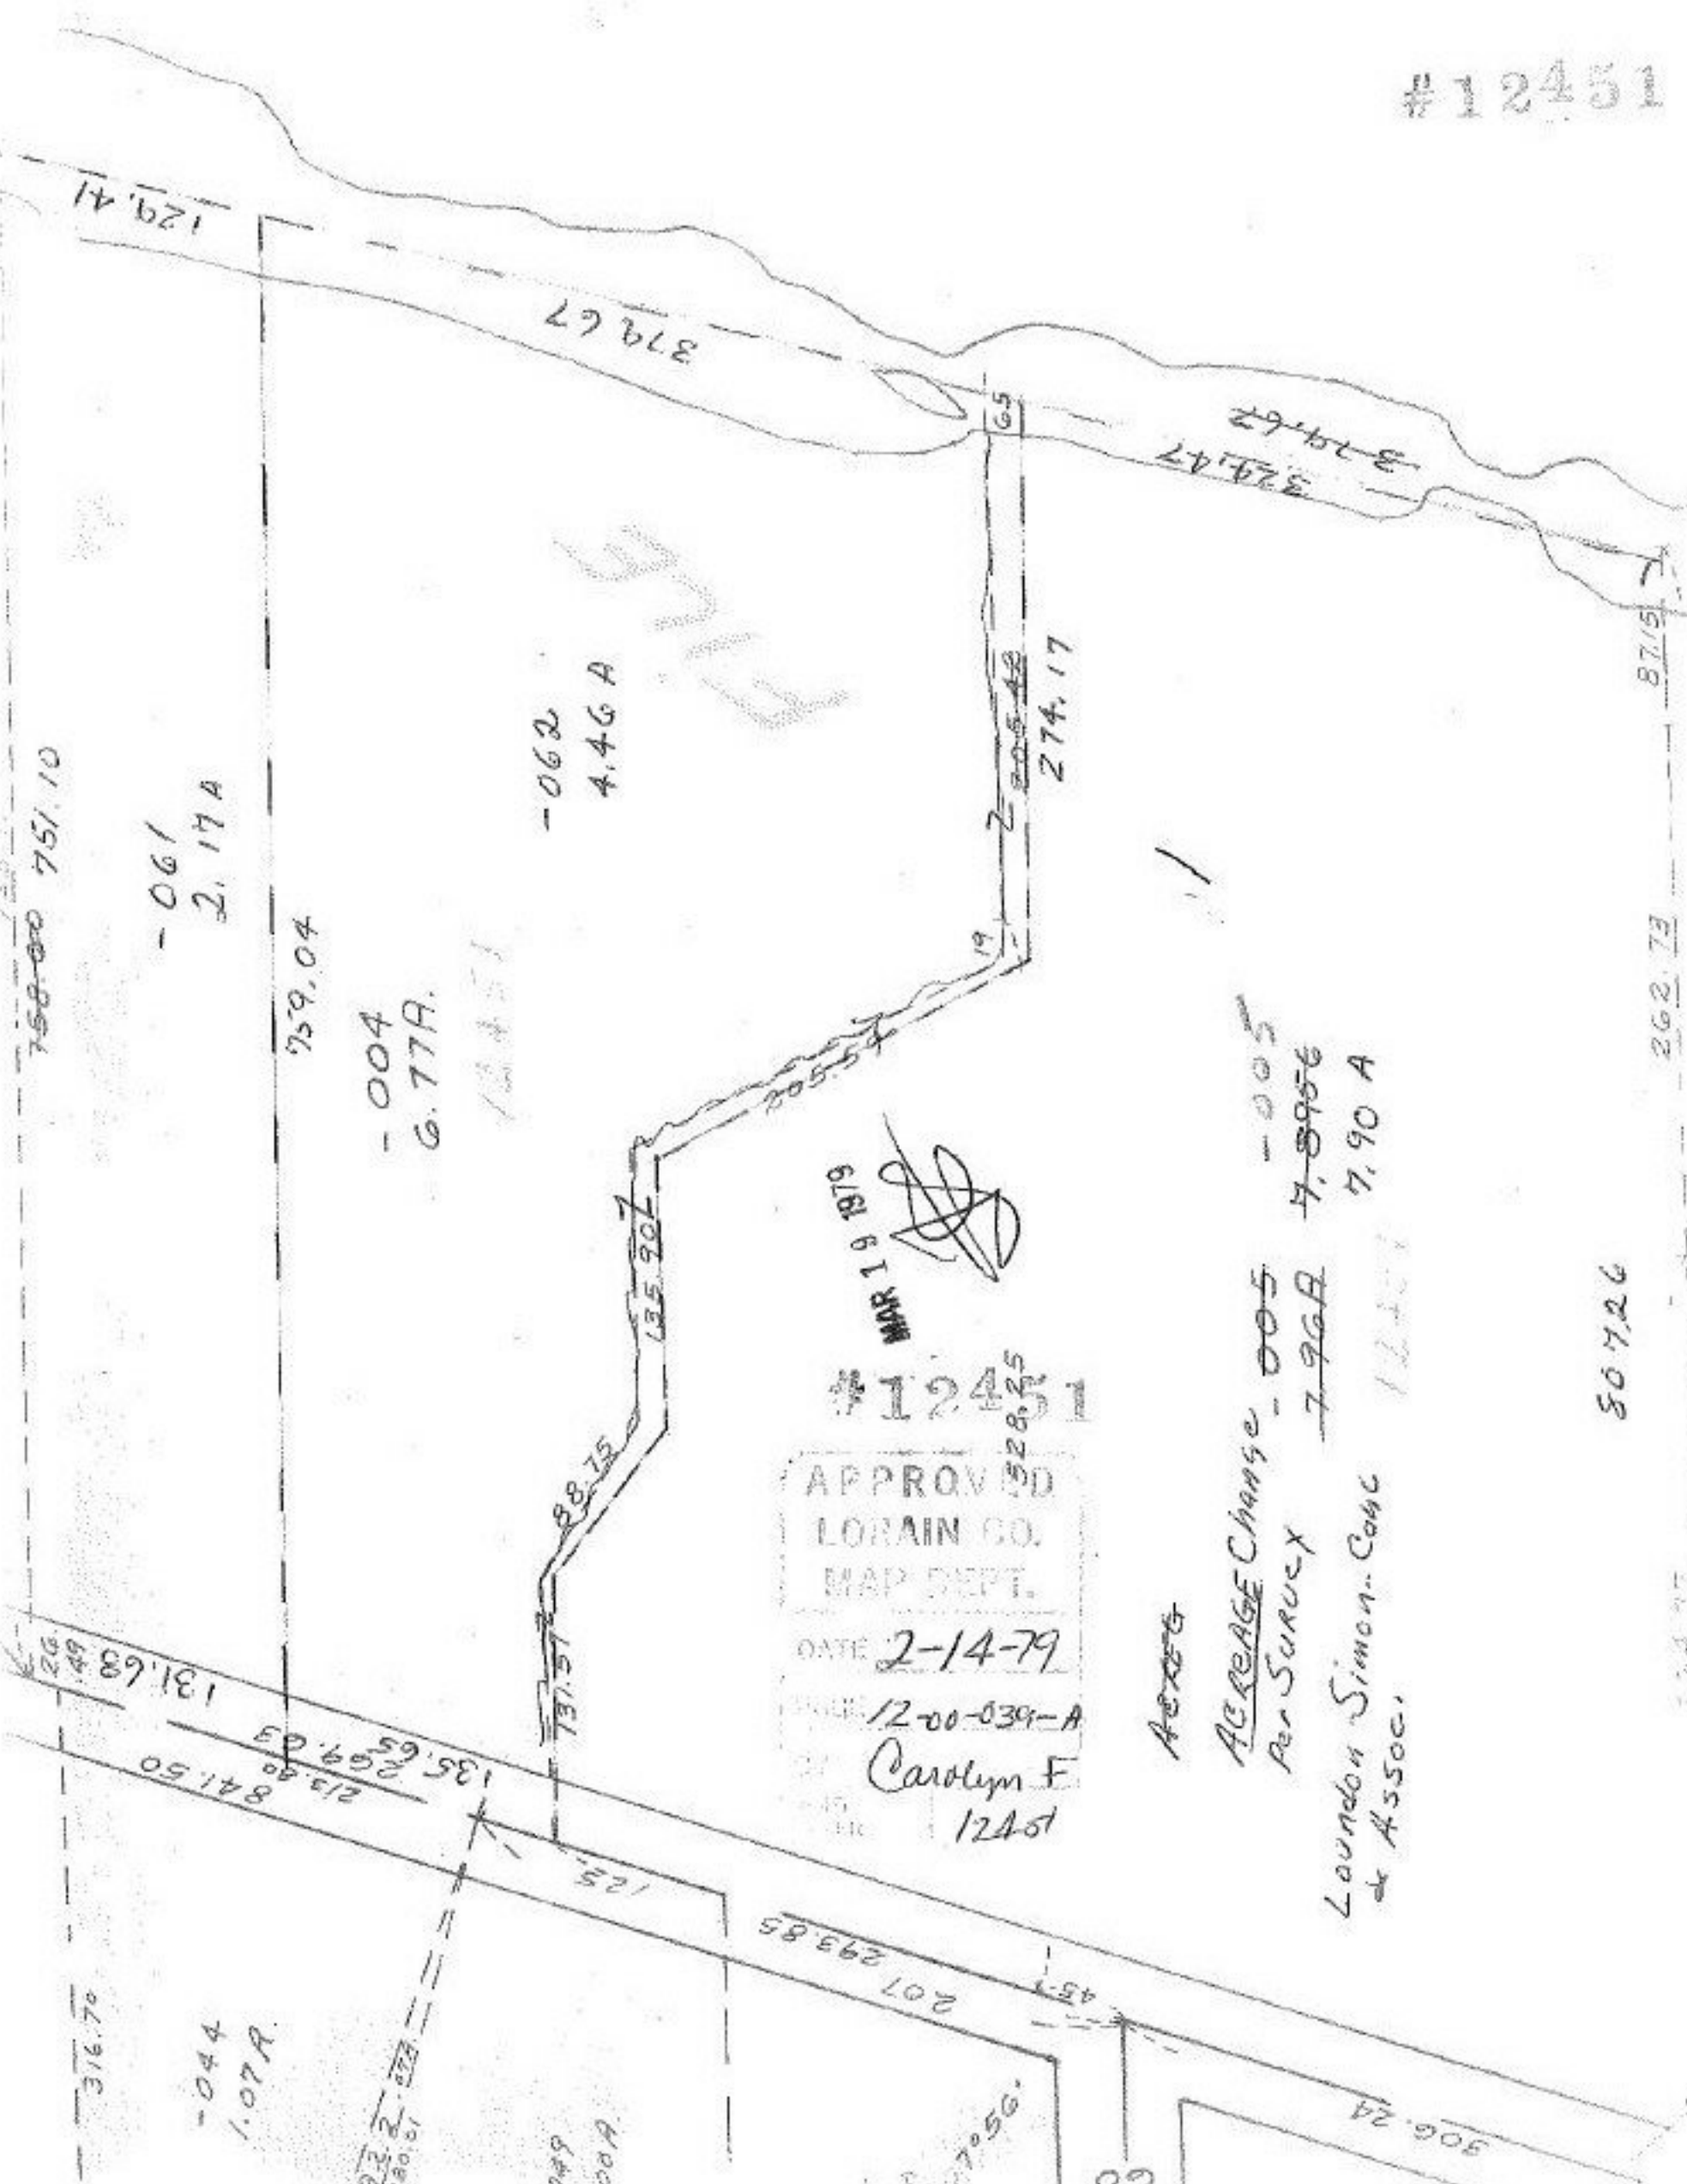

MAR 19 1979

#12451

APPROVED  
LORAIN CO.  
MAP DEPT.

DATE 2-14-79

FILE 12-00-039-A

CAROLYN F  
12451

ACREAGE

ACREAGE CHANGE - 005  
Per SURVEY 7.96A 7.8956  
Landon Simon - Cong  
& Assoc. 12451 7.90 A

807.26