


12455

303

WAKEMAN - LAGRANGE - RICHFIELD

89.039

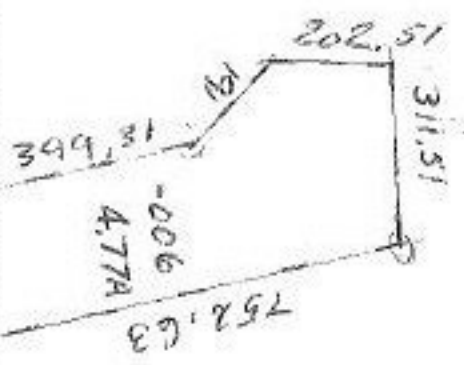

25972 1482.62

~~005~~ -007 71.22A

-001
81.00A.

-006
49.00A.

#12455

APPROVED
 LOCAL NO.
 DATE 2-15-79
 PAGE 16-A
 BY Carolyn F
 VOID AFTER 12455

MAR 12 1979

-004 5.01A CHAMBERLAIN

42

-002
40.00A



-025
22.48

13299