


12457

MEDINA - NORWALK

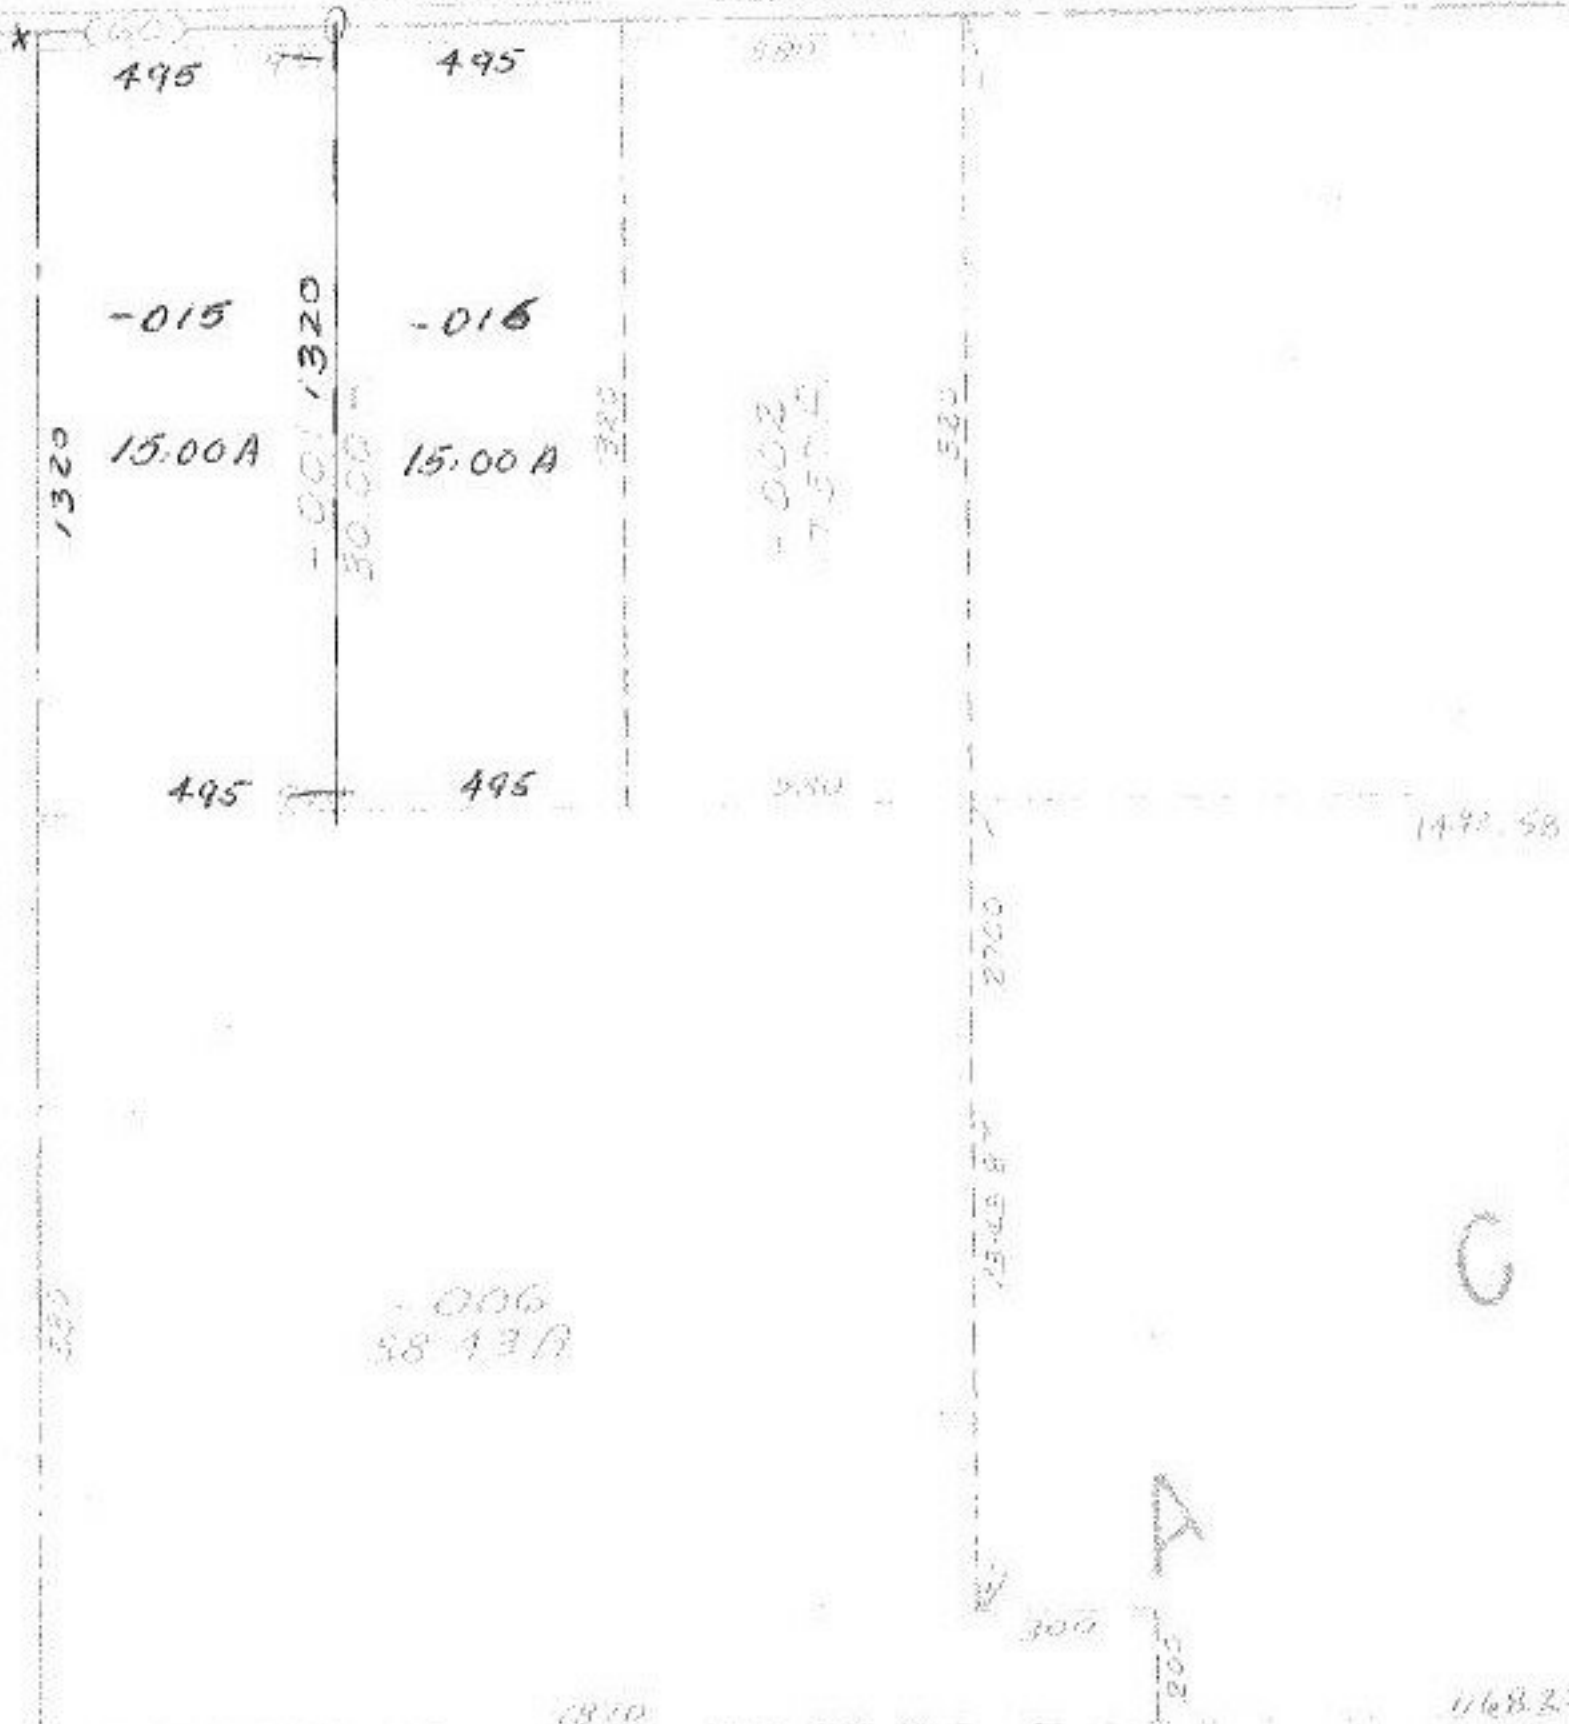

12457

RECORDED
 INDEXED
 MAR 2 1979
 FILE 2-15-79
 PAGE 19-F
 BY Carolyn F
 12457

APR 4-24-79