


12468

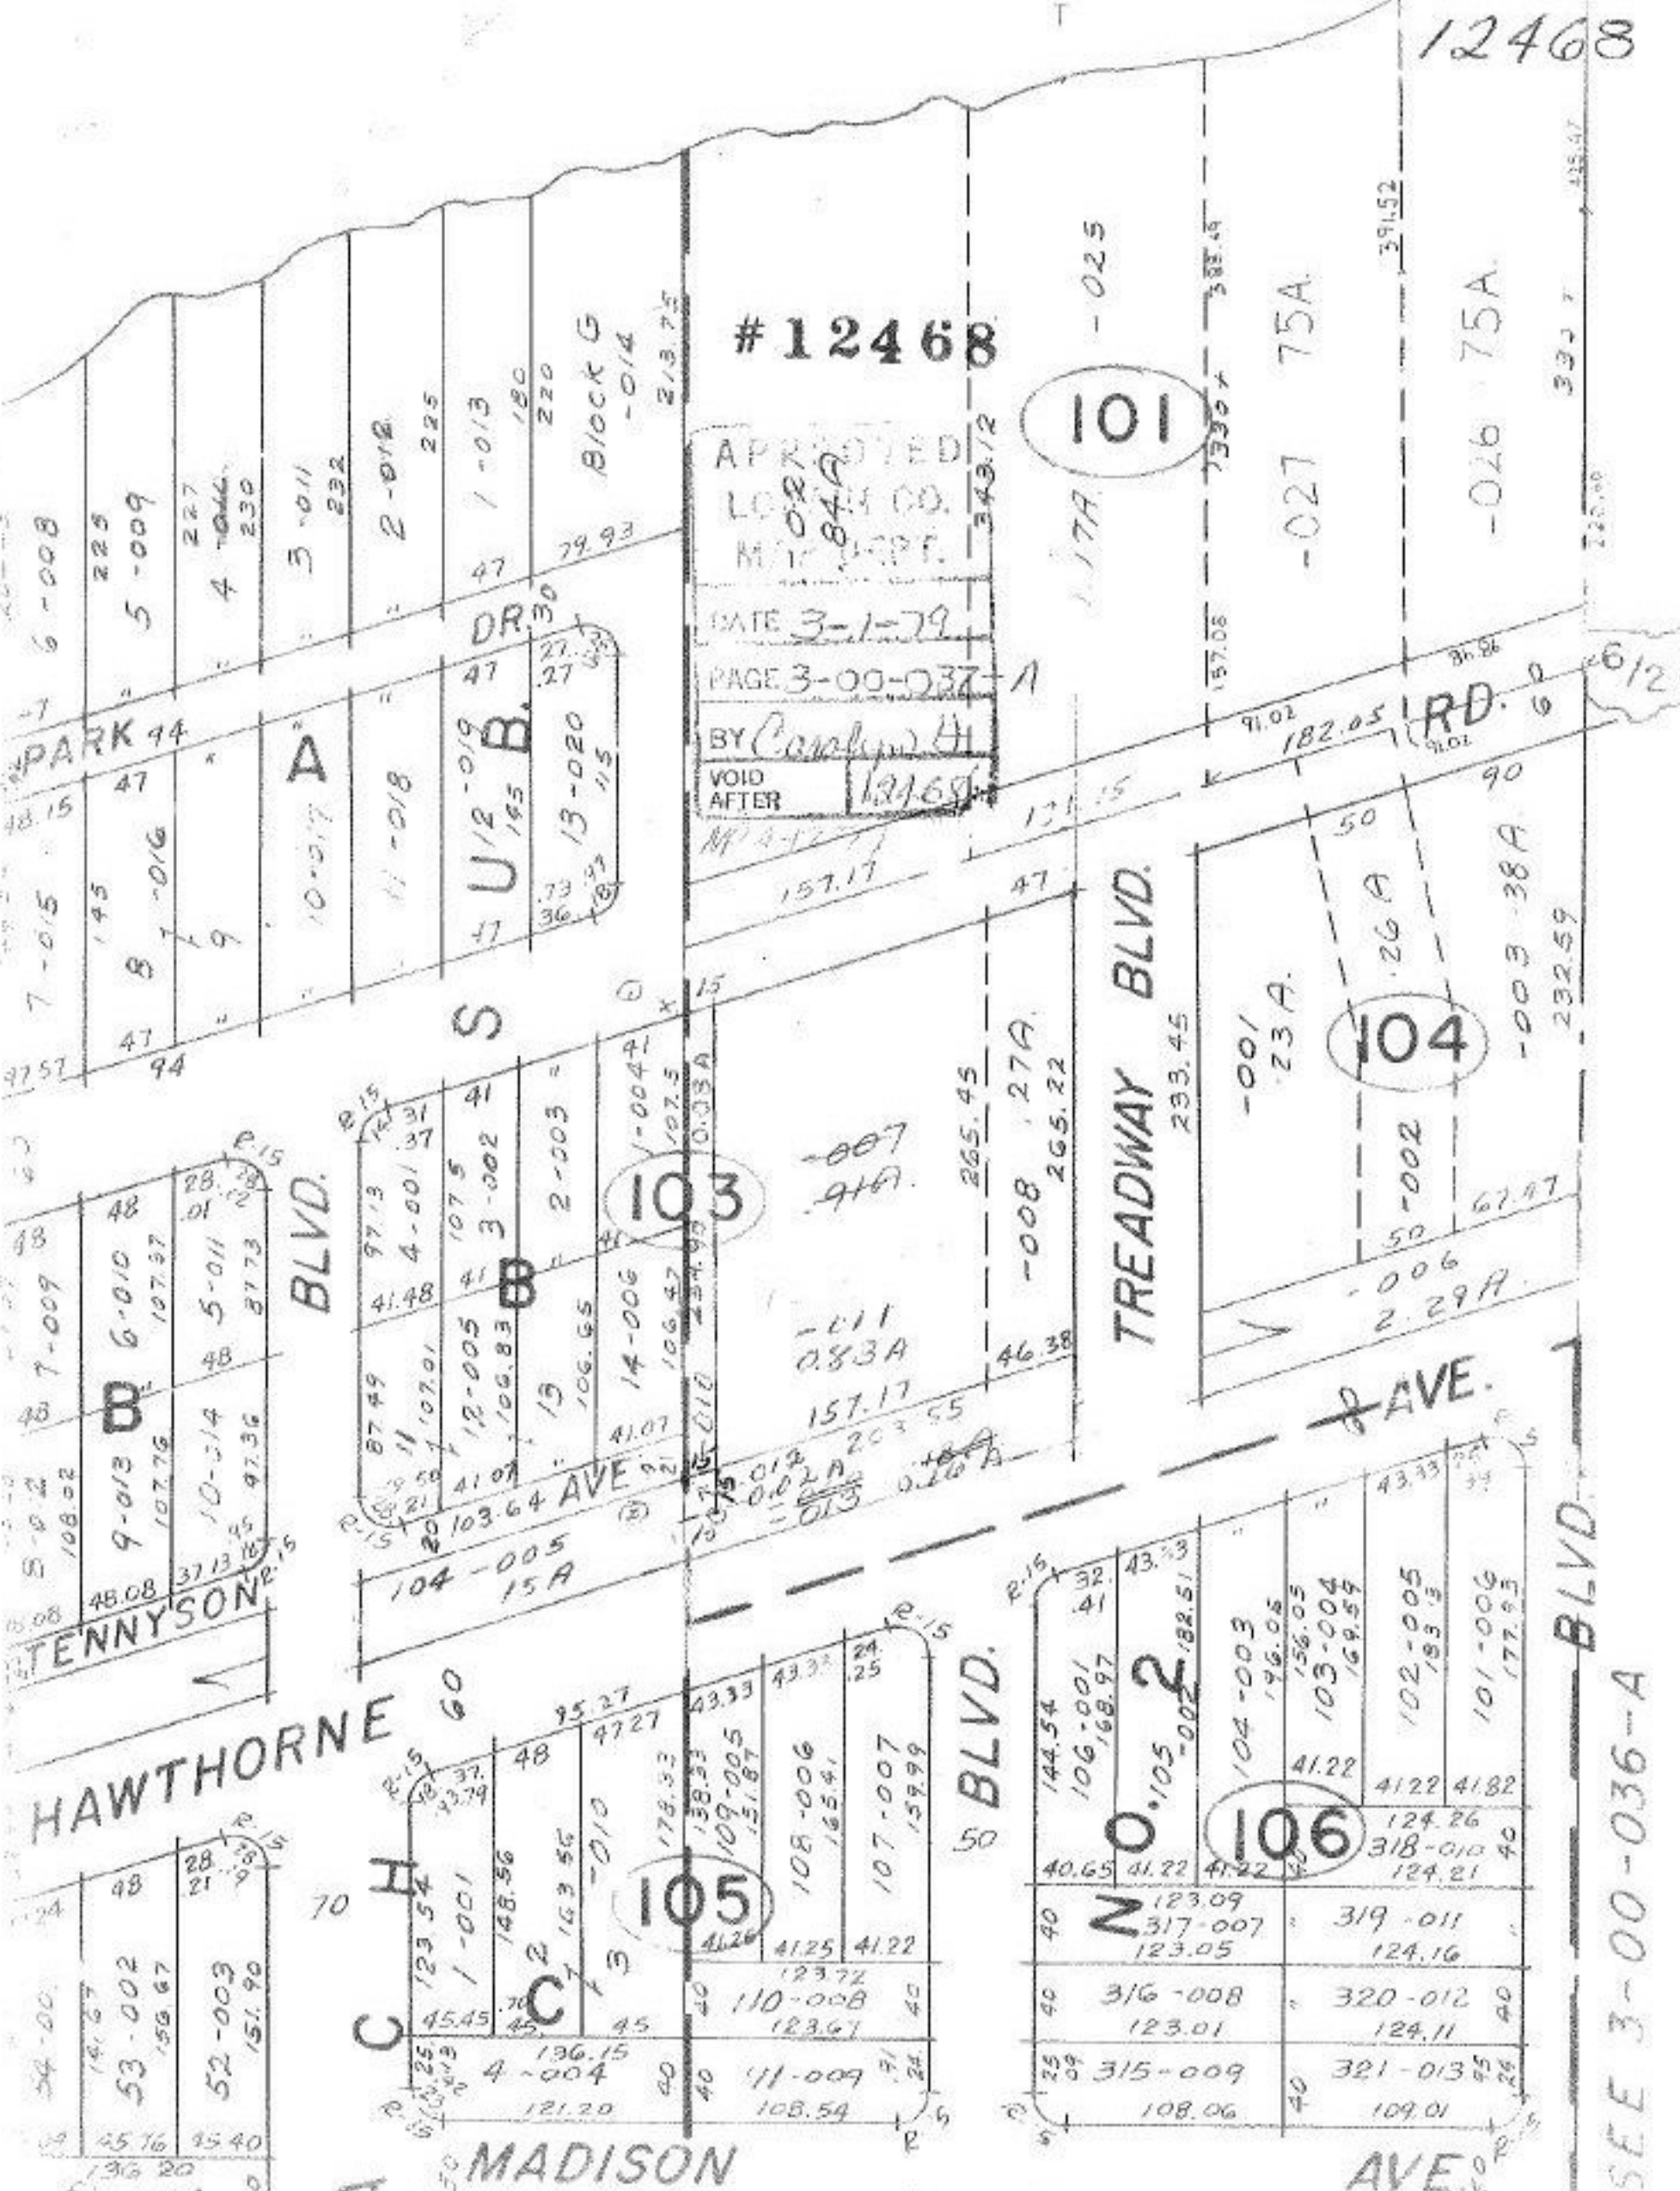

12468

APPROVED
 LOAN CO.
 M.I. DEPT.
 DATE 3-1-79
 PAGE 3-00-037-1
 BY *(Signature)*
 VOID AFTER 12468

101

103

104

105

106

SEE 3-00-036-A