

Depth Corr. To Dwp. No Map Correction

#12493

APPROVED
LORAIN CO.
MAP DEPT.
DATE 3-5-77
PAGE 6-78
BY <i>Rolland</i>
VOID AFTER


11/6/79

SEE 6-79

60	160.81	39-020	160.55	53	39.65	48.63
53	160.55	38-019	160.53	54	54	53
53	160.53	37-018	160.53	54	54	53
53	164.68	36-017	164.68	54	54	53
53	175.12	35-016	175.12	54	54	53
53	183.20	34-015	183.20	54	54	53
53	182.90	33-014	182.90	54	54	53
53	182.37	32-013	182.37	54	54	53
53	181.84	31-012	181.84	54	54	53
53	181.34	30-011	181.34	54	54	53
53	180.18	29-010	180.18	54	54	53
53	180.25	28-009	180.25	54	54	53
53	179.72	27-008	179.72	54	54	53
53	179.1	26-007	179.1	54	54	53
53	178.66	25-006	178.66	54	54	53
53	178.1	24-005	178.1	54	54	53

1057.35
1057.36
1057.01 D.

25

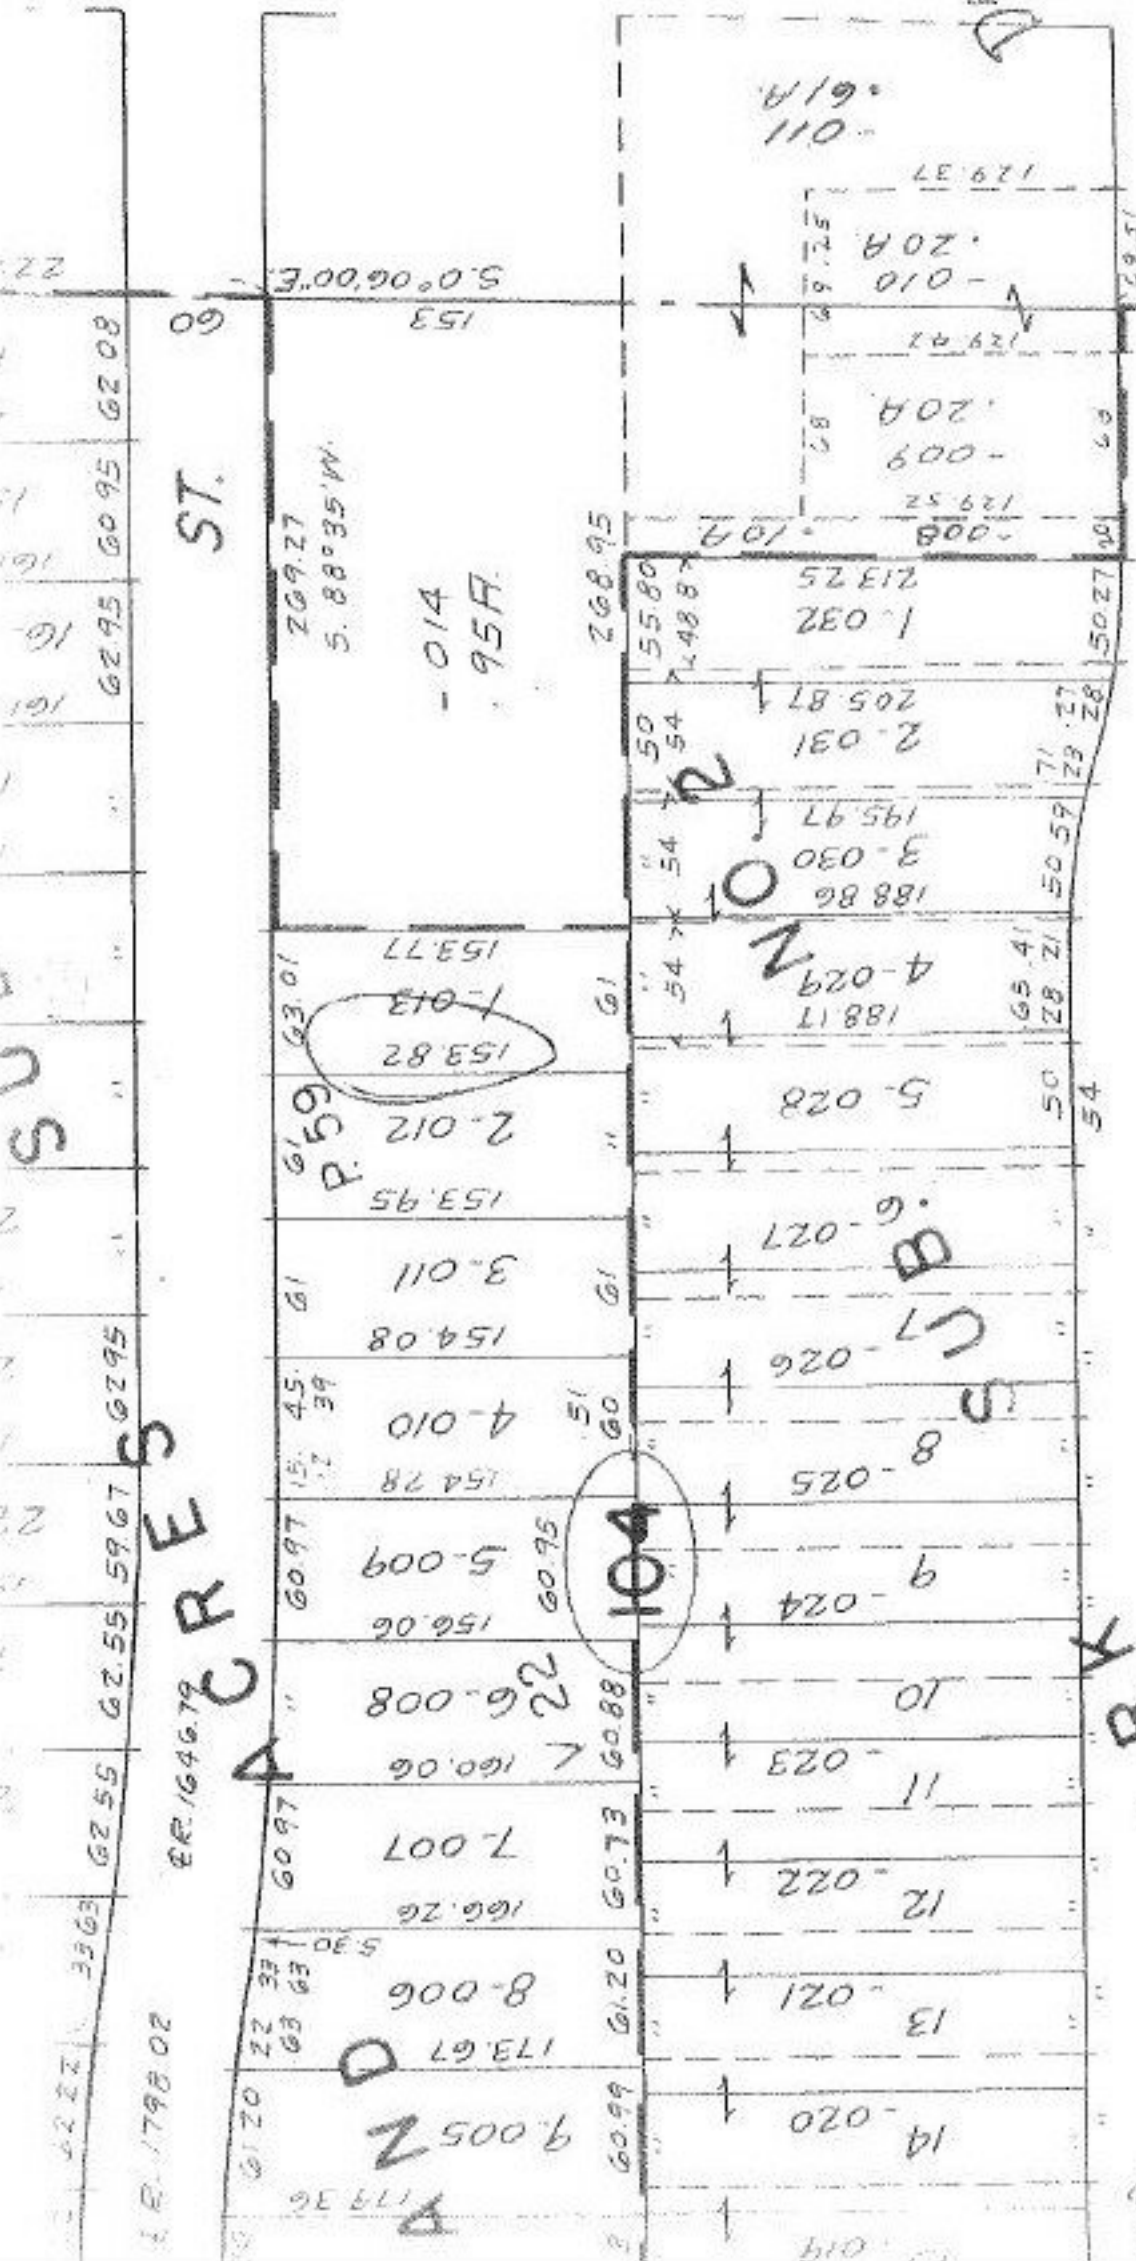

62.22 33.63 62.55 62.55 59.67 62.95 62.95 60.95 62.08

ER-179802 ER-164679

ST. 9

DR.

104

102

101

100

99

98

97

96

95

94

93

153

209

208

207

206

205

204

203

202

201

200

199