


K.H
3-13-79

APPROVED
LORAIN CO.
NOV 4 1979
DATE 3-5-79
PAGE 9-00-094 H
BY <i>Stevenson</i>
VOID
AFTER

#12494

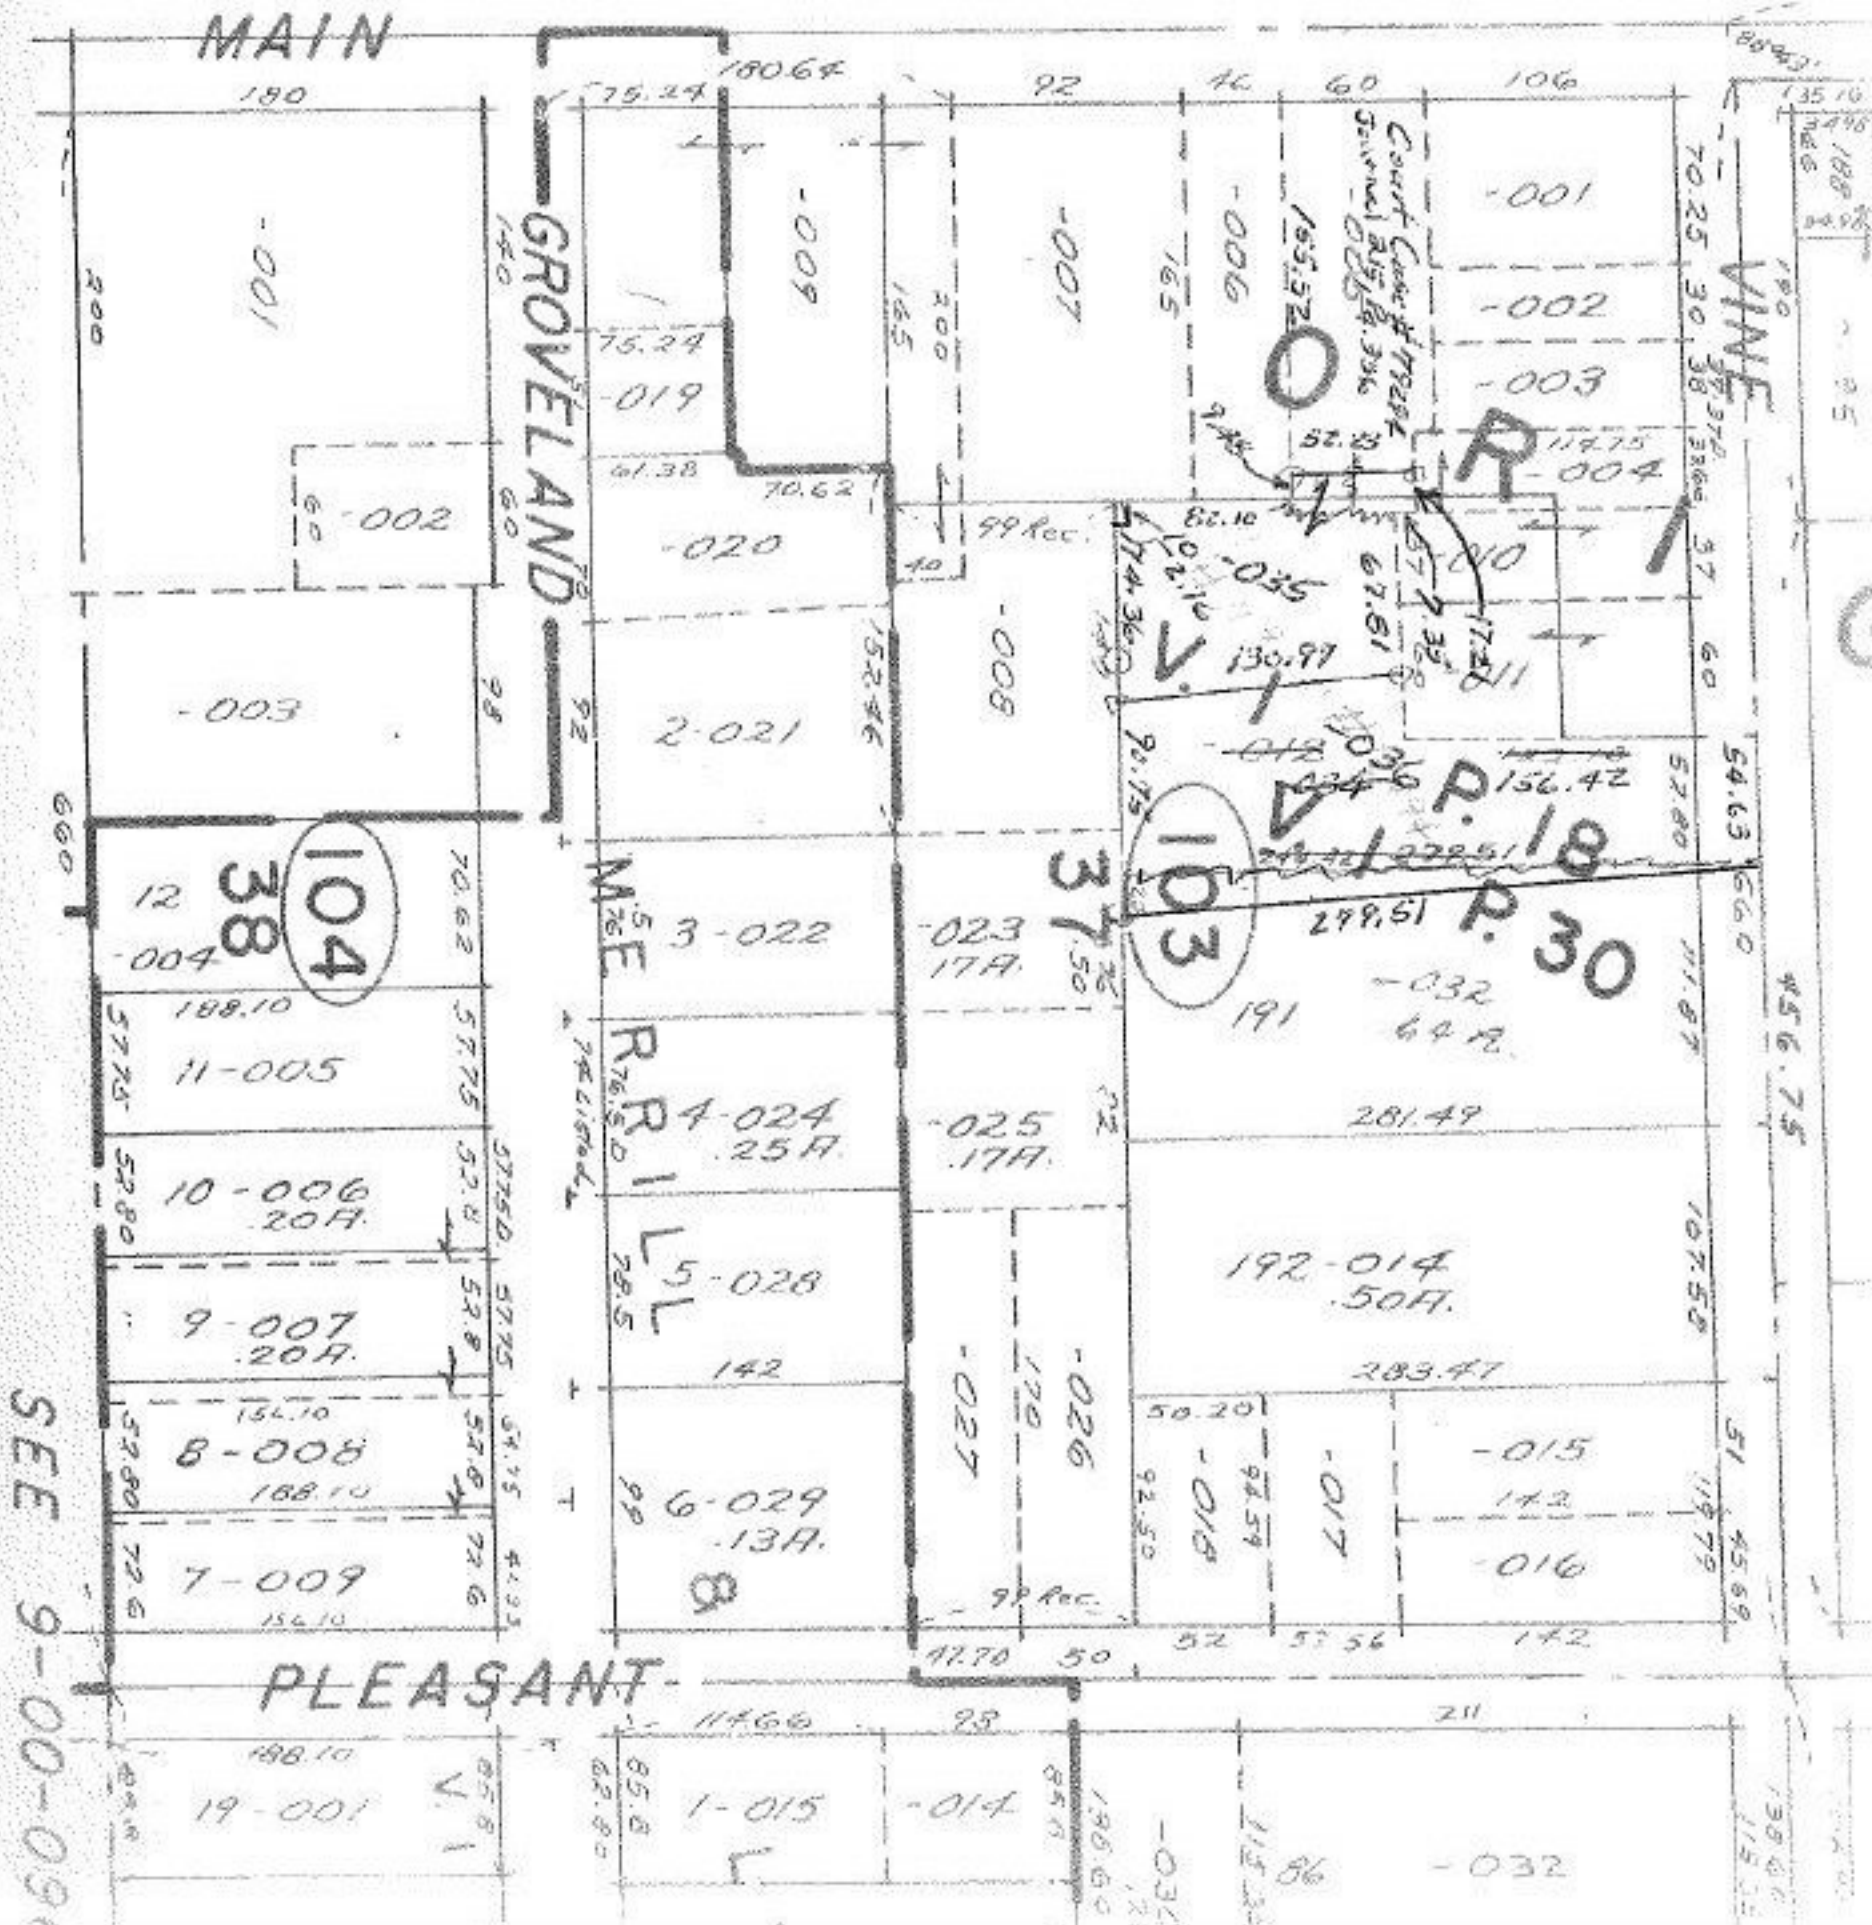

SEE 9-00-094