

Pt - 006
Pt 2614 A.

FILE

MAP CORR.
SEE DEED
Vol. - P 9.
754 - 584
1015 - 740


MAP CORR.
ONLY

MAR 19 1979



#12495
APPROVED
LORAIN CO.
MAP DEPT.
DATE 3-6-79
PAGE 12-00-076B
BY *L. Lockett*
VOID
AFTER

12-00-076-B

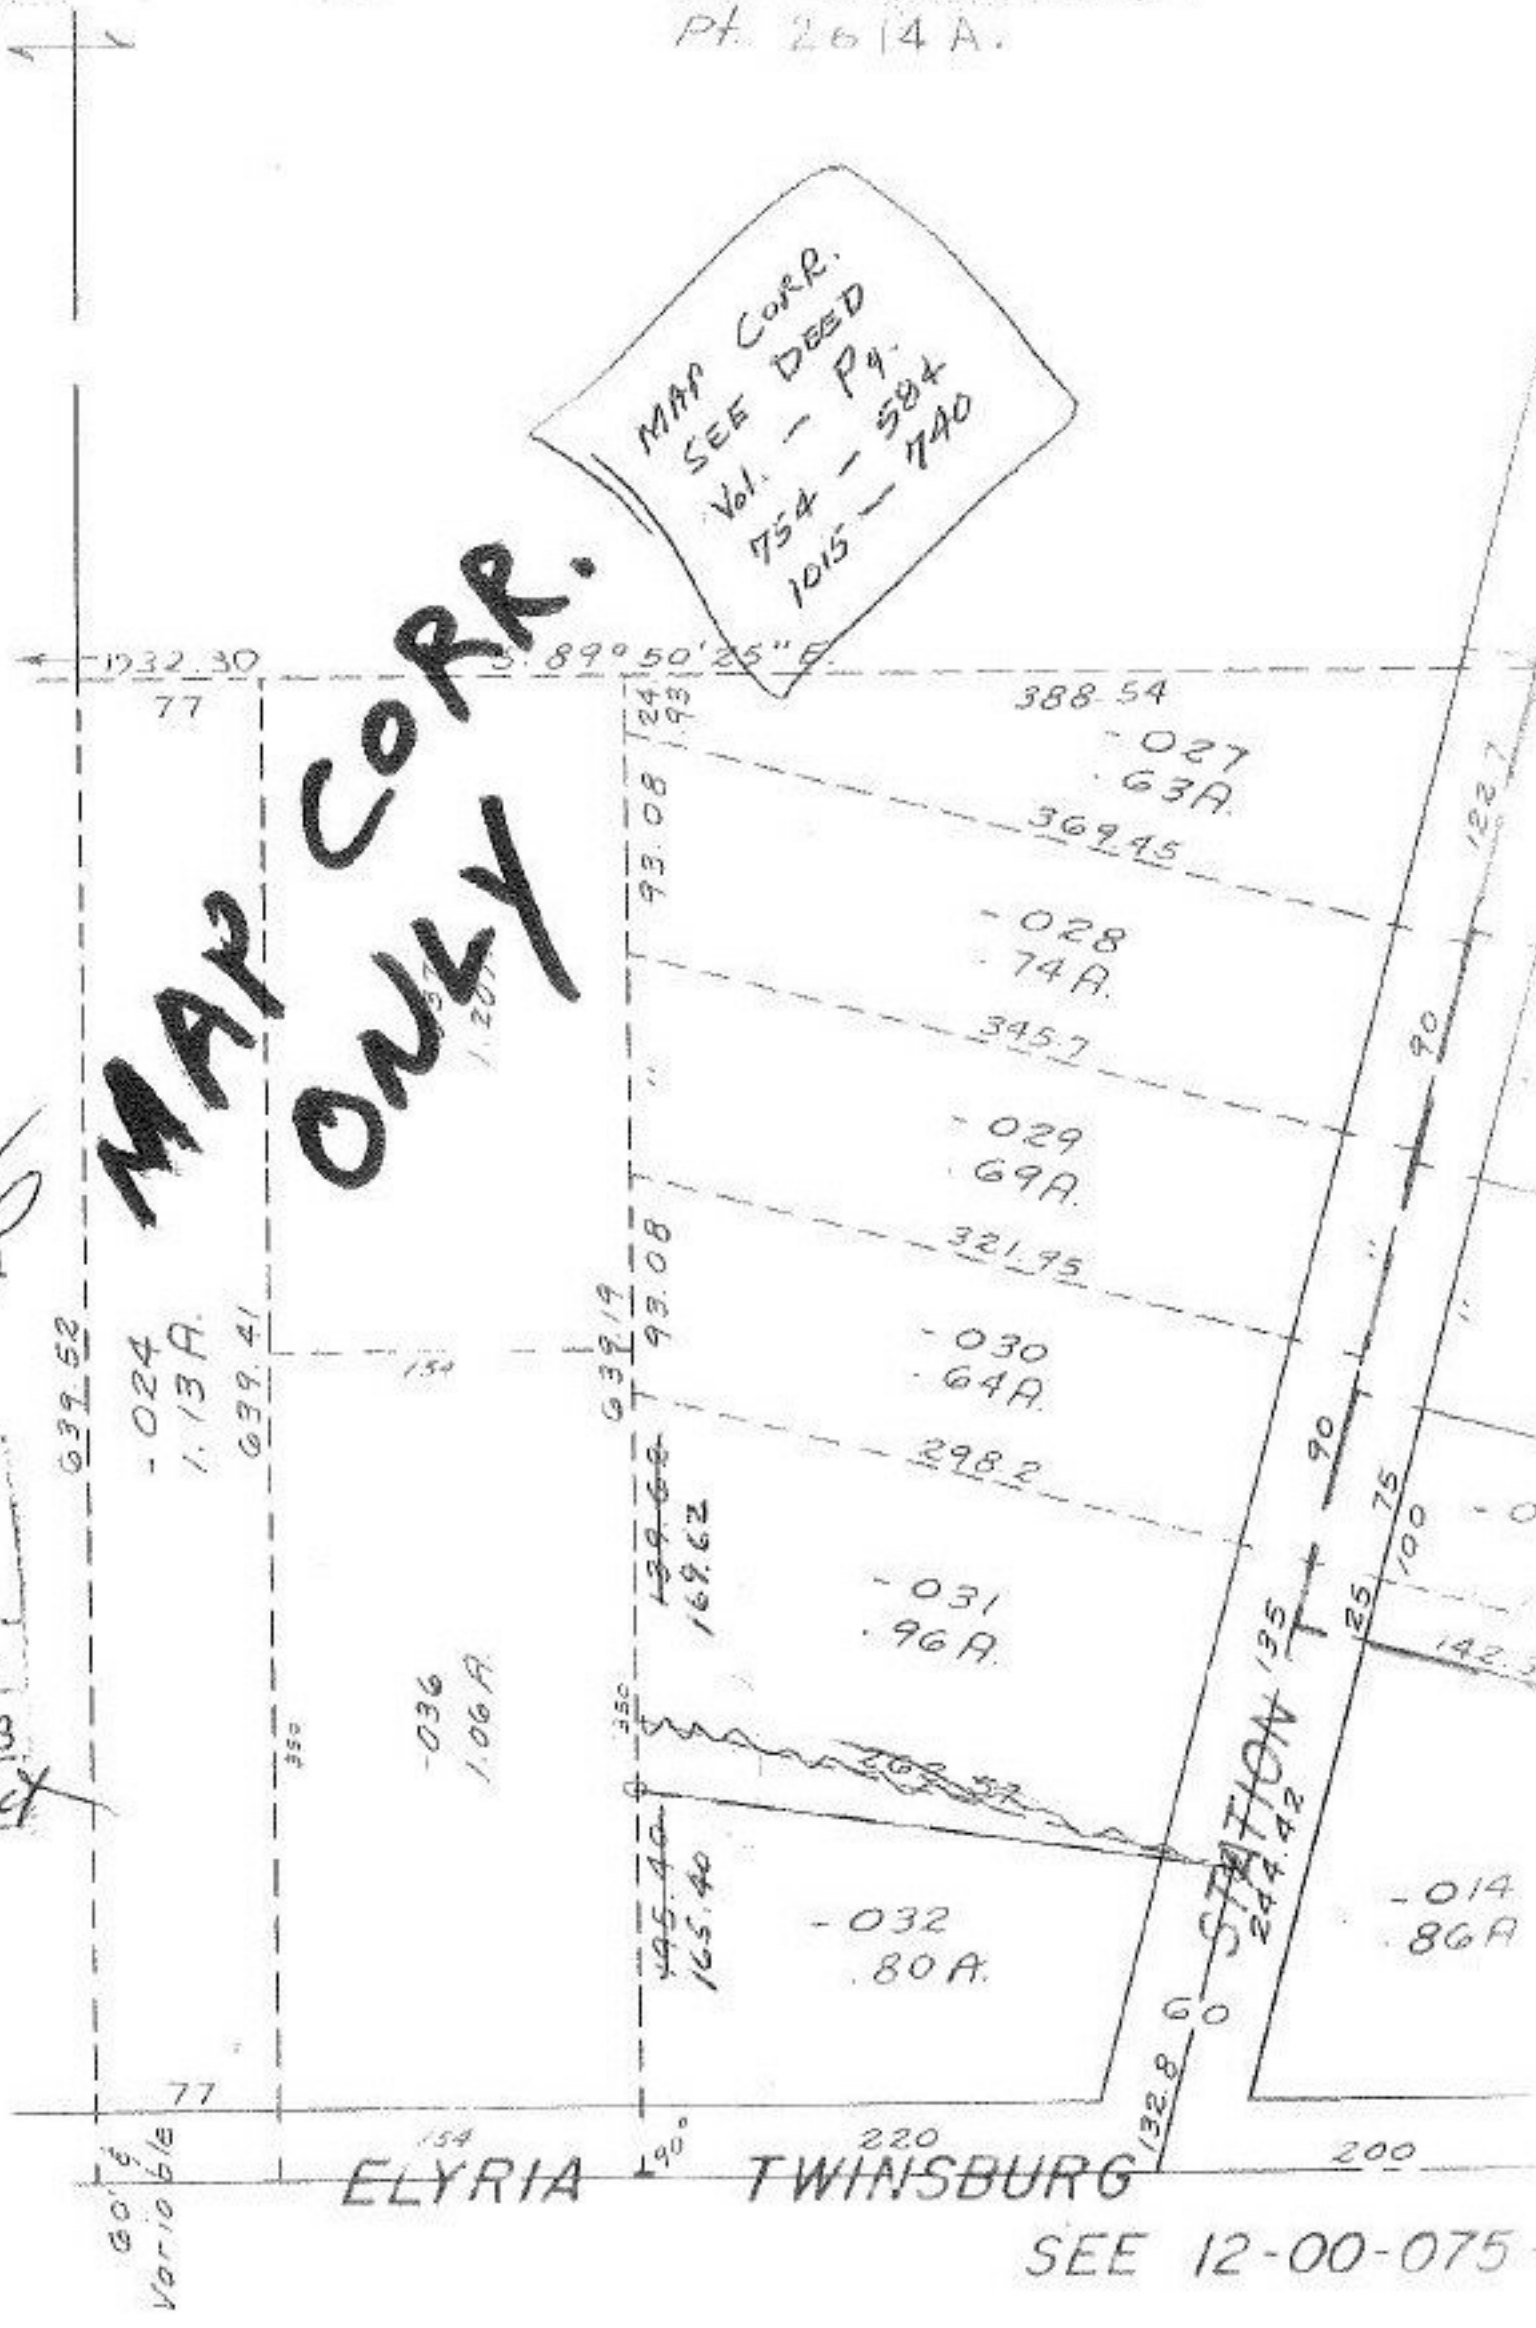

COLUMBIA TWP