


Combine 12527
COMBINATION

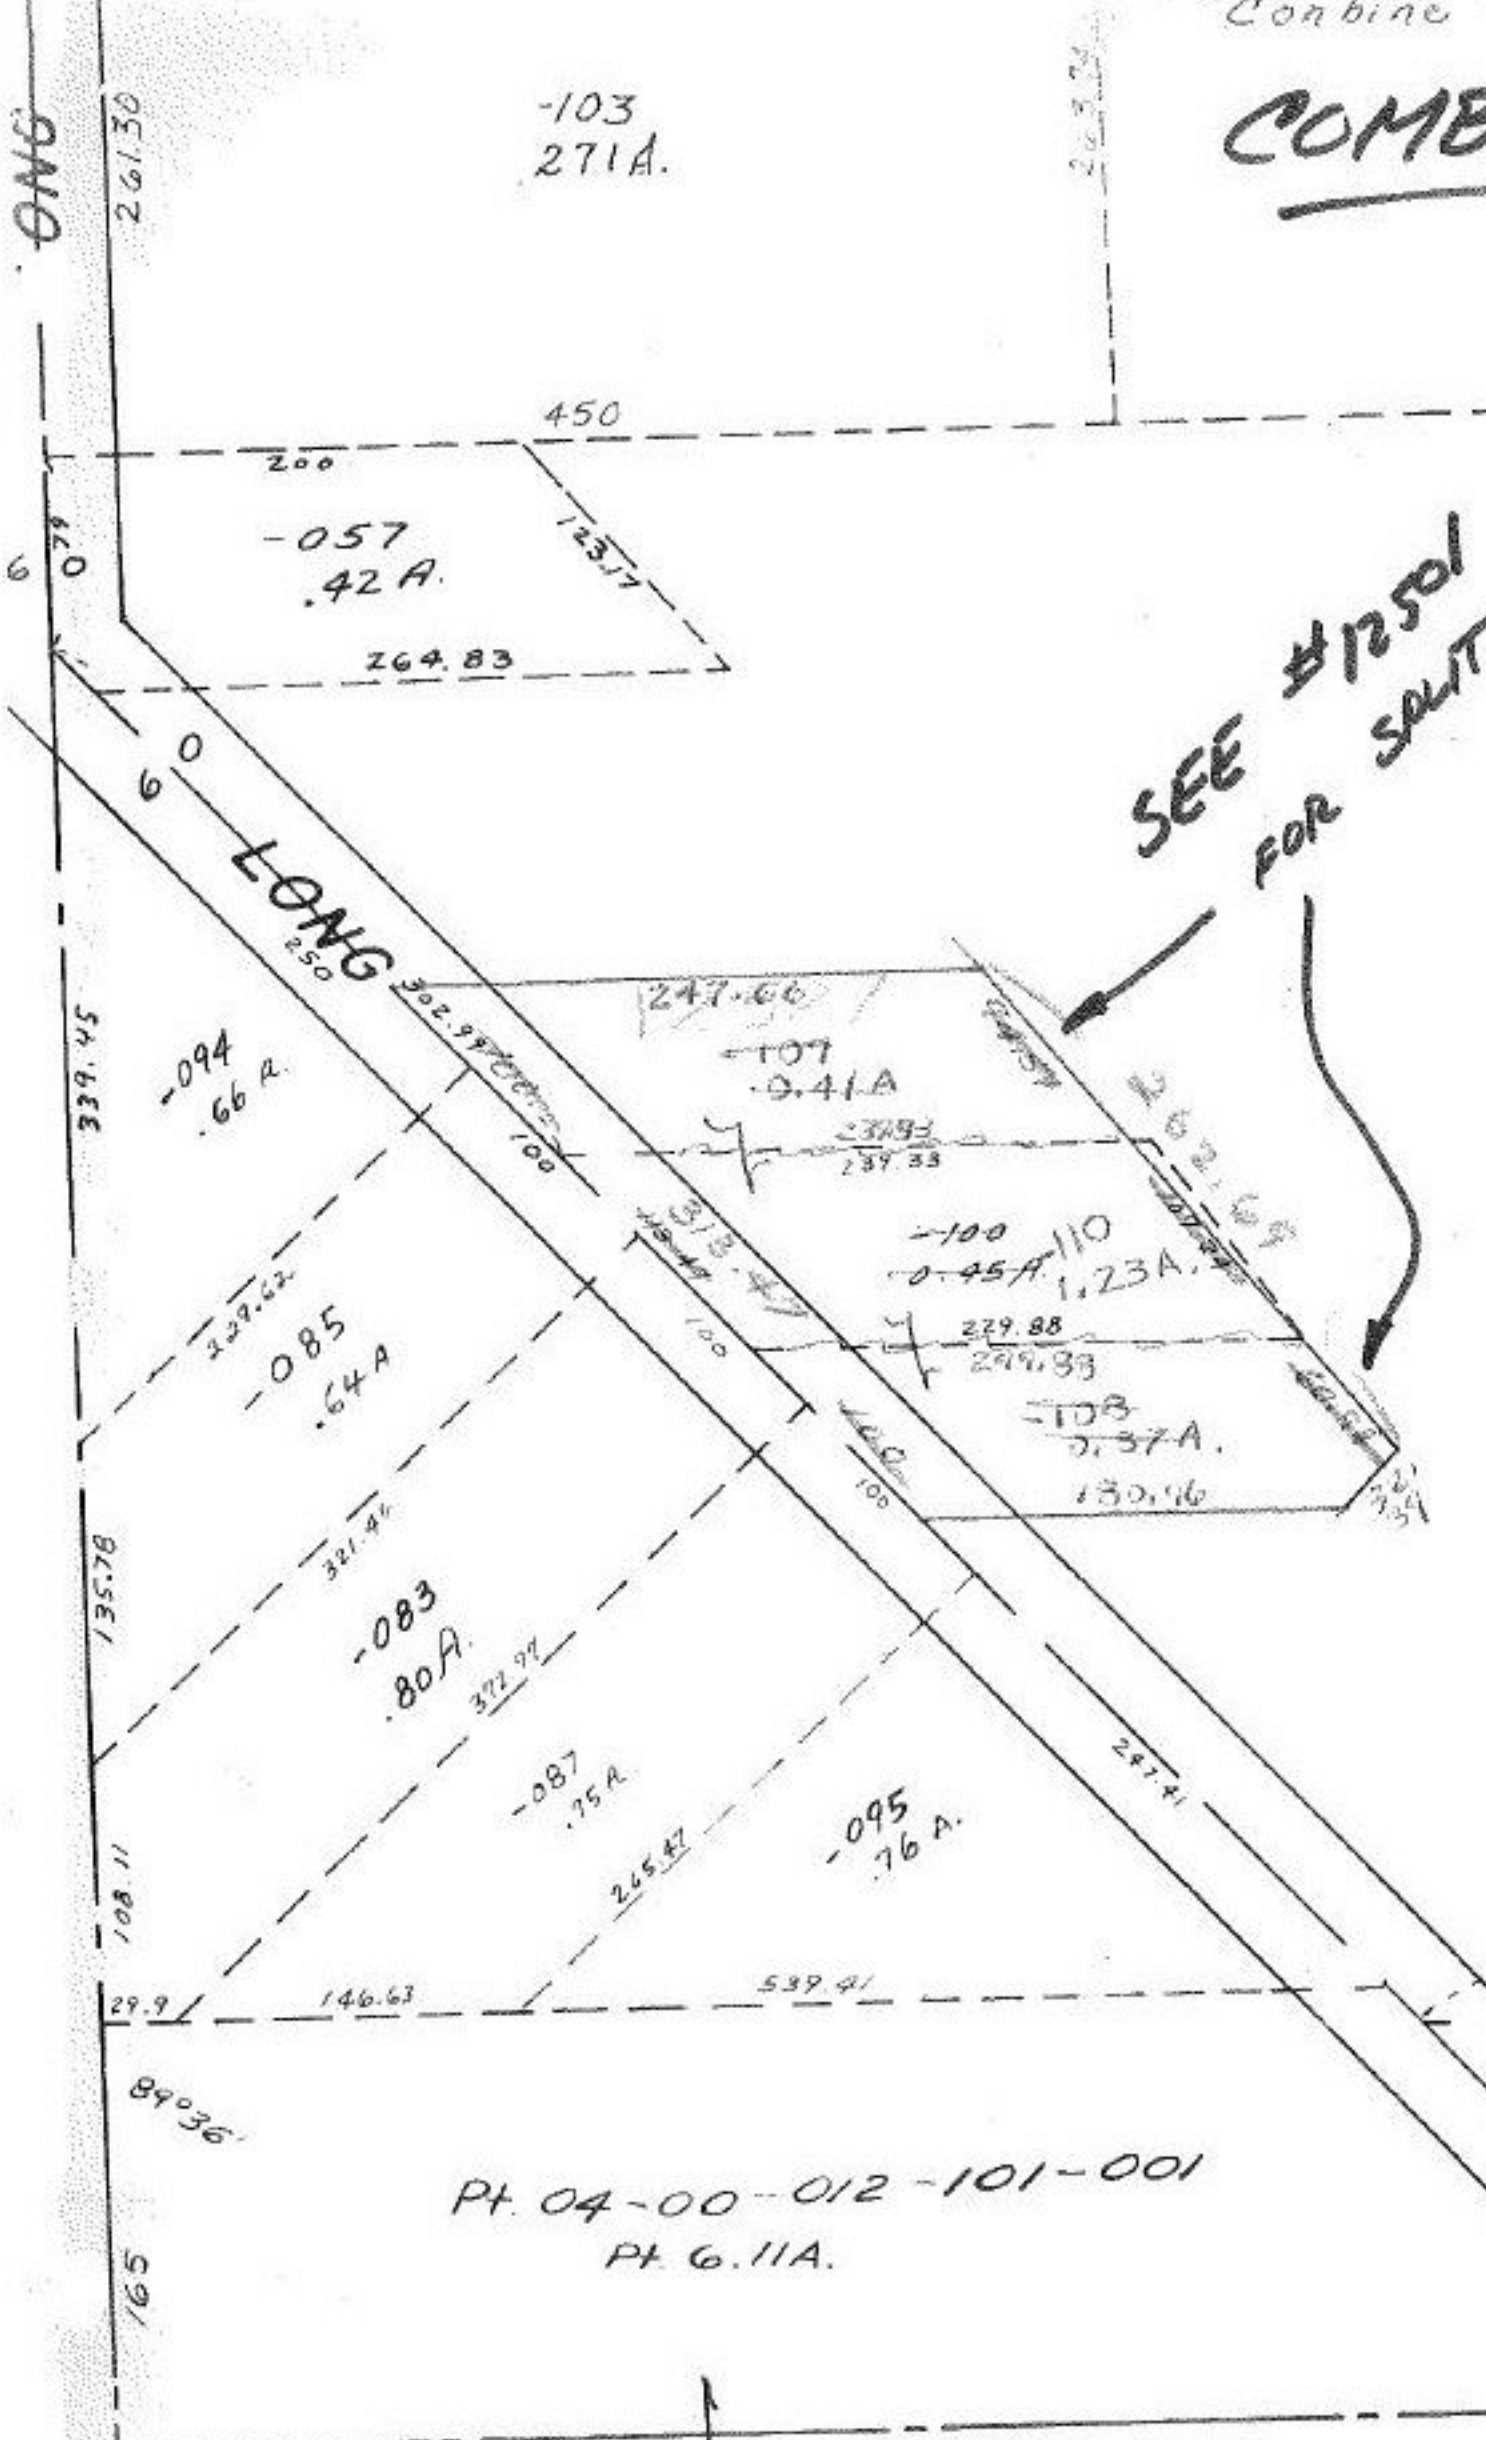

SEE #12501
FOR SALTS

94.51
 107.24
 60.94

 262.69

Pt. -101
 Pt. 35.52 A.

#12527

APPROVED	
MORAIN CO.	
MAP DEPT.	
DATE 3-28-79	
BY 4-00-011-E	
CAMPBELL	
VOID	12527
AFTER	

Pt. 04-00-012-101-001
 Pt. 6.11A.

RD. 60

SEE 4-00-0