


#12542

MEDINA - NORWALK

18

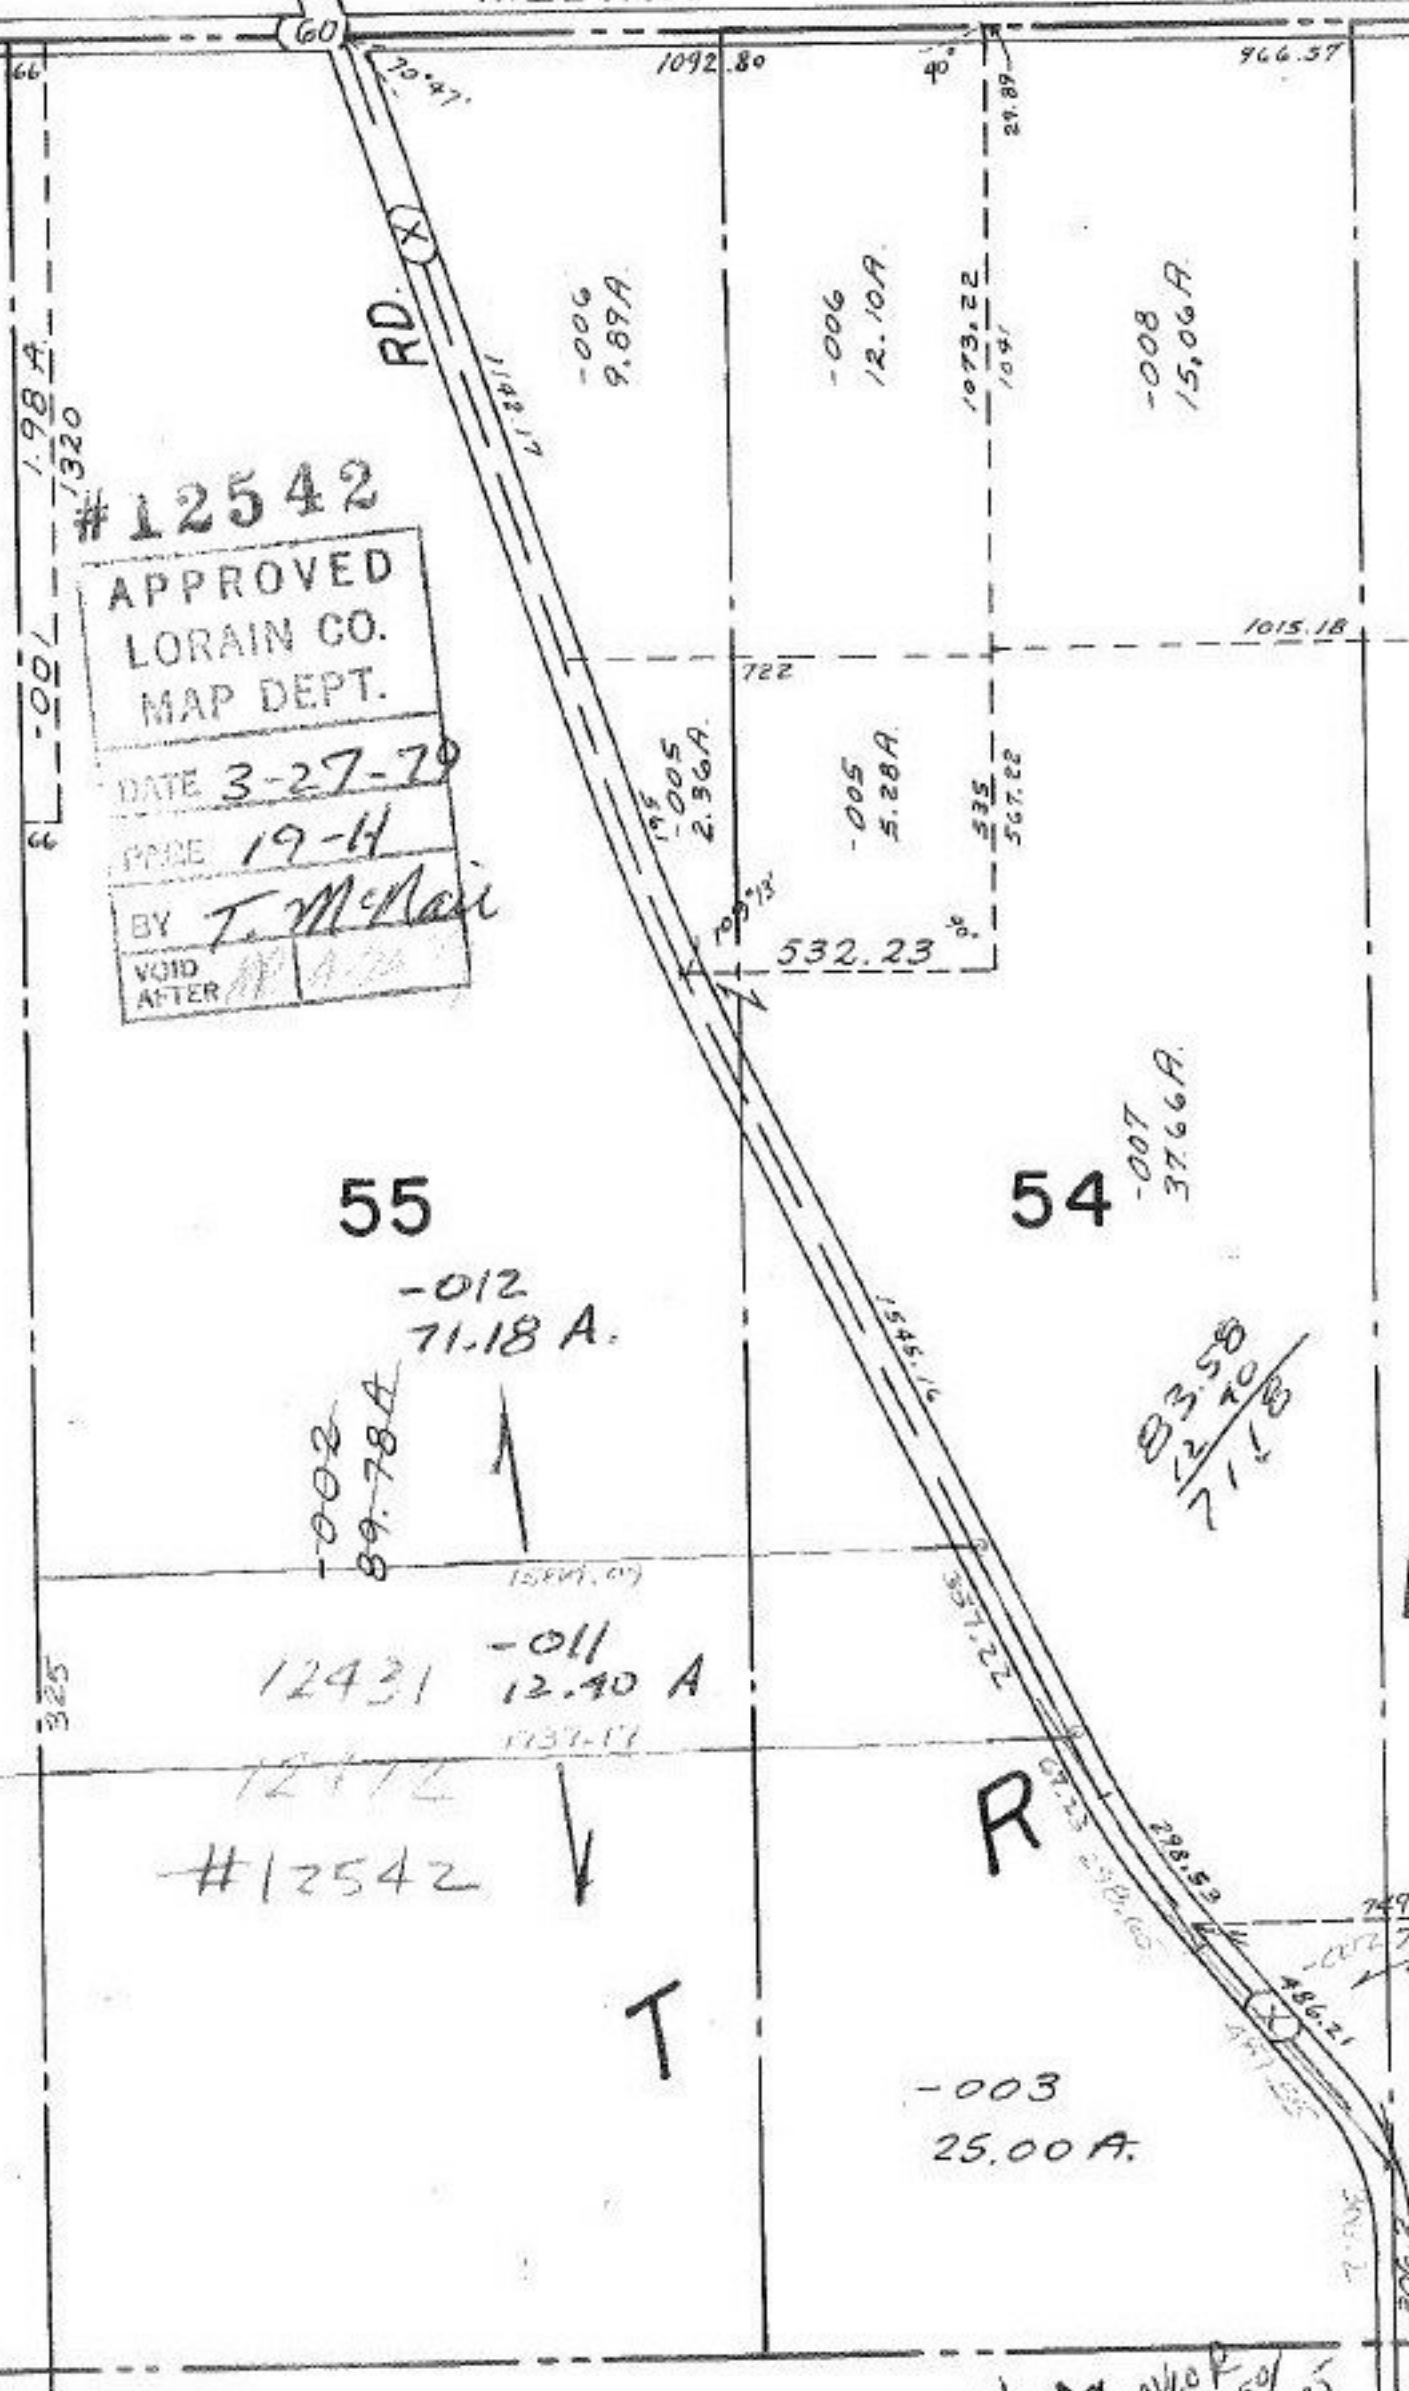

#12542
 APPROVED
 LORAIN CO.
 MAP DEPT.
 DATE 3-27-79
 PAGE 19-14
 BY T. McNeil
 VOID AFTER

55

54

-012
71.18 A.

-002
89.78 A

12431 -011
12.40 A

#12542

T

R

-003
25.00 A.

TAYLOR 10/50/25