


12567

STOCKING

RD.

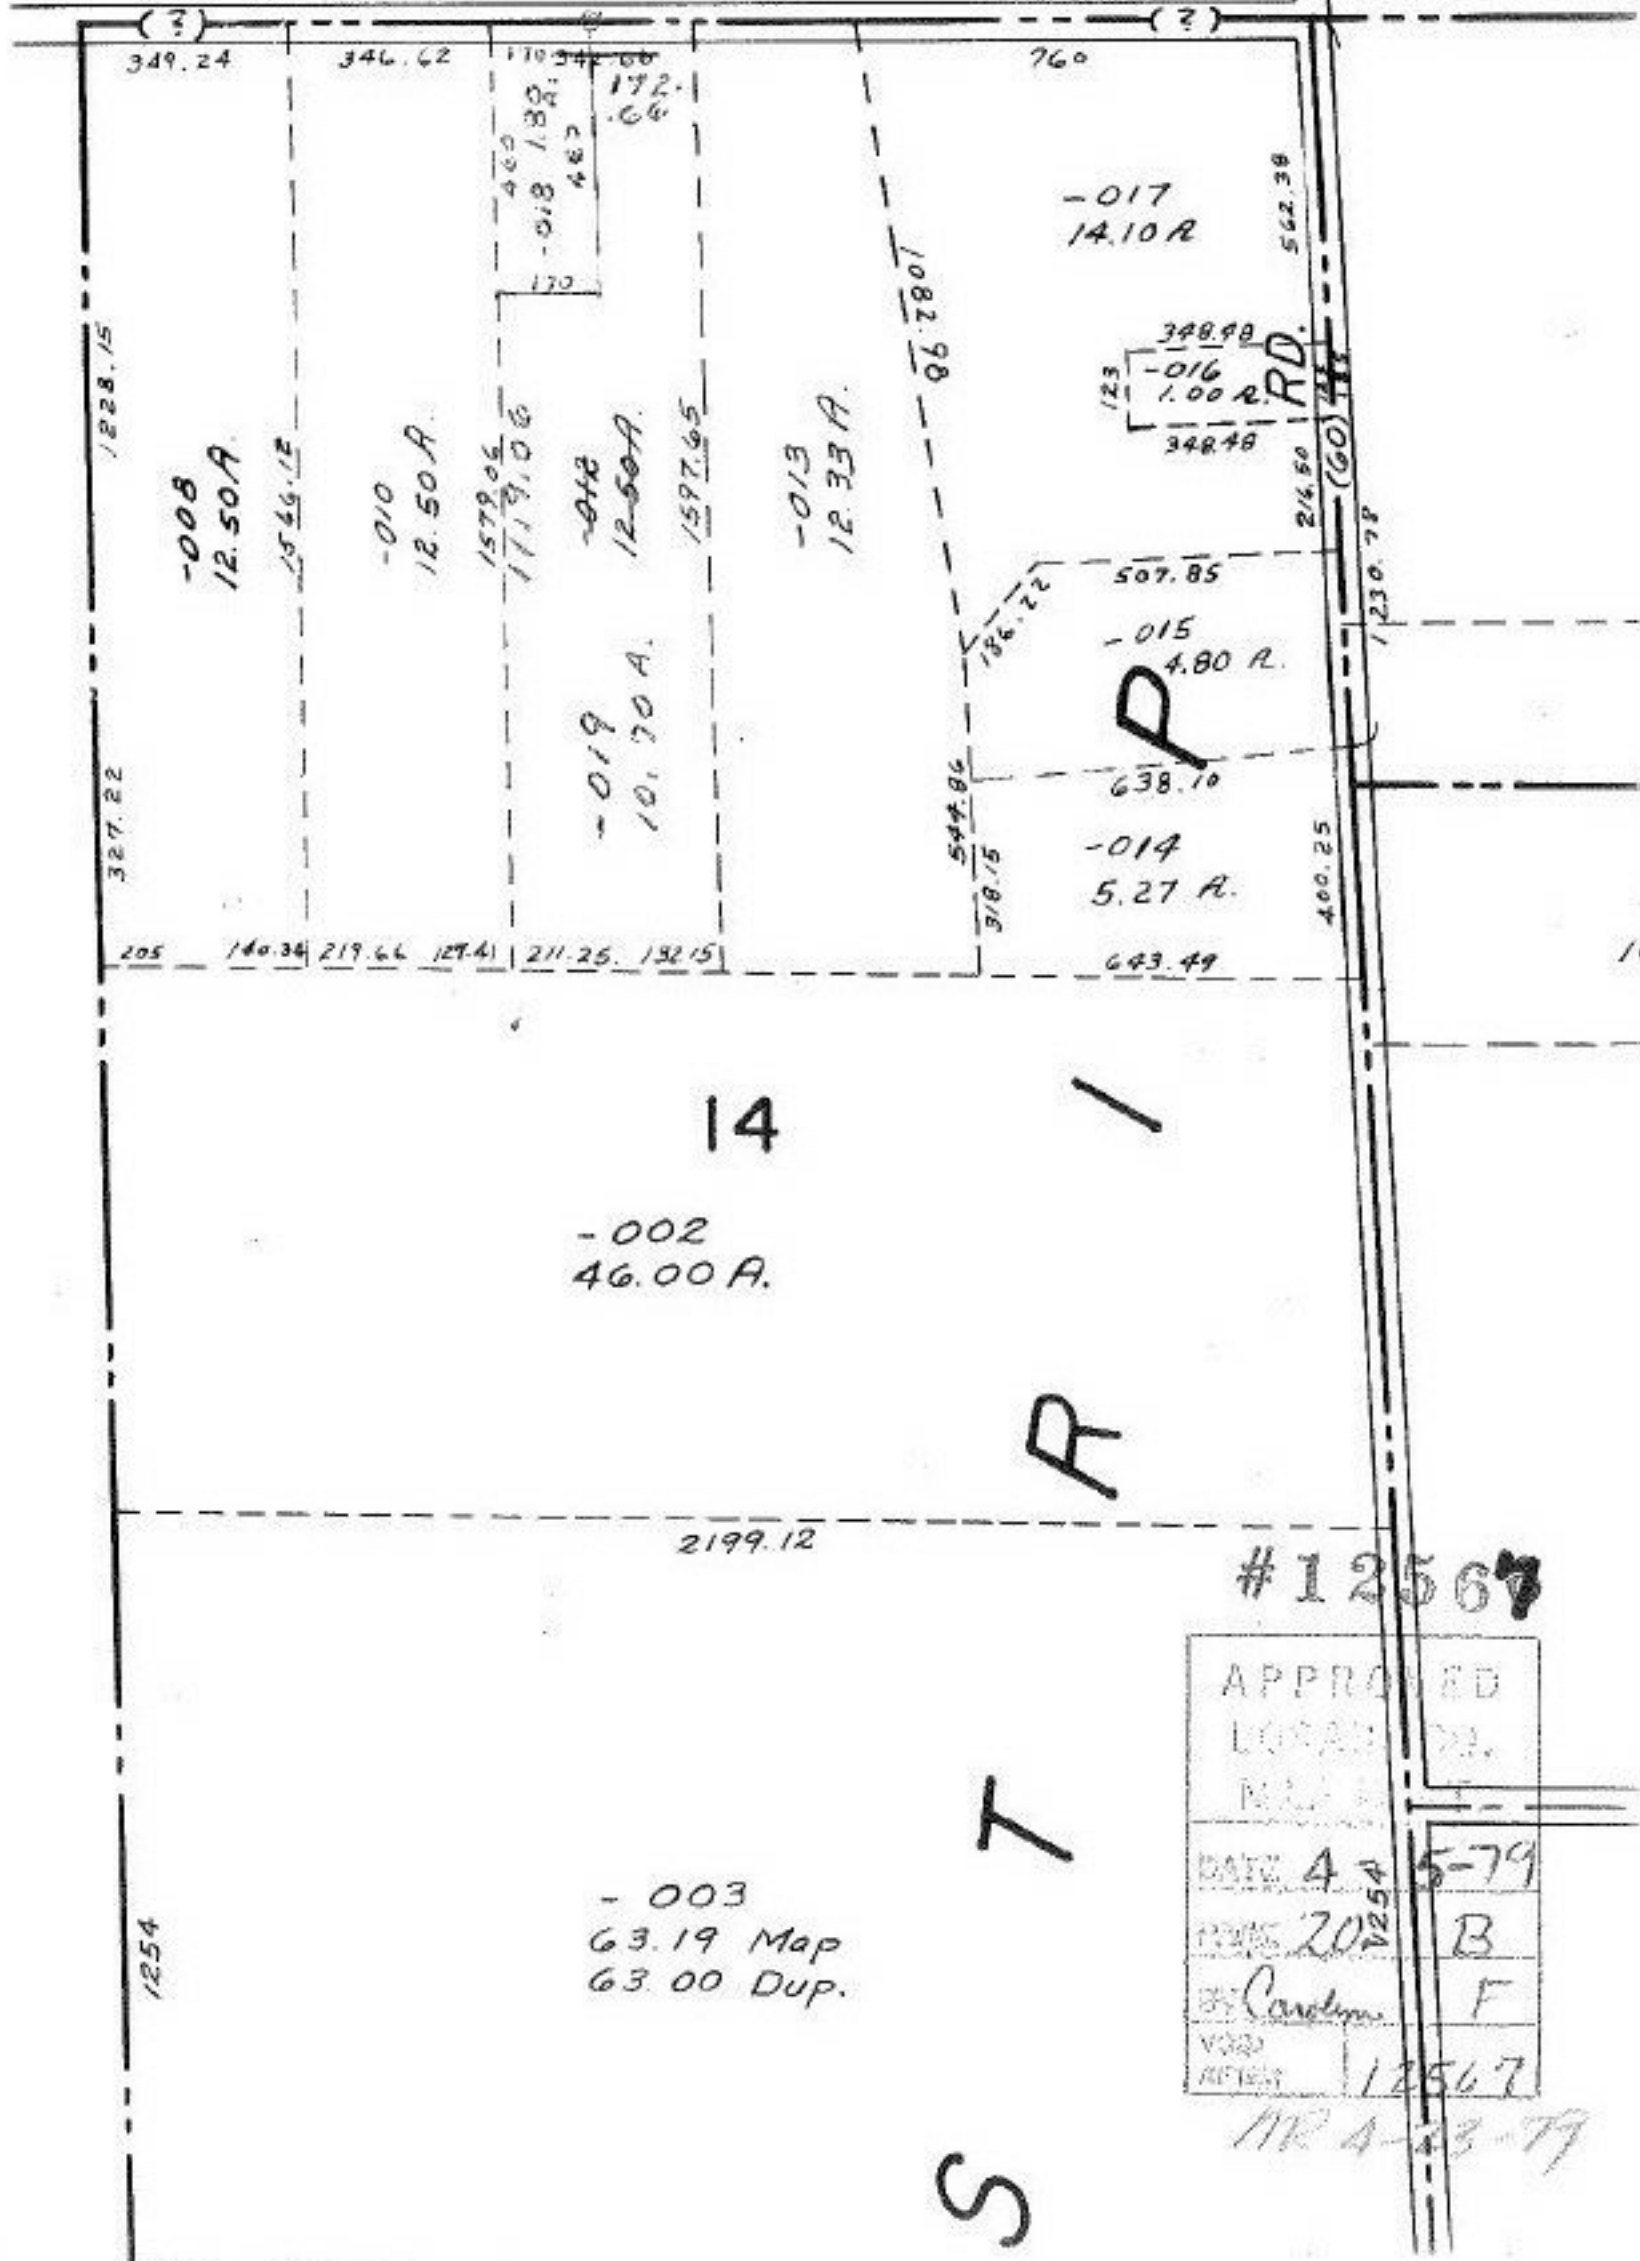

349.24

346.62

170.34

760

1228.15

327.22

205

140.34

219.66

129.41

211.25

152.15

-008  
12.50 A.

-010  
12.50 A.

-019  
10.70 A.

-013  
12.33 A.

14  
-002  
46.00 A.

-003  
63.19 Map  
63.00 Dup.

-017  
14.10 R.

-016  
1.00 R.

-015  
4.80 R.

-014  
5.27 R.

#12567

APPROVED	
LOCATED BY	
DATE	4-5-79
PLANS	20254 B
BY	Caroline F
VOIP	
REFID	12567

MR 4-23-79

S  
T  
R  
I  
P