


12569

ALBERT

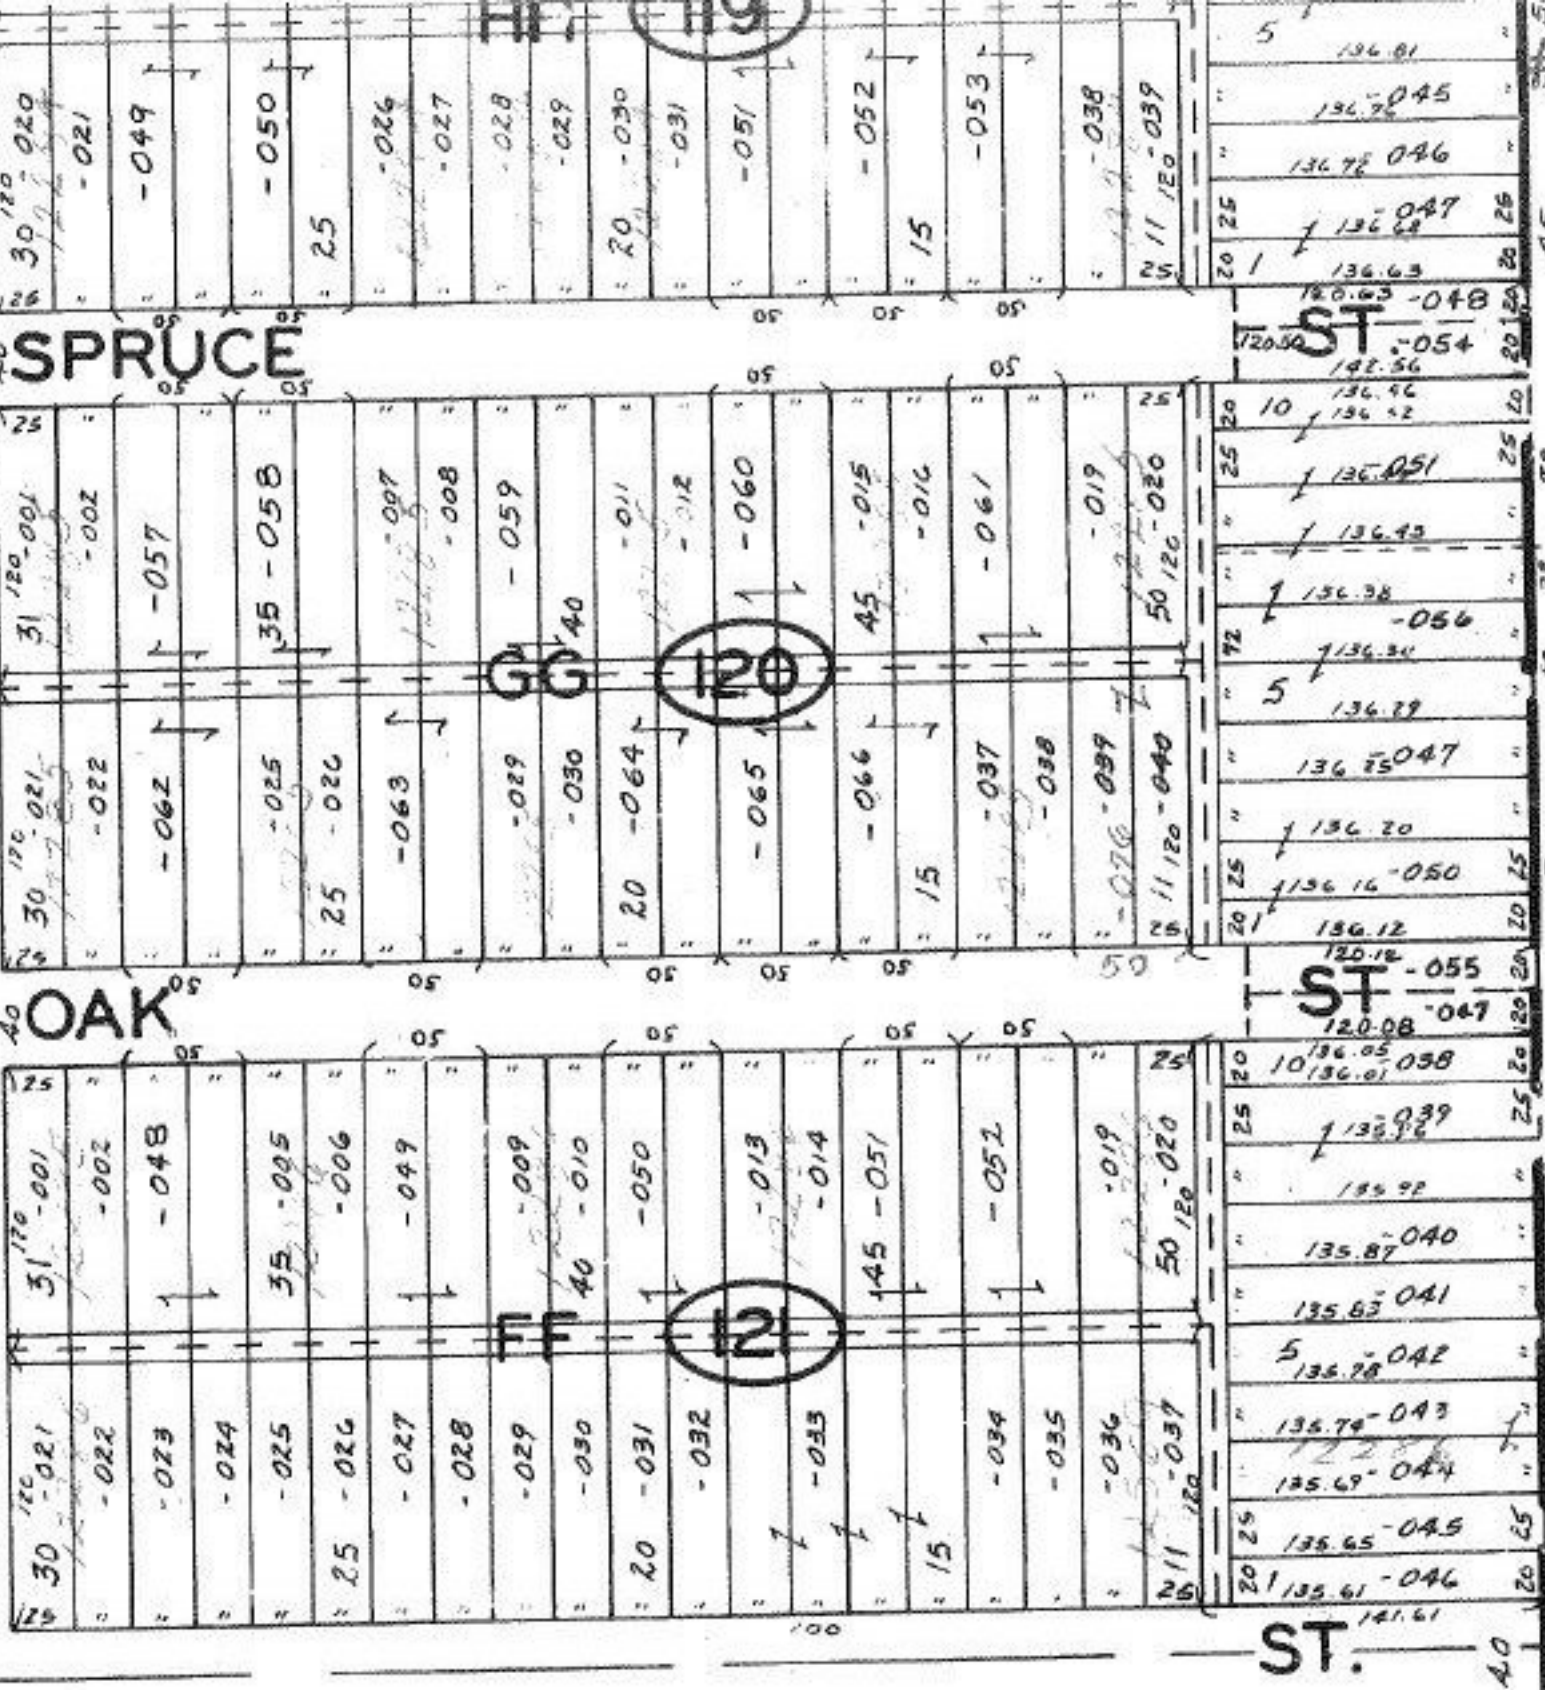

JAYCOX

#12569

APPROVED
 RAIN CO.
 MAP DEPT.
 DATE 4-5-79
 PWS 7-00-020-B
 BY Carolyn F
 VOID AFTER 12569

F.M.
5-2-79

REVISED 10-1-75

7-00-020-B

LOT 20