

#12571


#12571

DATE	4-5-79
PRINTS	5-00-093-B
BY	Caroleen F
VOLD	12571
REFERS	

408.84
6-13-79

Pt -033
Pt 15.50 A.

-069
-063
6.76-R.

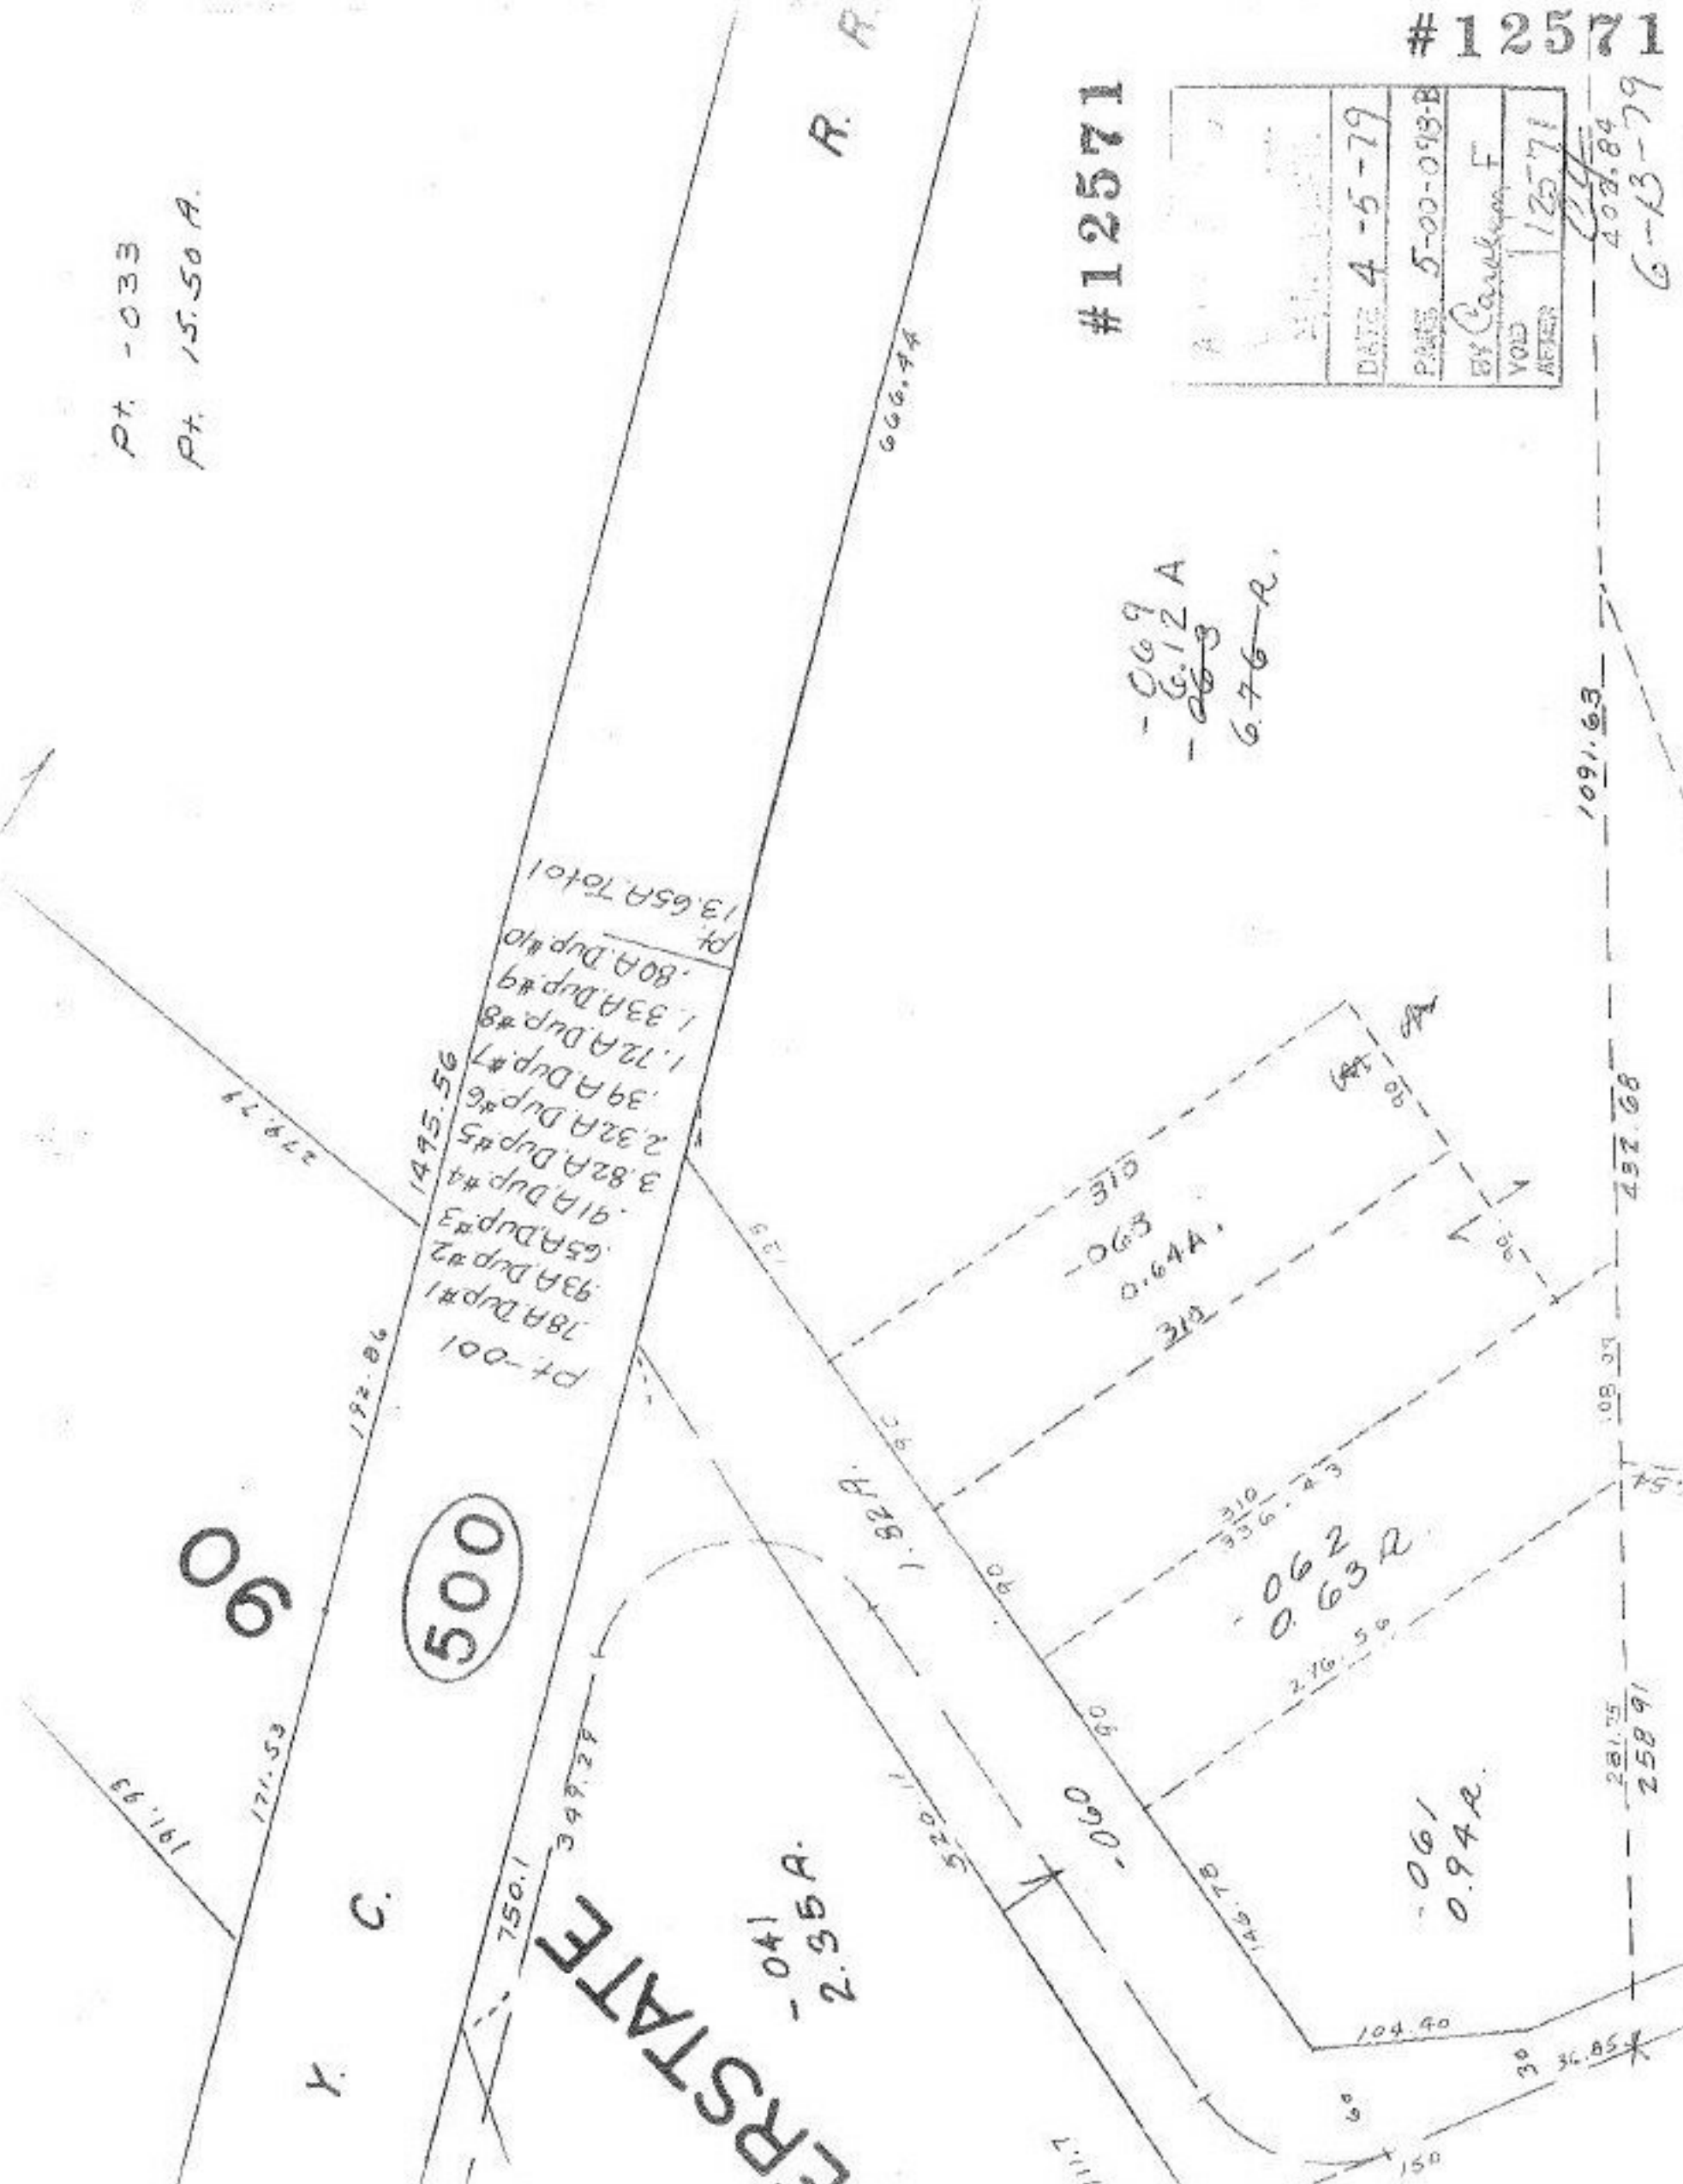

60

500

ERSTATH

-041
2.35A.

-061
0.94A.

062
0.63R

375
-063
0.64A.
312

Y. C.

R. R.