

#12581

#12581


APPROVED
LORAIN CO.
MAP DEPT.
DATE 4-10-79
PAGE 7-00-044-D
BY T.M. Hall
VOID AFTER

T.M.
5-2-79

~~005~~
~~6.05A~~

034
13.97 A

COMBINATION

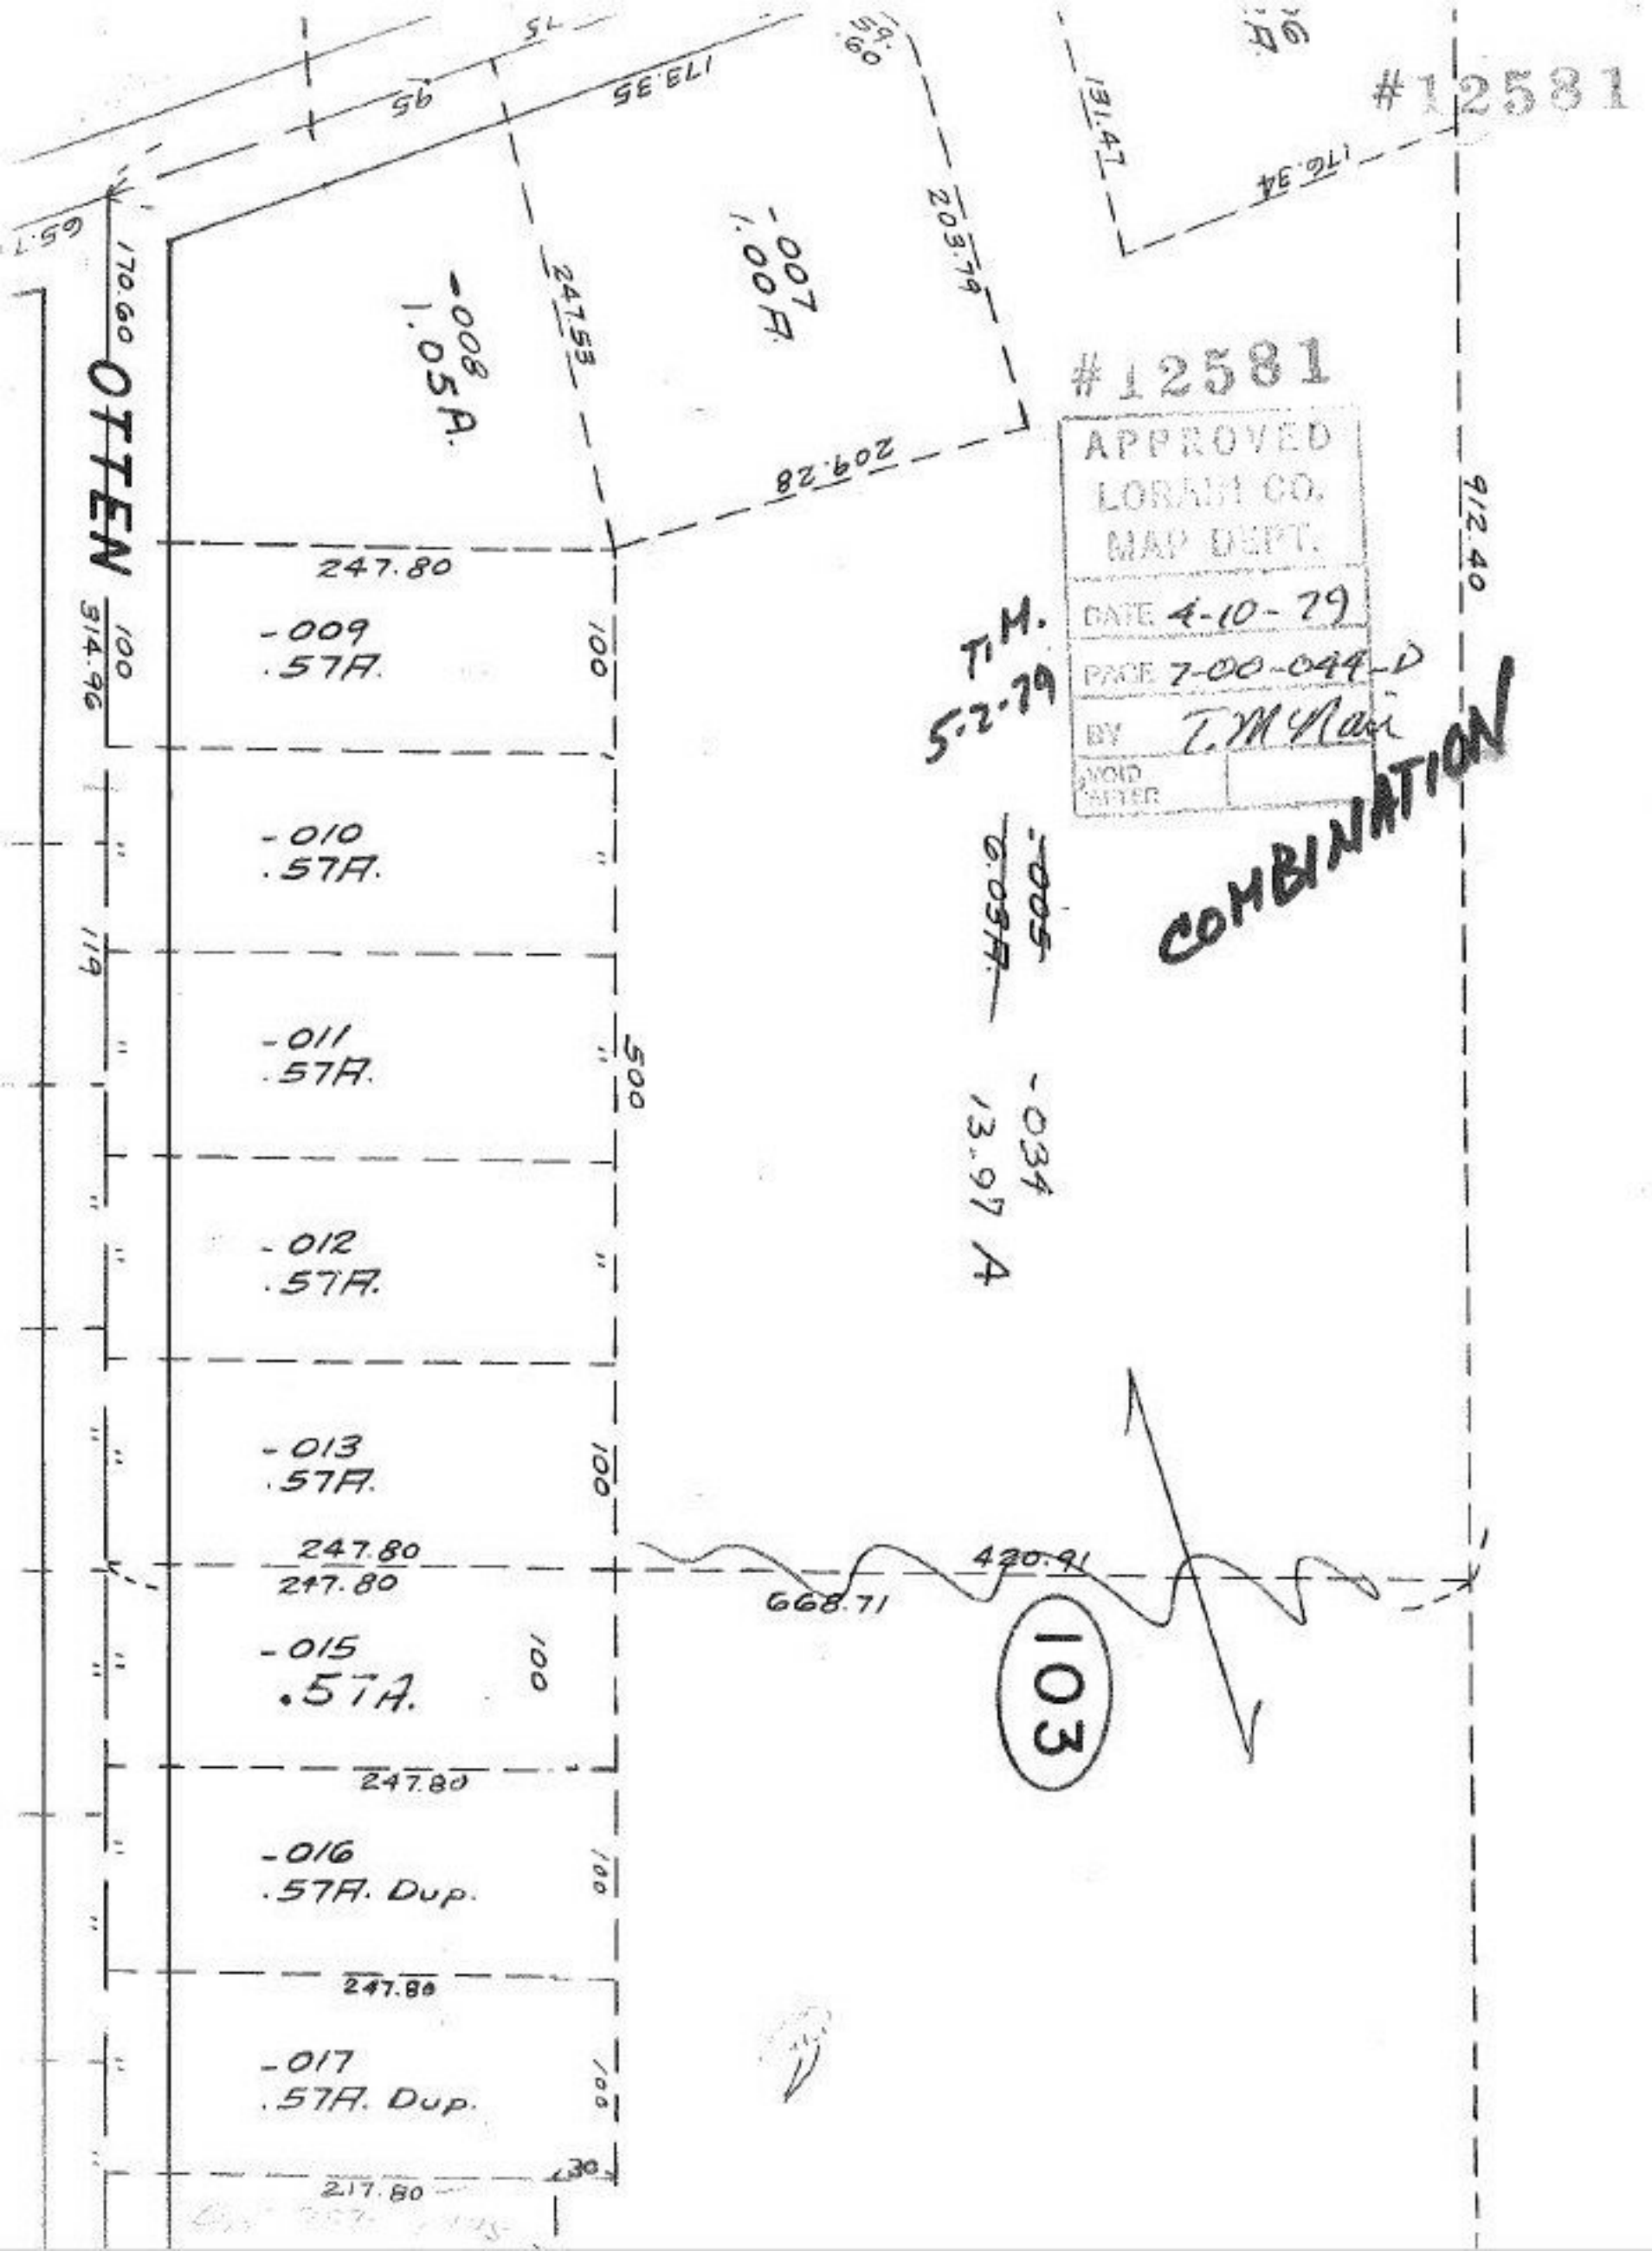

OTTEN

-008
1.05A.

-007
1.00A.

-009
.57A.

-010
.57A.

-011
.57A.

-012
.57A.

-013
.57A.

-015
.57A.

-016
.57A. Dup.

-017
.57A. Dup.

103

217.80