


#12584

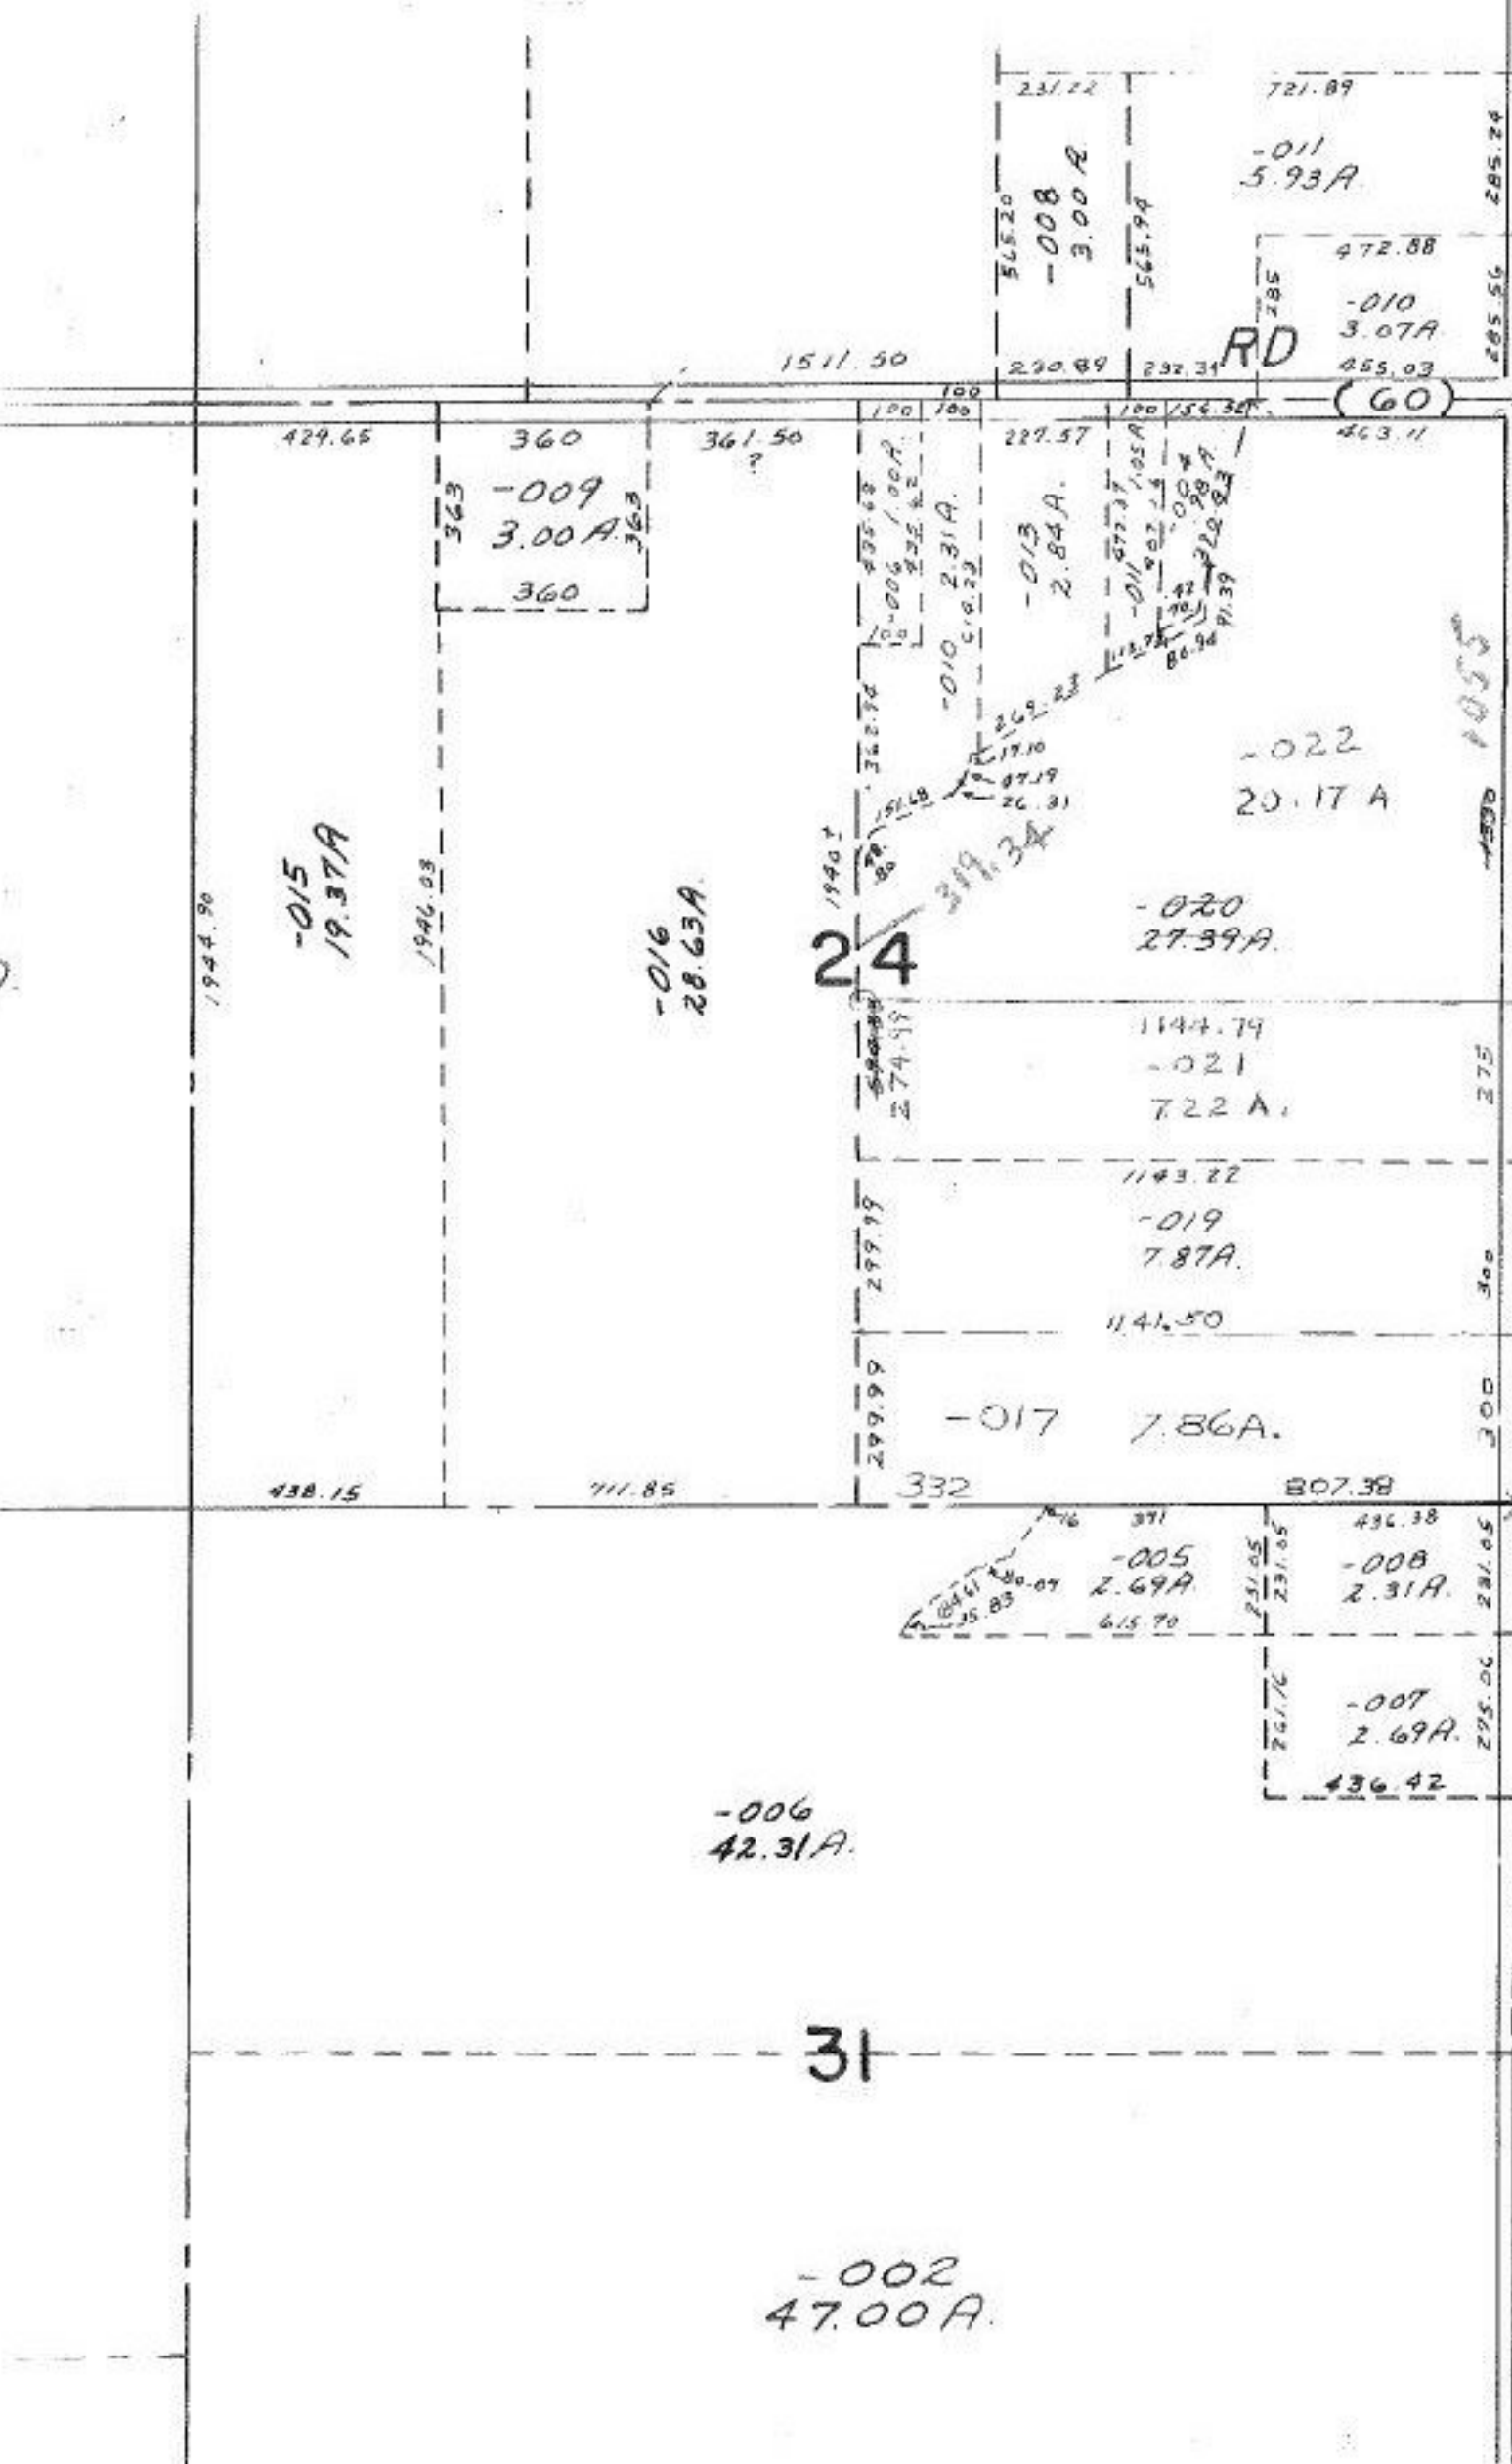

574.33
 274.99
 319.34

137.0
 27.0
 145.5

1646.30

56 Corner

#12584

| | |
|-------------------------------------|-----------|
| APPROVED LORAIN CO, MAP DEPT. | |
| DATE | 4-11-79 |
| PAGE | 13-G |
| BY | Carolyn F |
| VOID AFTER | 12584 |

C-F
 4-23-79