


SEE 2-03-001-A

#12598

ALSO NEED  
TO CHANGE  
PARCEL #  
ACREAGE ON  
THIS PAGE.

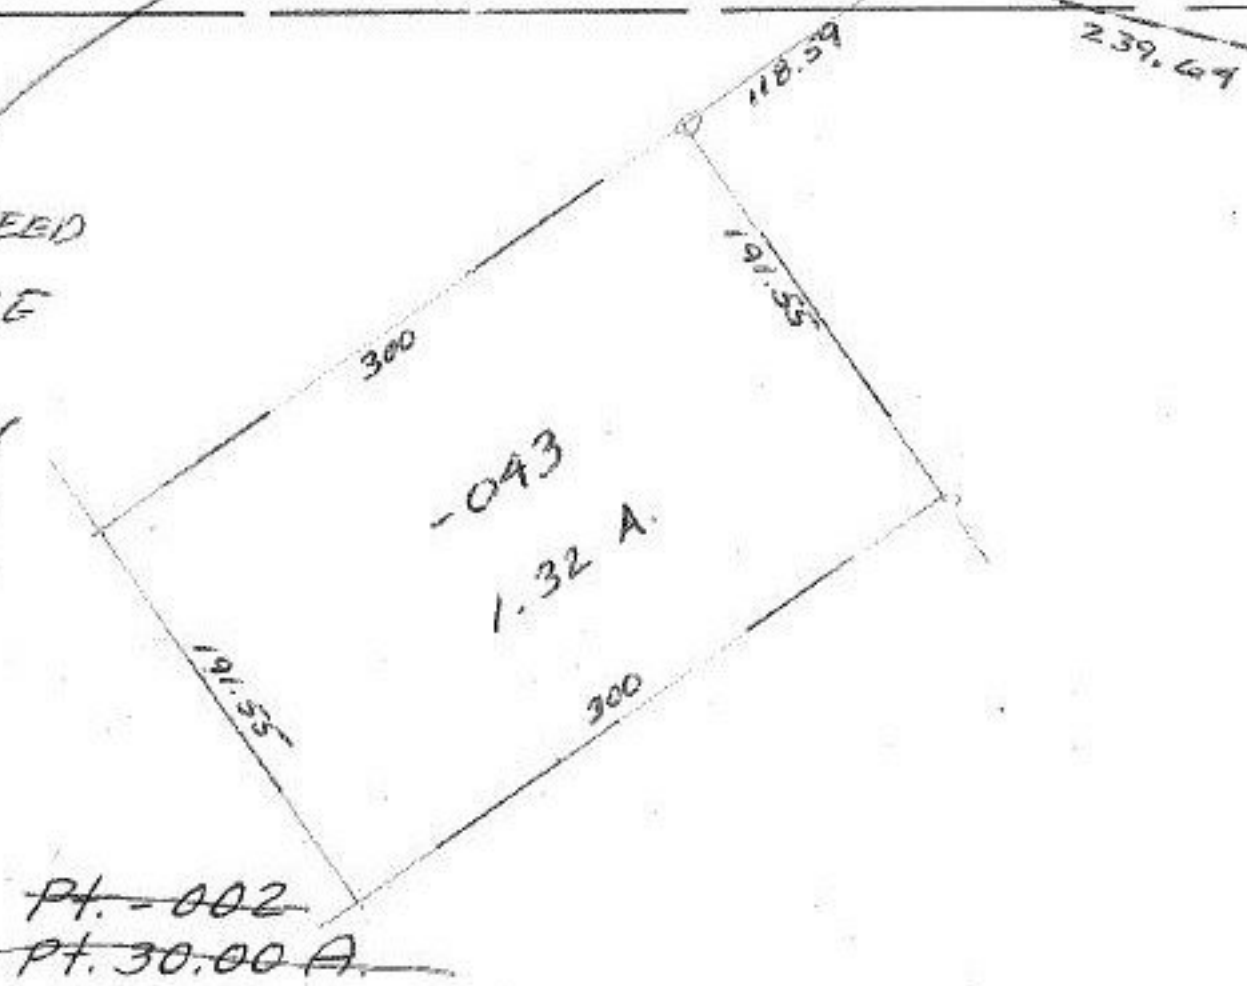

~~Pt. -002~~  
~~Pt. 30.00 A.~~

Pt. -044

Pt. 28.68

#12598

APPROVED	
LORAIN CO.	
MAP DEPT.	
DATE	
PAGE	2-03-001-A
PAGE	2-03-001-e
BY	T. M. Nain
VOID AFTER	07

$$\begin{array}{r} 30.00 \\ 1.32 \\ \hline 28.68 \end{array}$$

6-14-79

103

742.61

955

594.68

230.34

60 RD.

899.65

312.69

