

19-019	36
20-020	35
21-021	34-062
22	33-047
23-022	32-048
24-023	31-049
25	30
26-024	29-063
27-025	28

73	89
74-057	88-052
75-020	87-044
76-021	86-045
77-022	85-055
78-023	84-056
79-024	83-049
80-025	82-050
81-026	81-051

122-01
123-01
124-01
125
126-05
127
128-05
129-02

**IVANHOE**

1-001	52
2-002	51-051
3-003	50-062
4-061	49
5	48
6	47-029
7-006	46-030
8-007	45-060
9-008	44
10	43
11-009	42-057
12-010	41-035
13-011	40-036
14-012	39-037
15	38
16-013	37-052
17-014	36
18-015	35-056
19-016	34
20-017	33-054
21	32-044
22	31-045

53	101
54-057	100-059
55	99
56-056	98-060
57	97-031
58-066	96
59	95
60-067	94-047
61	93-048
62-058	92
63-052	91-061
64	90
65	89-050
66-064	88
67	87-039
68-063	86-040
69	85-041
70-053	84
71	83-054
72-062	82
73-021	81
74-022	80

102-00
103
104-0
105-0
106-0
107-0
108-0
109
110-0
111
112
113-0
114
115-0
116
117
118
119
120



#12625

APPROVED  
LORAIN CO.  
MAP DEPT.  
DATE 5-24-72  
PAGE 3-00-038B  
BY *J. Colburn*  
VOID AFTER

JUN 15 1979



SEE 3-00-039-B

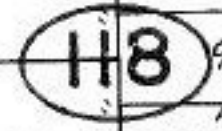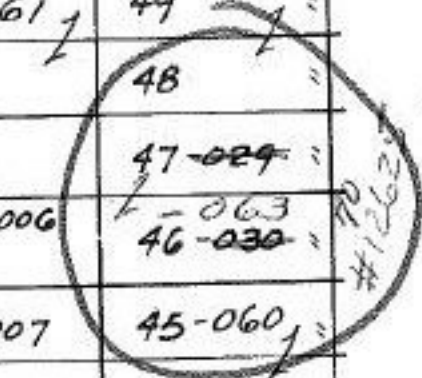

H

S