

#12627

JUN 15 1979

APPROVED
LORAIN CO.
MAP DEPT.

DATE 5-24-79

PAGE 3-00-039 B


BY *J. Hall*

VOID
AFTER

SEE 3-00-039-A

HELIEU

| | | | | | | | | | | | | | | | | | | | | | | | |
|--------------|----|------|----|--------------|----|------|----|---------------|----|------|----|---------------|----|----|----|---------------|----|----|----|---------------|----|----|----|
| 100 7-027 | 35 | 50 | 35 | 100 8-026 | 35 | 50 | 35 | 100 10-001 | 35 | 50 | 35 | 100 11-027 | 35 | 50 | 35 | 100 12-053 | 35 | 50 | 35 | 100 13-070 | 35 | 50 | 35 |
| 24-028 | | AVE. | | 23-061 | | AVE. | | 21-002 | | AVE. | | 20-028 | | | | 19 | | | | 18-070 | | | |
| 36-029 | | | | 37-003 | | | | 39 | | | | 40-063 | | | | 41-003 | | | | 42- | | | |
| 53-030 | | | | 52-004 | | | | 50-064 | | | | 49 | | | | 48-004 | | | | 47 | | | |
| 66-031 | | | | 67-005 | | | | 69-005 | | | | 70-031 | | | | 71 | | | | 72-058 | | | |
| 96-057 | | | | 82-006 | | | | 80-006 | | | | 79-032 | | | | 78-060 | | | | 77 | | | |
| 96-057 | | | | 97-007 | | | | 99-062 | | | | 100-033 | | | | 101 | | | | 102-059 | | | |
| 113-034 | | | | 112 | | | | 110 | | | | 109-034 | | | | 108-066 | | | | 107-033 | | | |
| 126-035 | | | | 127-008 | | | | 129-009 | | | | 130-035 | | | | 131-063 | | | | 132-034 | | | |
| 143-036 | | | | 142-009 | | | | 140 | | | | 139-036 | | | | 138 | | | | 137-035 | | | |
| 156-037 | | | | 157-010 | | | | 159-065 | | | | 160-054 | | | | 161-064 | | | | 162-036 | | | |
| 173-033 | | | | 172 | | | | 170 | | | | 169 | | | | 168 | | | | 167-037 | | | |
| 186-039 | | | | 187-057 | | | | 189-059 | | | | 190-039 | | | | 191-013 | | | | 192 | | | |
| 203 | | | | 202-013 | | | | 200 | | | | 199-040 | | | | 198 | | | | 197-06 | | | |
| 216 | | | | 217-014 | | | | 219-060 | | | | 220-041 | | | | 221 | | | | 222-040 | | | |
| 233-058 | | | | 232 | | | | 230 | | | | 229-042 | | | | 228-061 | | | | 227-05 | | | |
| 246-042 | | | | 247-059 | | | | 249-017 | | | | 250-043 | | | | 251-065 | | | | 252 | | | |
| 263-043 | | | | 262-017 | | | | 260-018 | | | | 259-055 | | | | 258 | | | | 257-0 | | | |
| 276-044 | | | | 277 | | | | 279-019 | | | | 280 | | | | 281-018 | | | | 282 | | | |
| 293-045 | | | | 292-054 | | | | 290 | | | | 289 | | | | 288-019 | | | | 287 | | | |
| 306-046 | | | | 307 | | | | 309-056 | | | | 310-058 | | | | 311 | | | | 312-05 | | | |
| | | | | | | | | | | | | | | | | 318-067 | | | | 317-04 | | | |

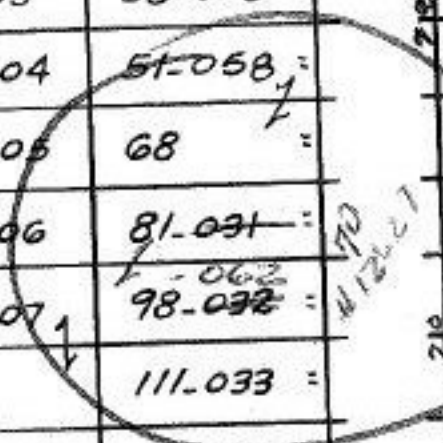

111

112

113

114

B

B

B

B