


#12632

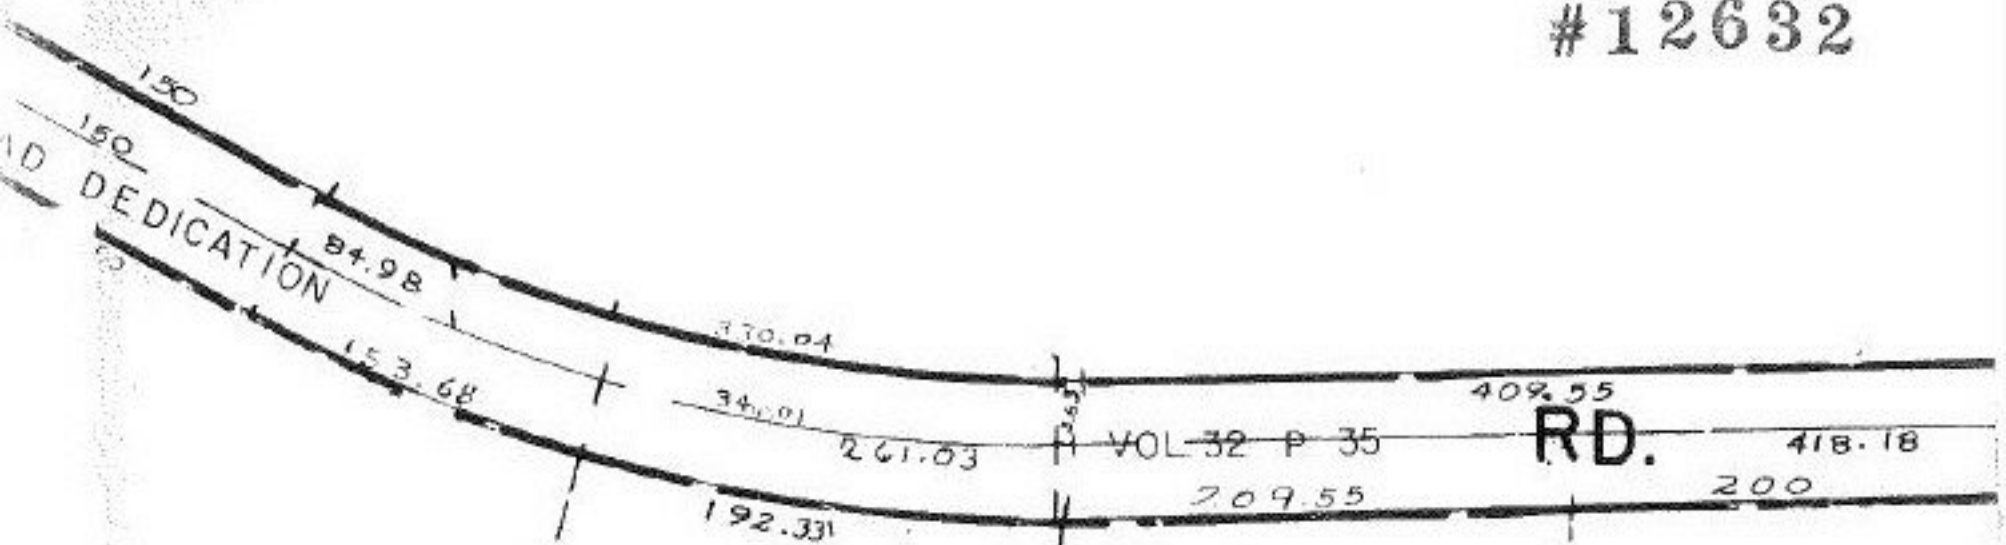

#12632

APPROVED	
LORAIN CO.	
MAP DEPT.	
DATE 4-25-79	
PAGE 13-00-044	
BY Carolyn F	
VOID AFTER	12632

OCT 13 1979

[Signature]

-057
9.56 A.

-055
79.51A.

JUST TOOK OUT HOOK.

-056
9.95A

-034
5.82 A.

126

1592

967

900

