
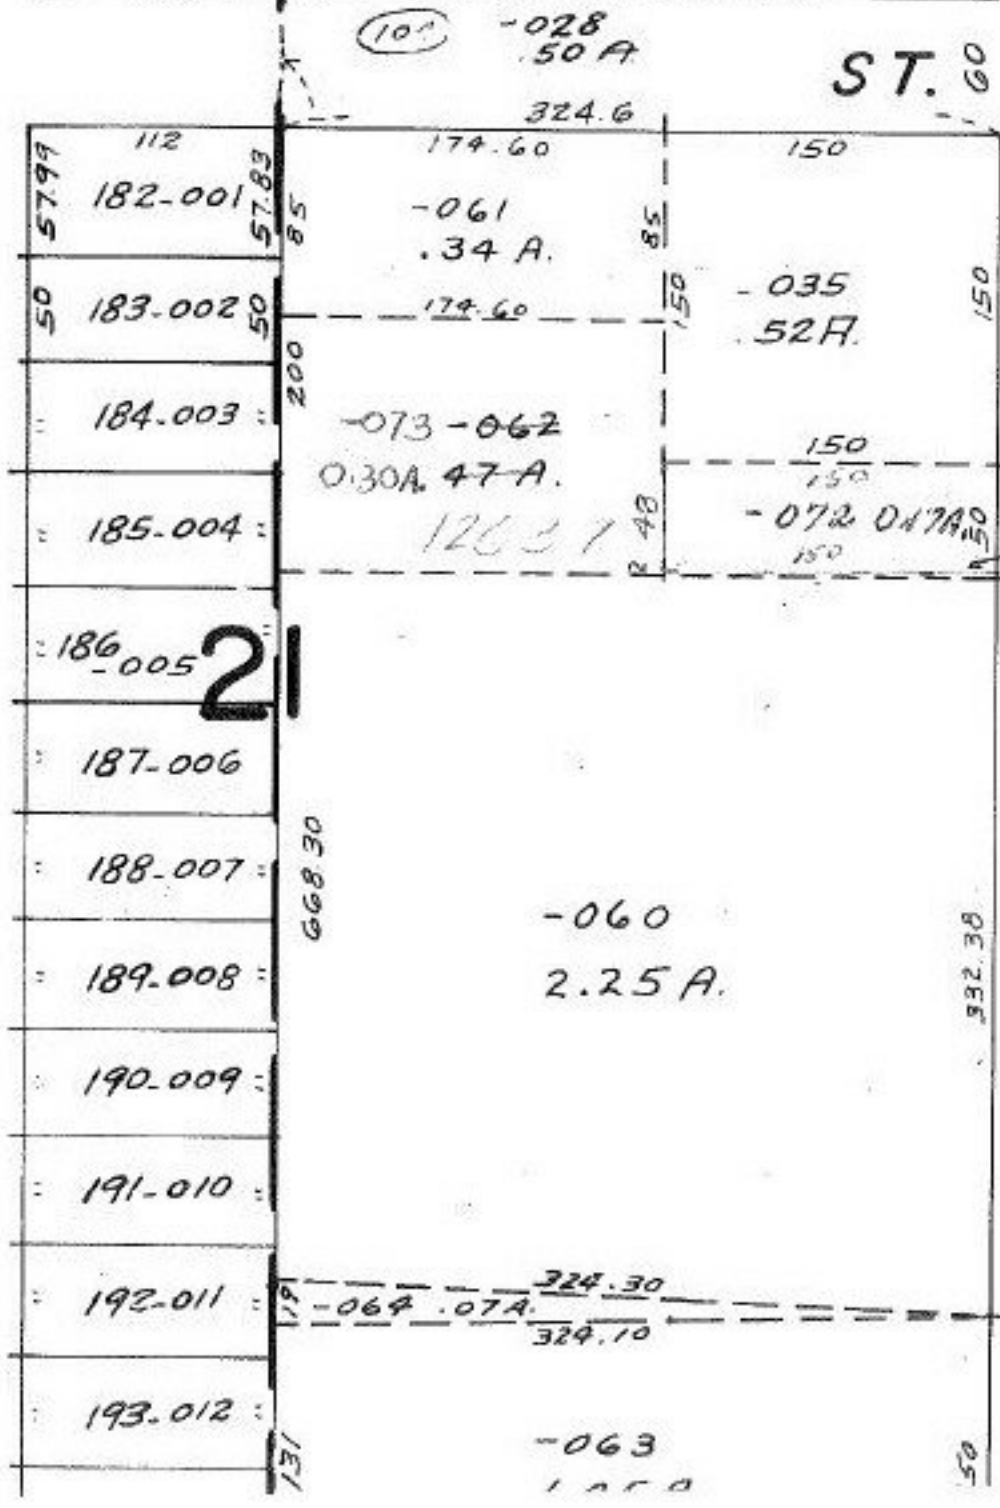
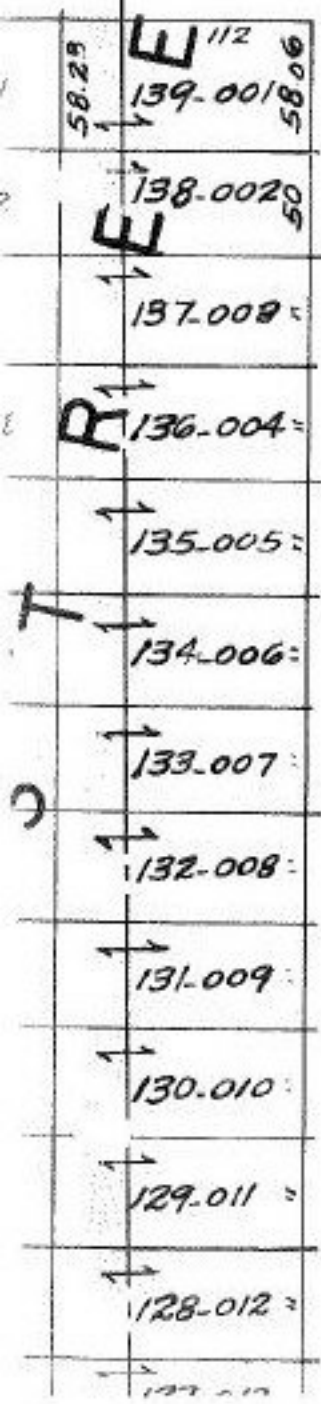


#12637

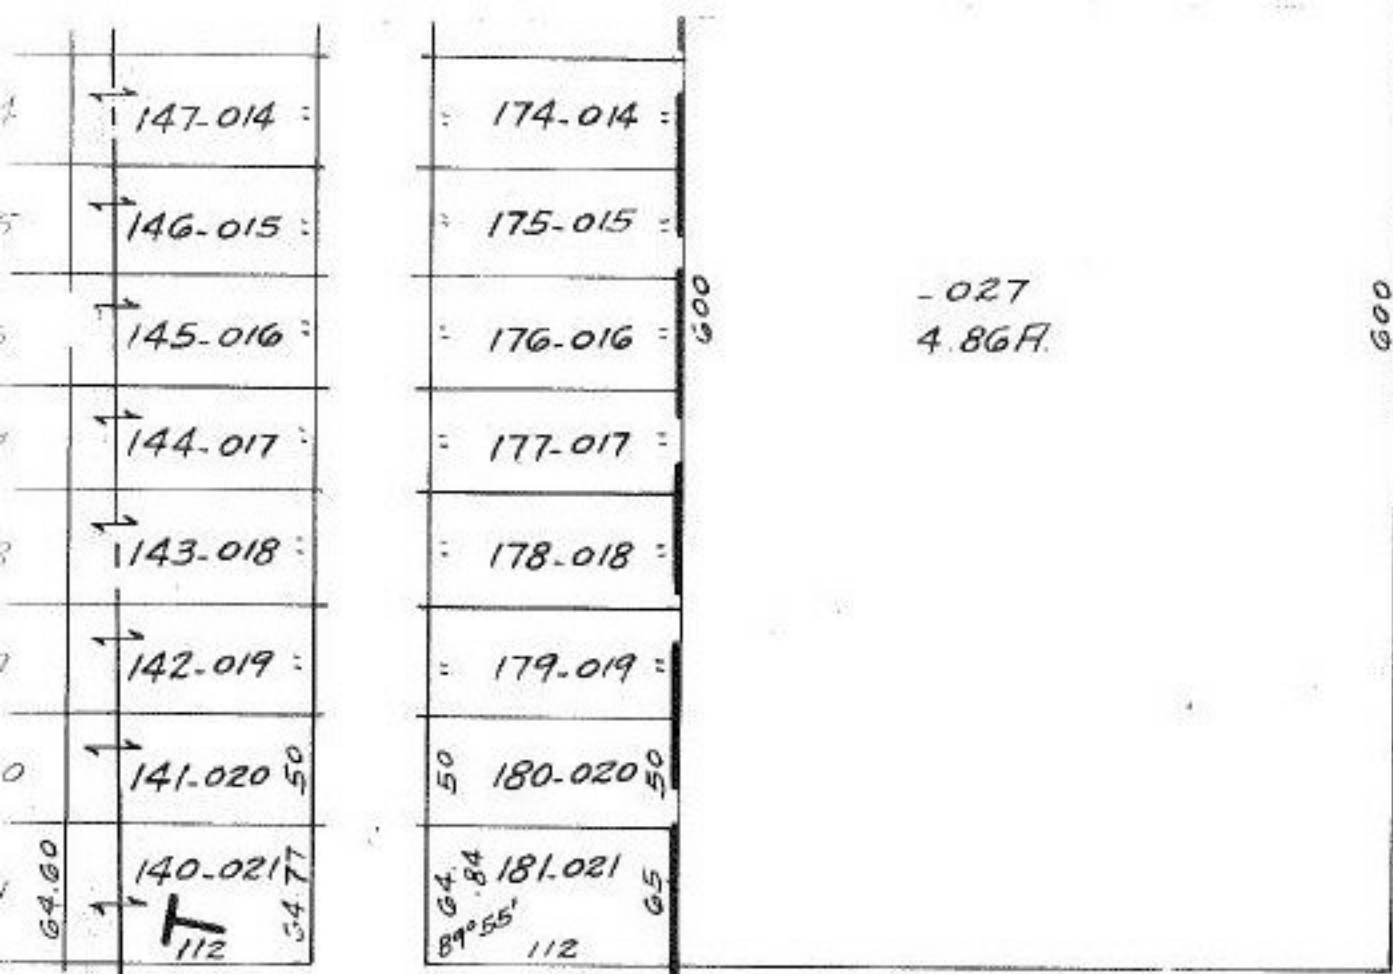

SEE 6-89

Draw this line in.  
LEAVE A  
2' STRIP.

#12637

APPROVED LORAIN CO. MAP DEPT.	
DATE	4-25-79
PAGE	6-88
BY	Carlynn F.
VOID AFTER	12637

C.F. 6-6-79