

JUN 15 1979

[Handwritten signature]

#12648

APPROVED,
LORAIN CO.
MAP DEPT.


DATE 4-30-7

PAGE 300-029-B

BY *[Handwritten signature]*

VOID
AFTER

SEE 3-G

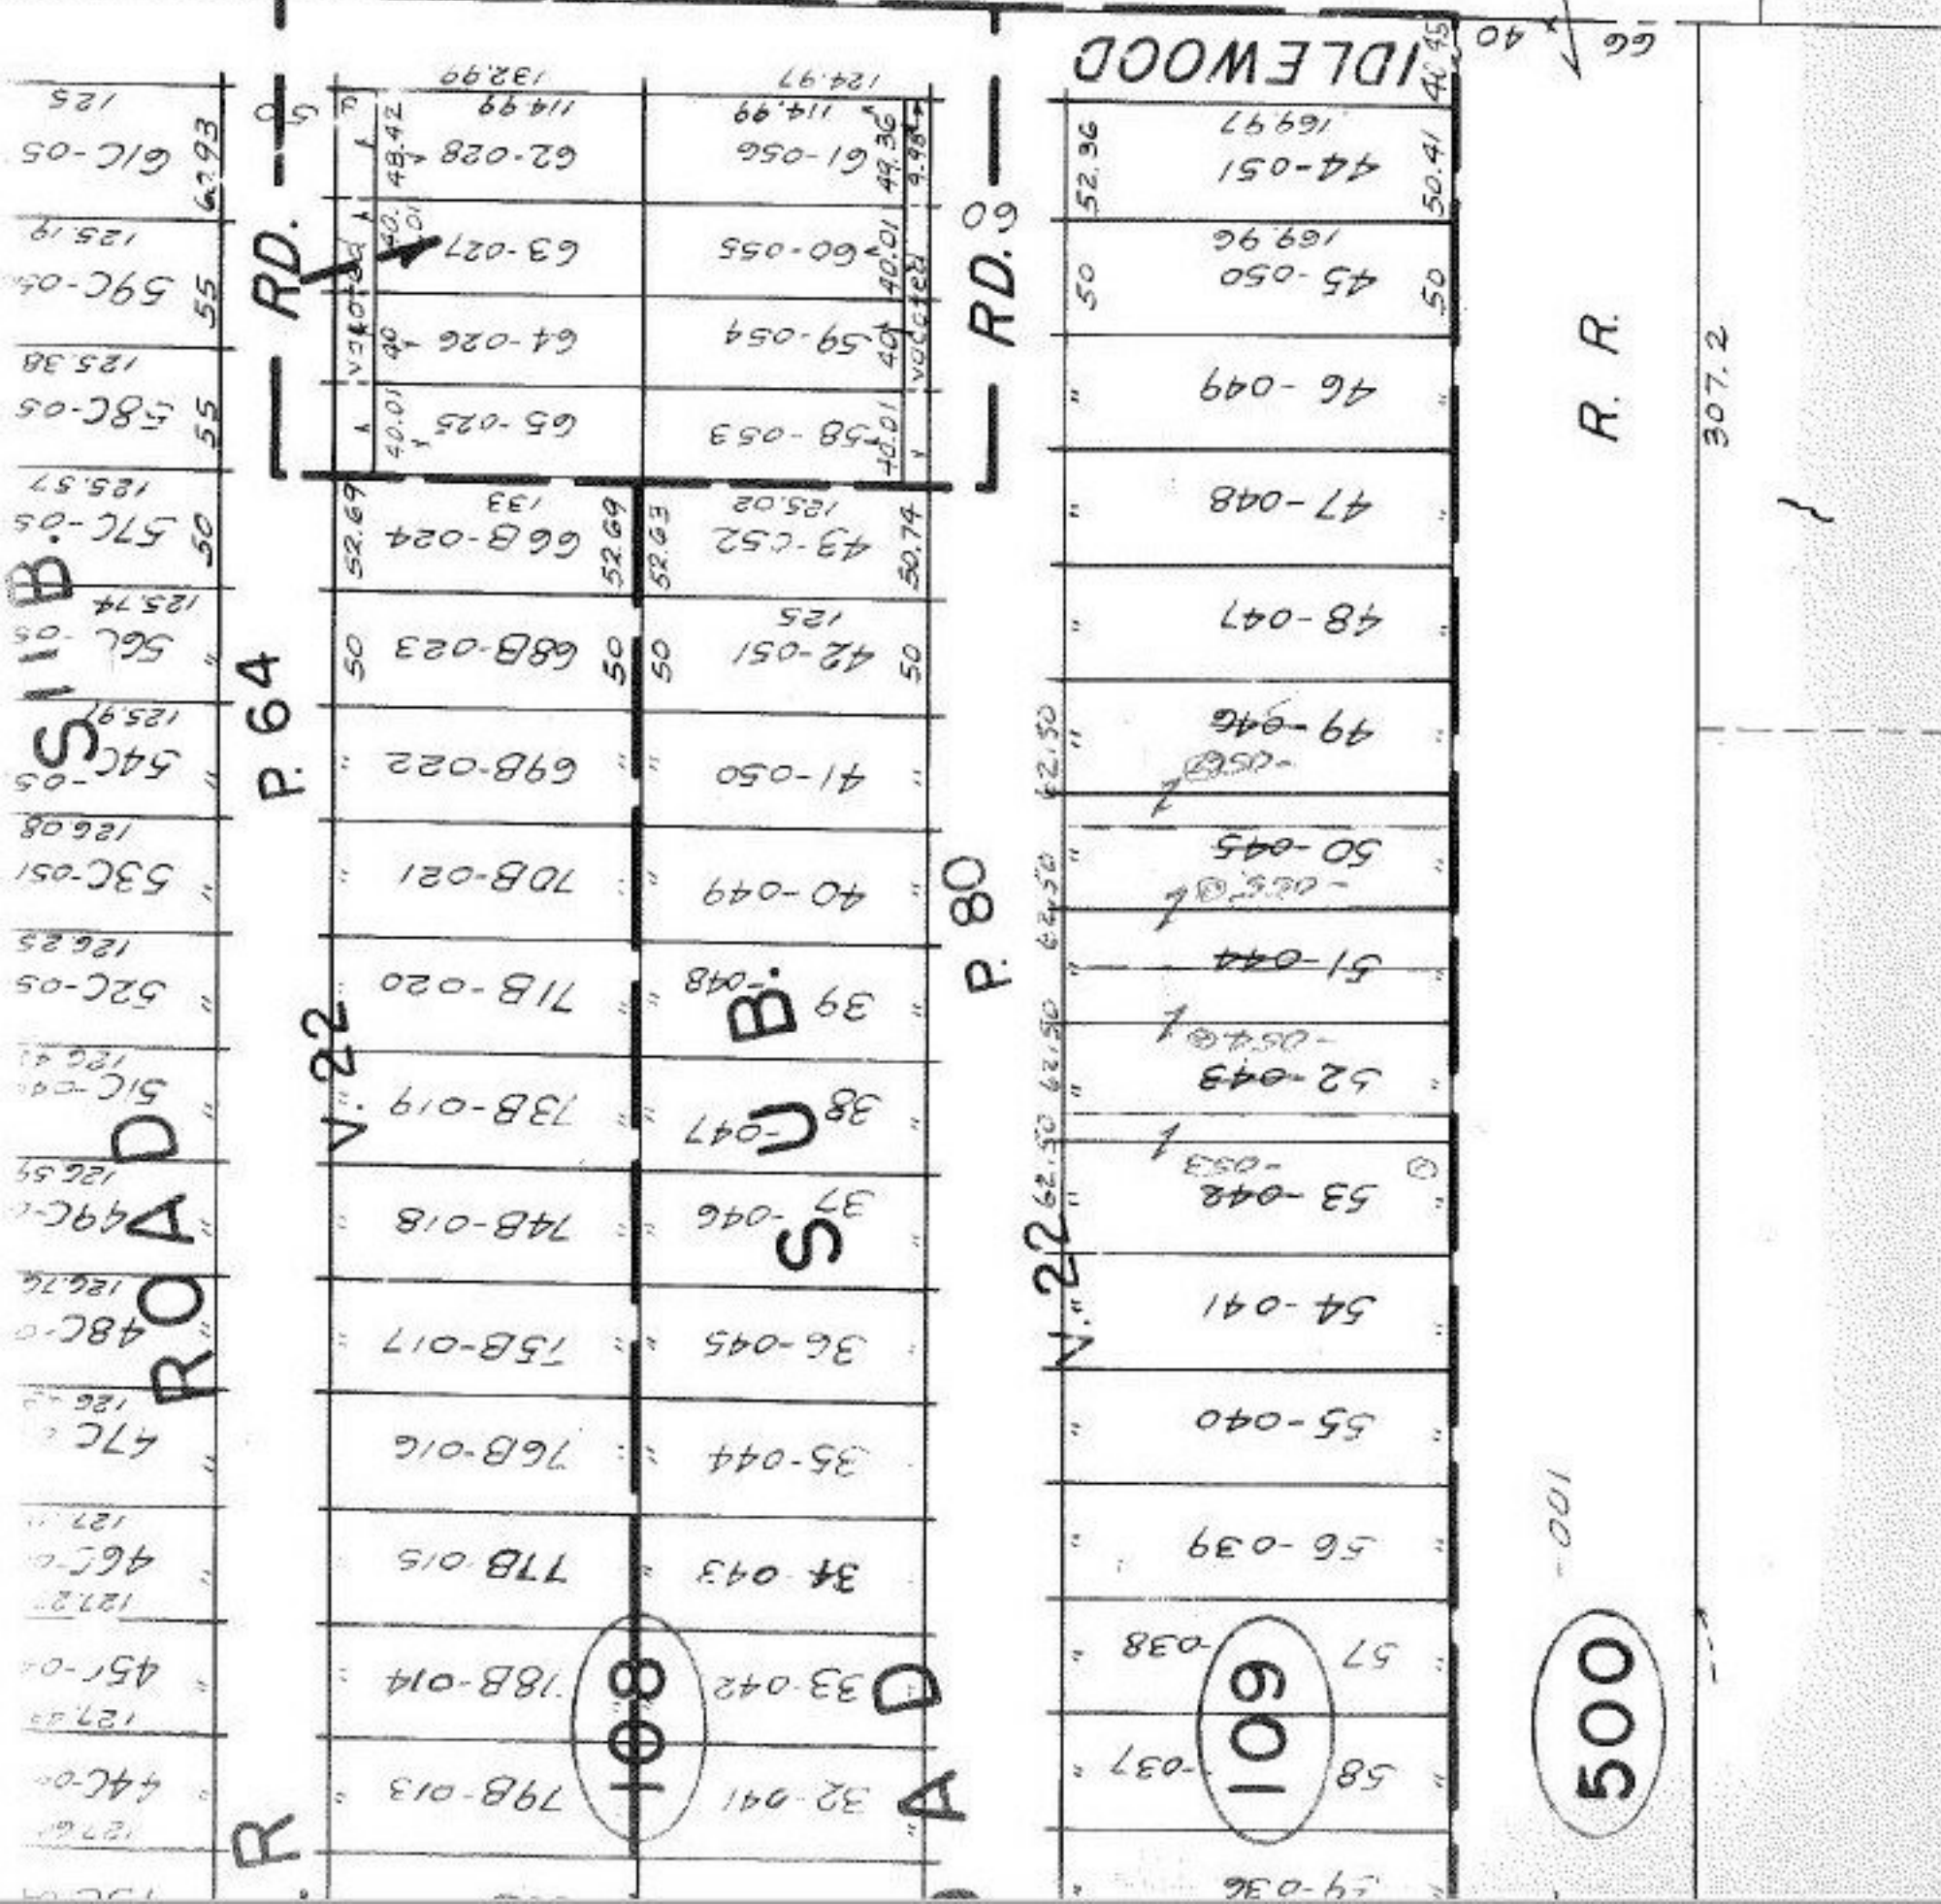

RD. 60

RD. 60

P. 64

P. 80

R.

500

109

100

R. R.

307.2

100

IDLEWOOD

RD. 64

V. 22

V. 22

SUB

ROAD

A

D

S

C

B

B

