


#12649

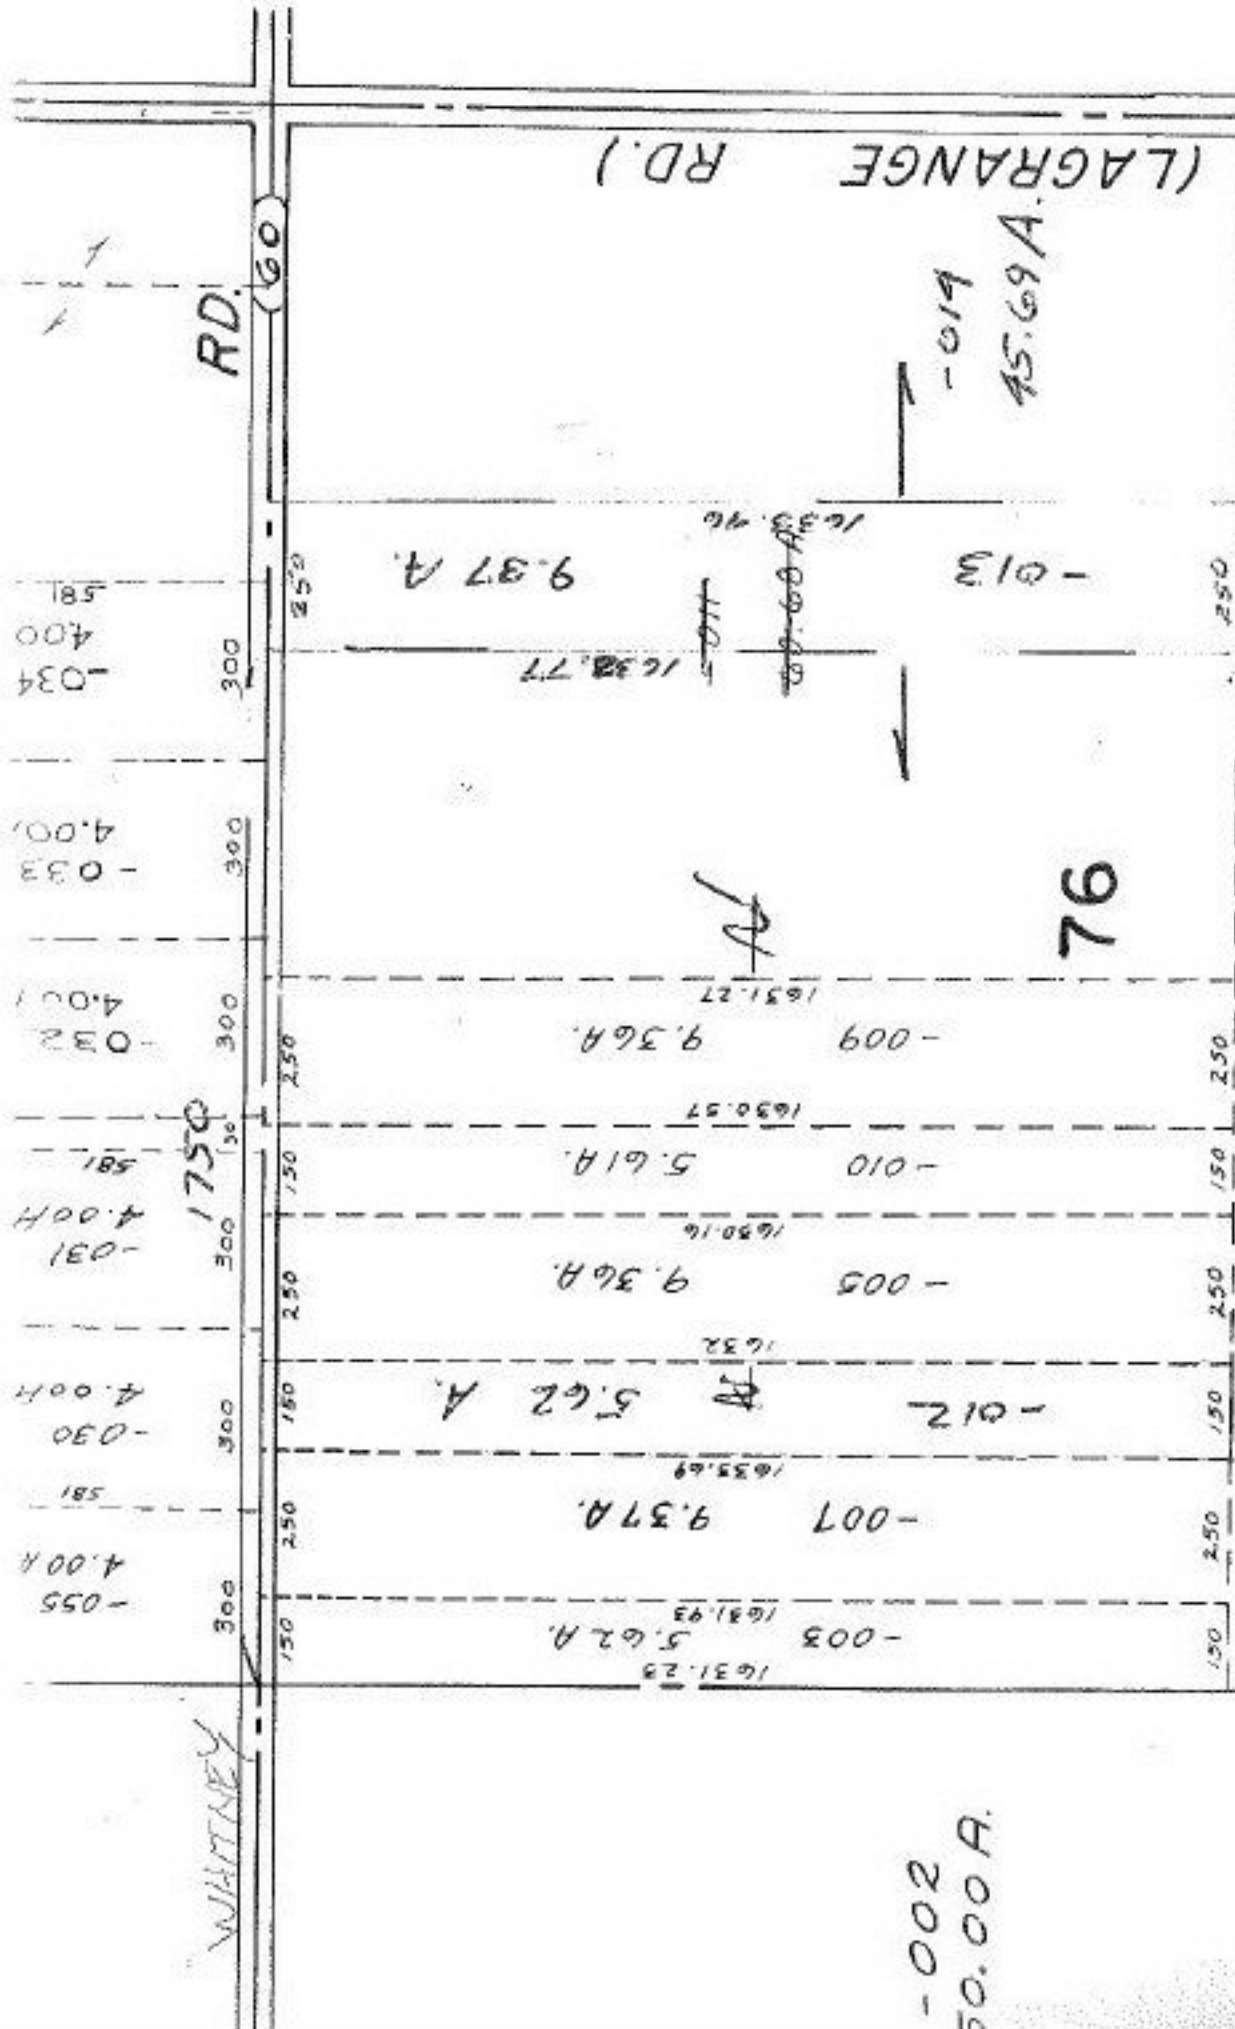

#12649

APPROVED	DATE 4-30-79
LORAIN CO.	PAGE 15-F
MAP DEPT.	BY T. McLaughlin
	VOID AFTER

OCT 19 1979

-002
66.66 A.

60.68
 5.62
 55.06
 9.37
 95.69
 93.7
 32.06

-002
50.00 A.