

45.69
5.62
40.07


60.18
5.62
55.06

2664

APPROVED
LORAIN CO.
MAP DEPT.
DATE 5-3-79
PAGE 15-F
BY J. Goddard
VOID AFTER

(LAGRANGE RD.)

RD.

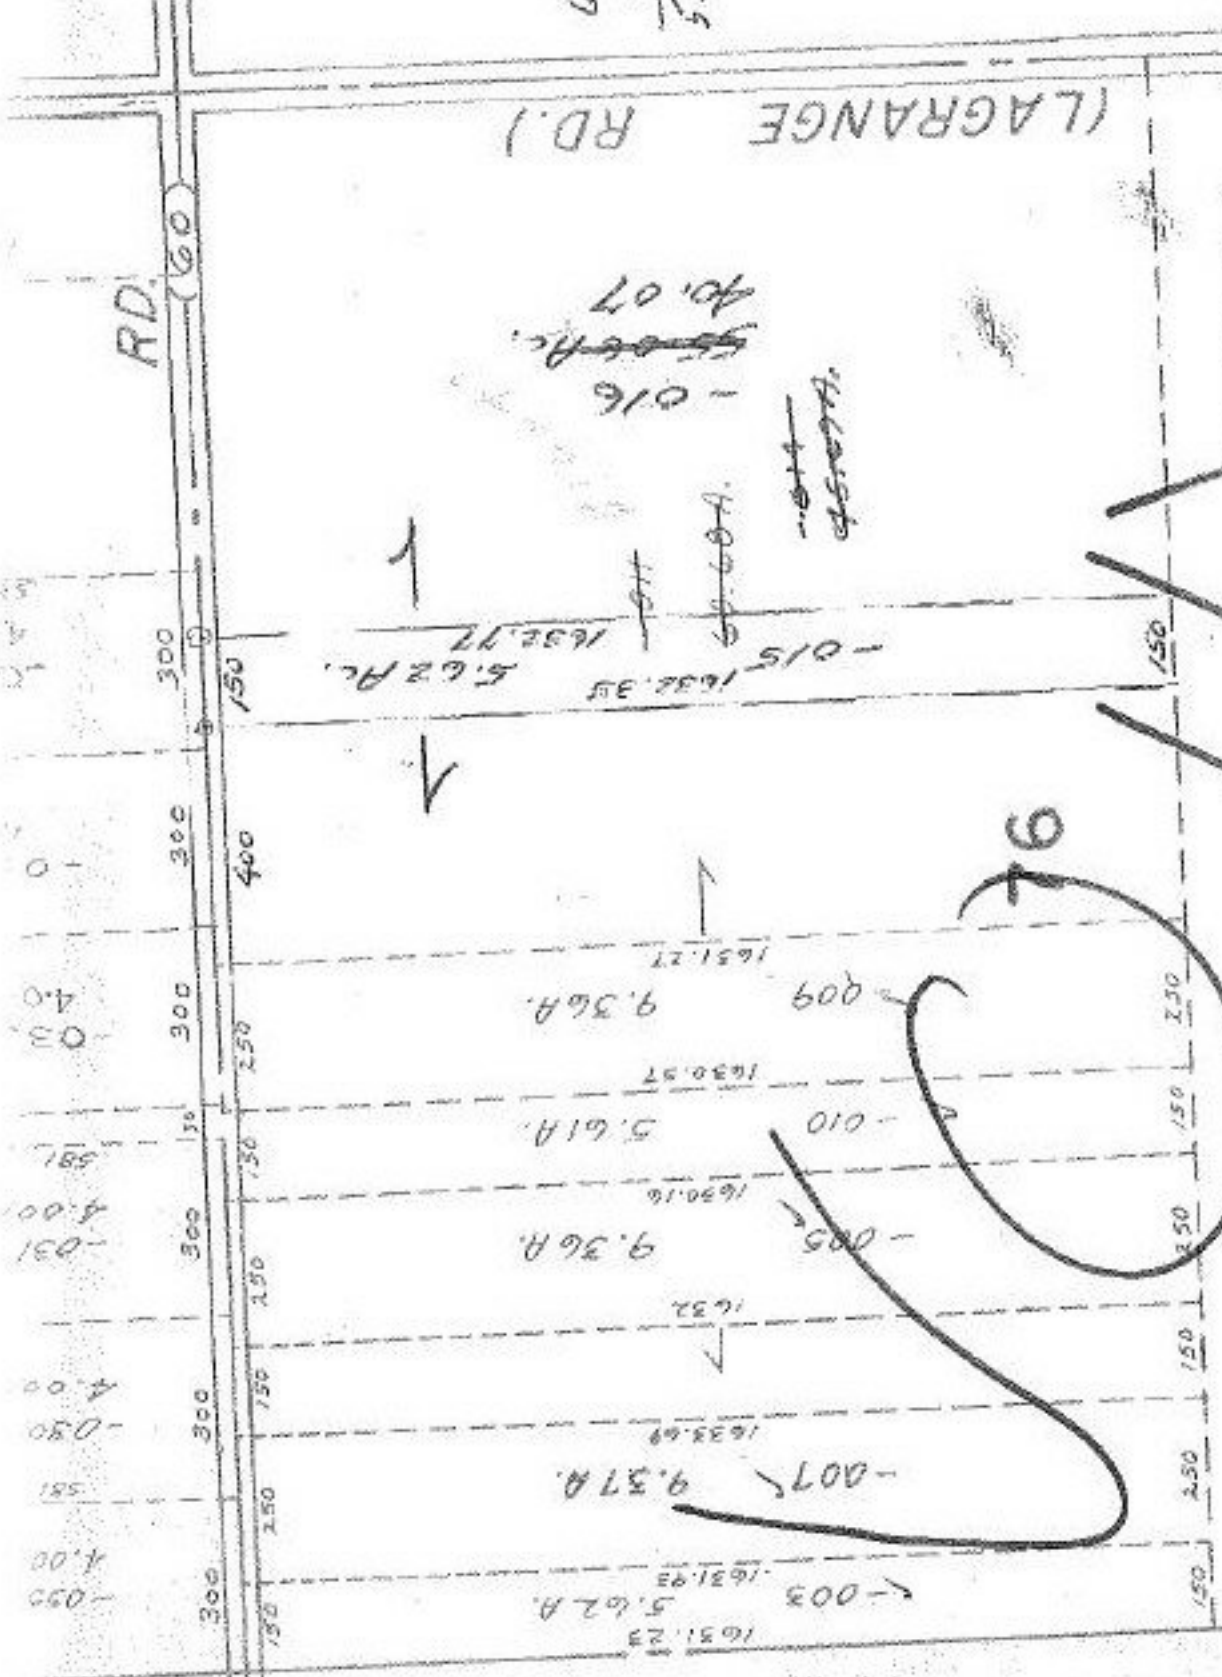

-012
013
-015

-002
66.66 A.

-002
50.00 A.