



-029
8.02 A.

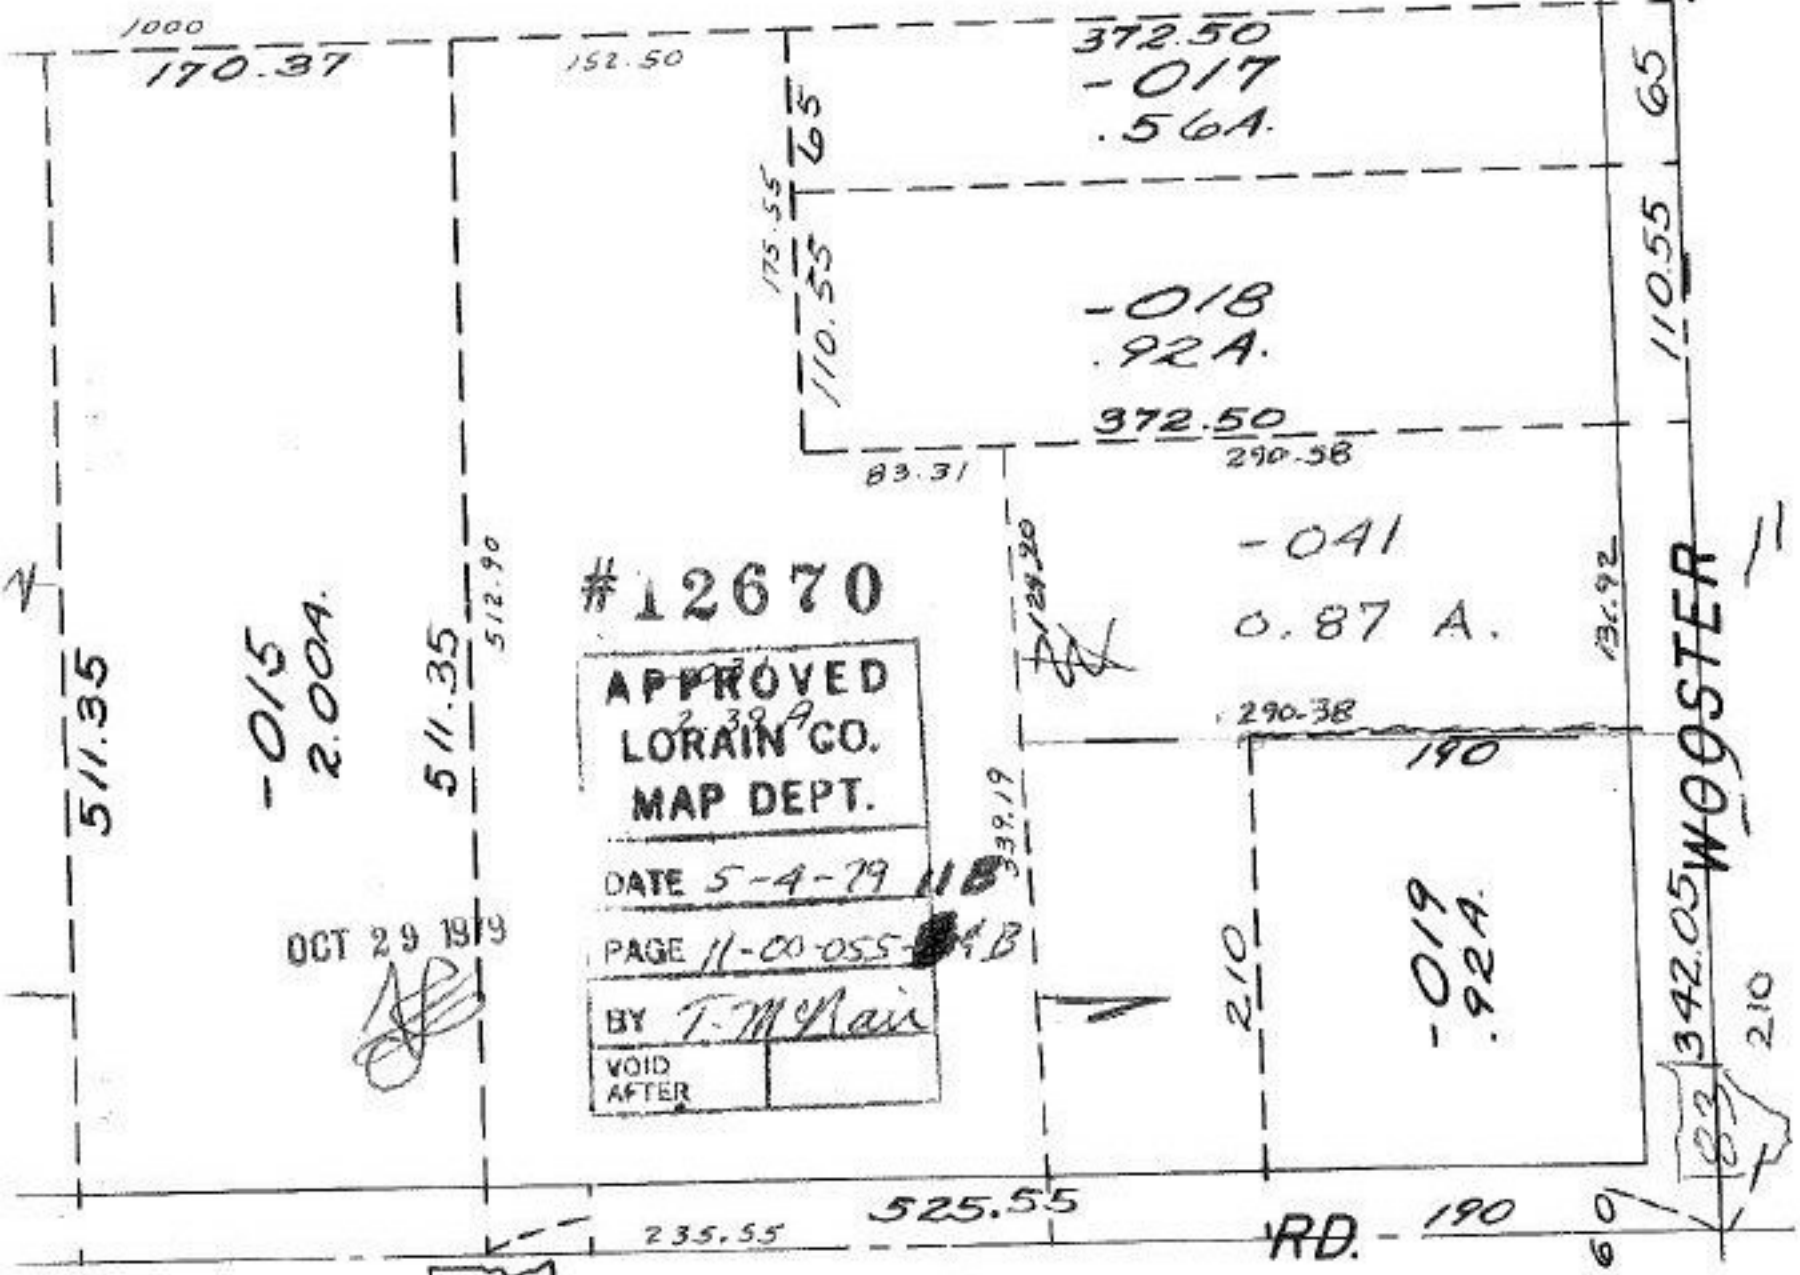

E 11-F

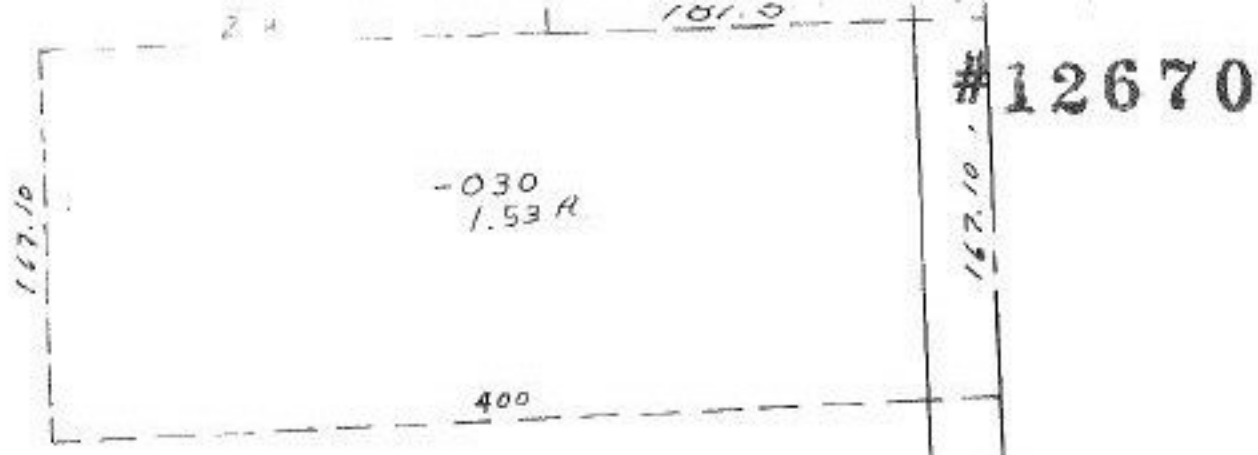