


#12676

-016
79.42 AC

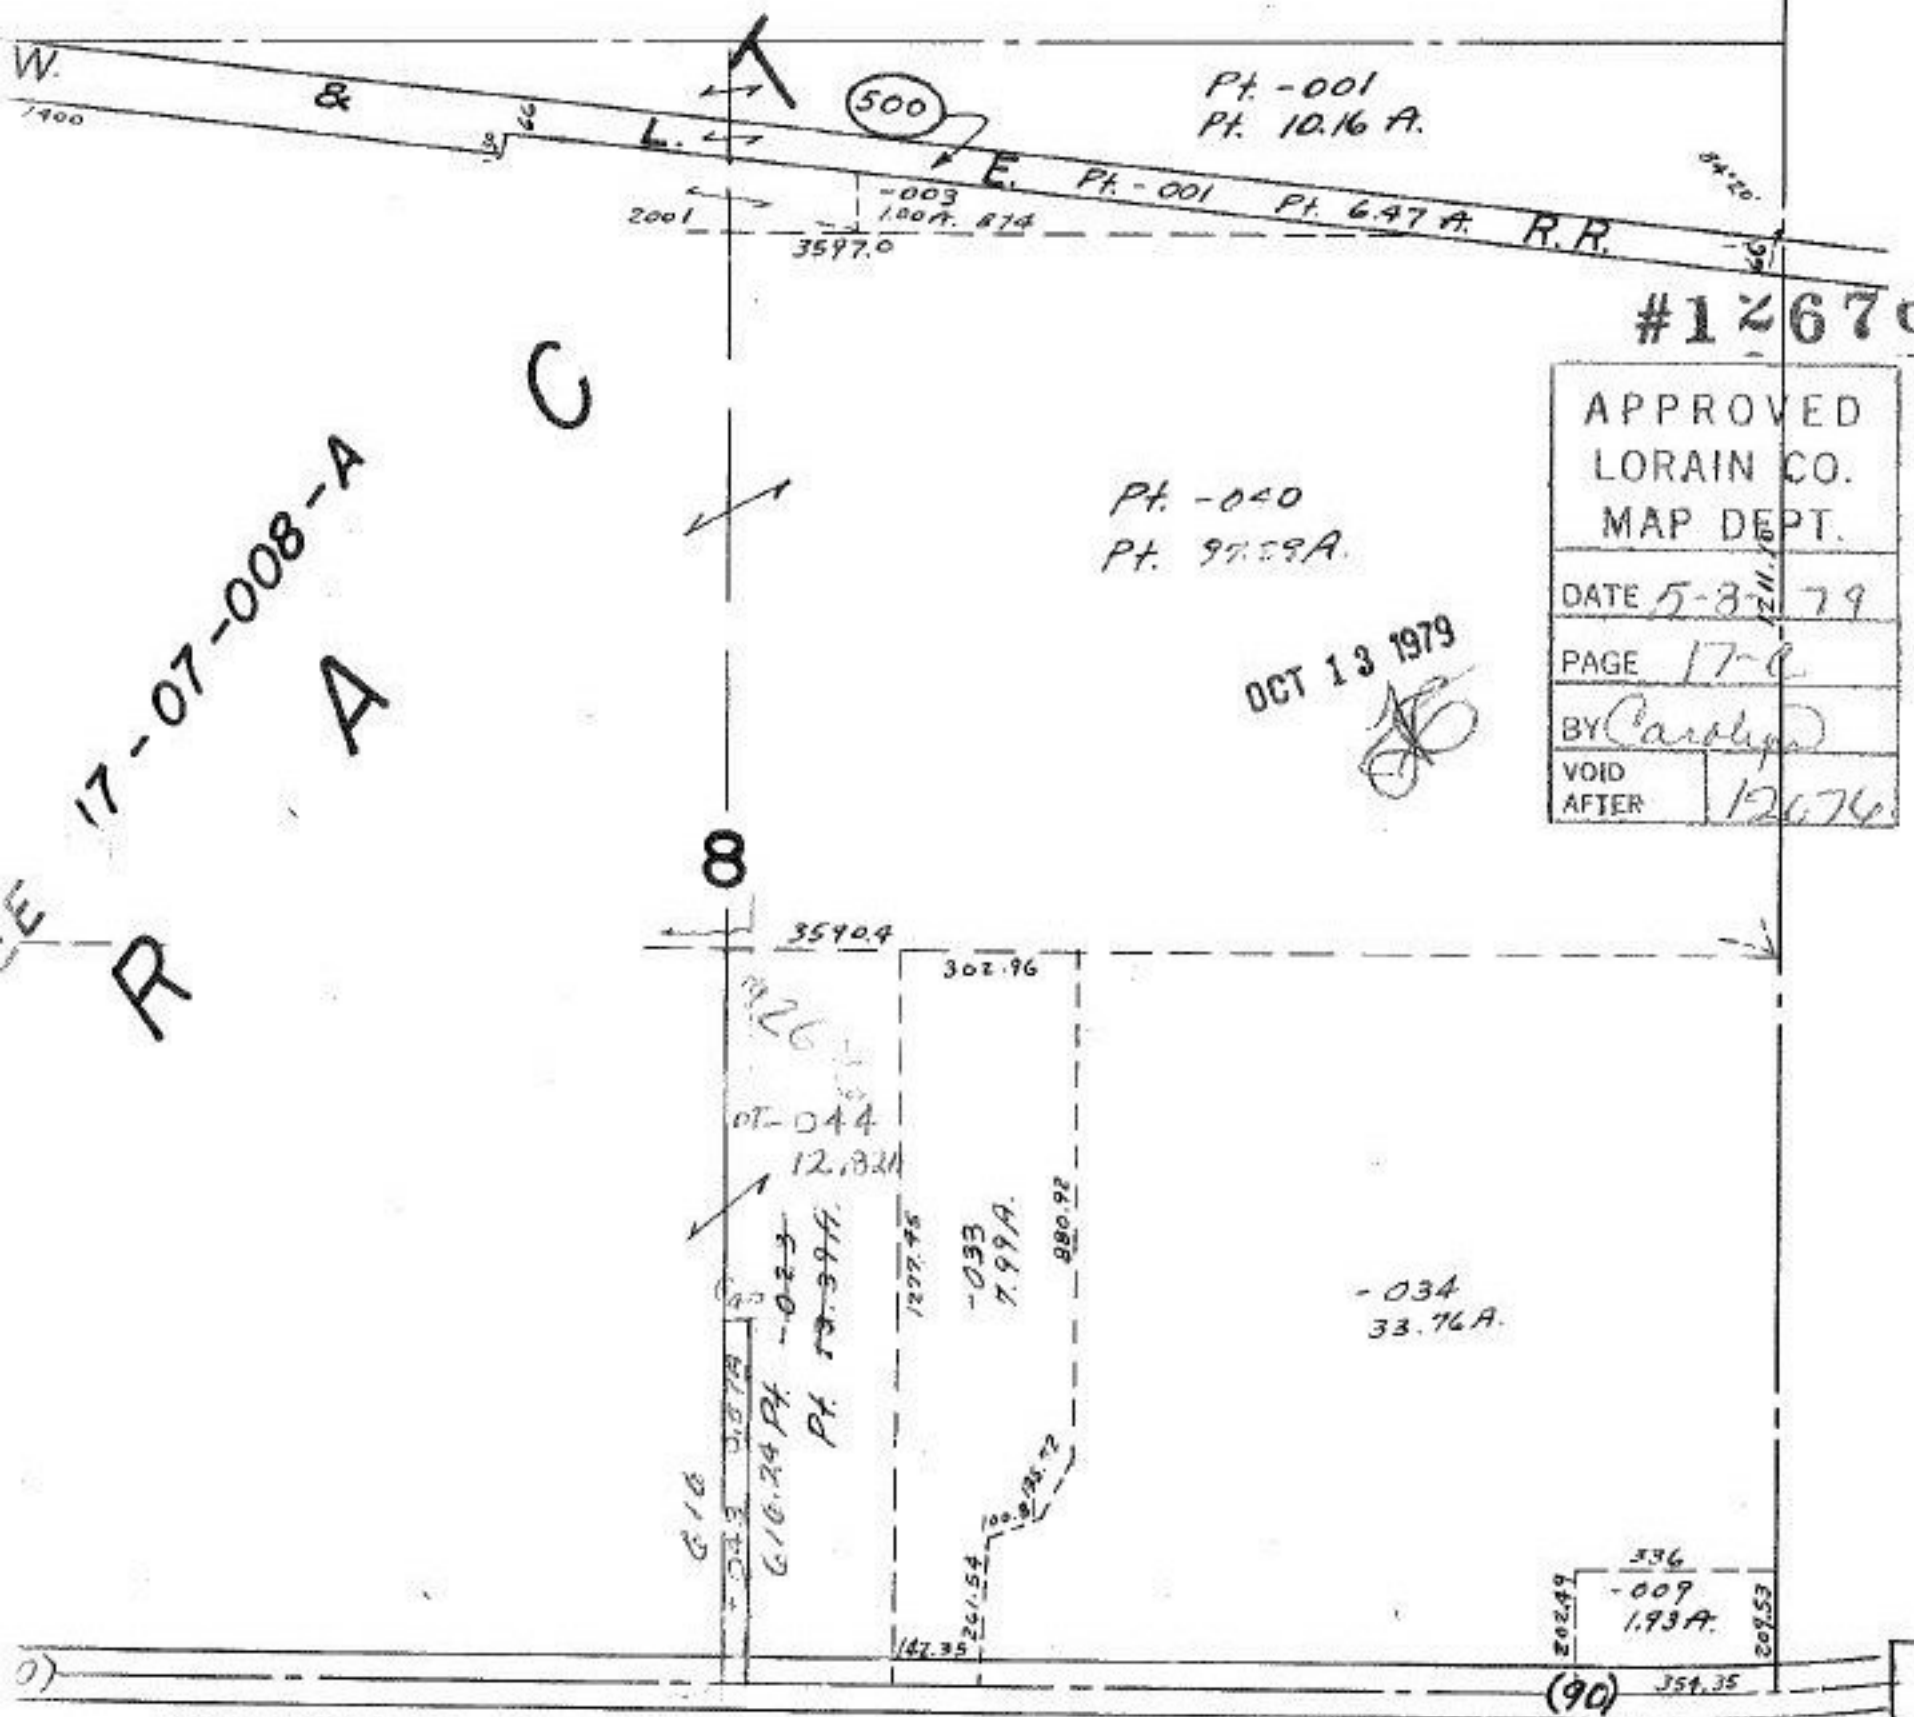

#12676

APPROVED	
LORAIN CO.	
MAP DEPT.	
DATE	5-8-79
PAGE	17-C
BY	Carolyn
VOID AFTER	12676

OCT 13 1979

17-07-008-A
A
R

C

8

18

- NORWALK

RD.

- WP.

TRACT 7 LOTS 3,
" 8 " 23,