

500

Pt. 6.47A

0.44A

110

500

R. R. 9

ST.

R. R.

#12681

TORRIS

PLAT

JEFFERSON

LA FAYETTE

N. LAKE

APPROVED
LORAIN CO.
MAP DEPT.

DATE 5-10-79


PAGE 500-003-13

2.4 R. R. 9

VOID AFTER 2691

12681-02

6-6-79

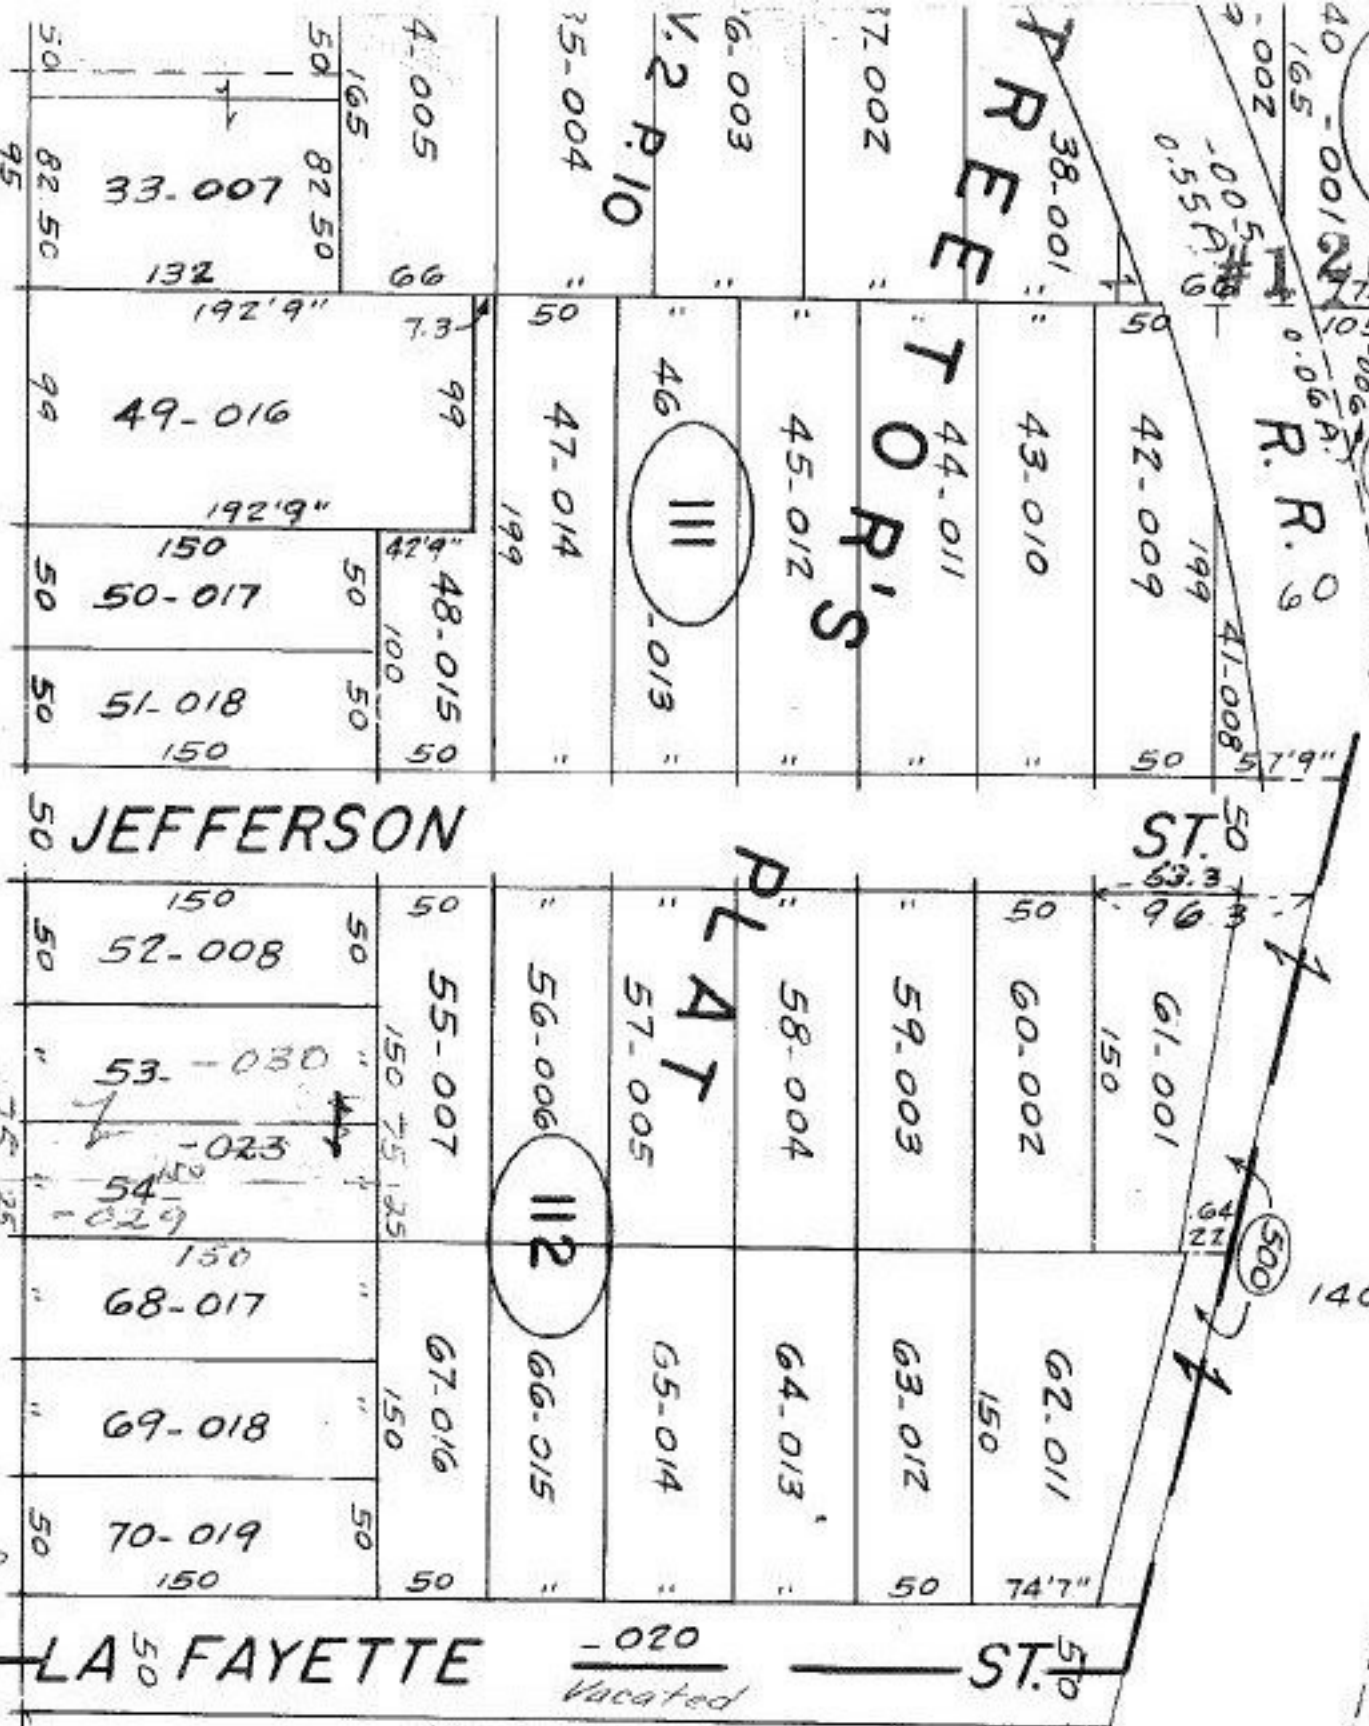

SEE 5-00-004-B

25X150
75X150

51 AVE.

112

112

112

112