


#12690

-016
79.42 AC

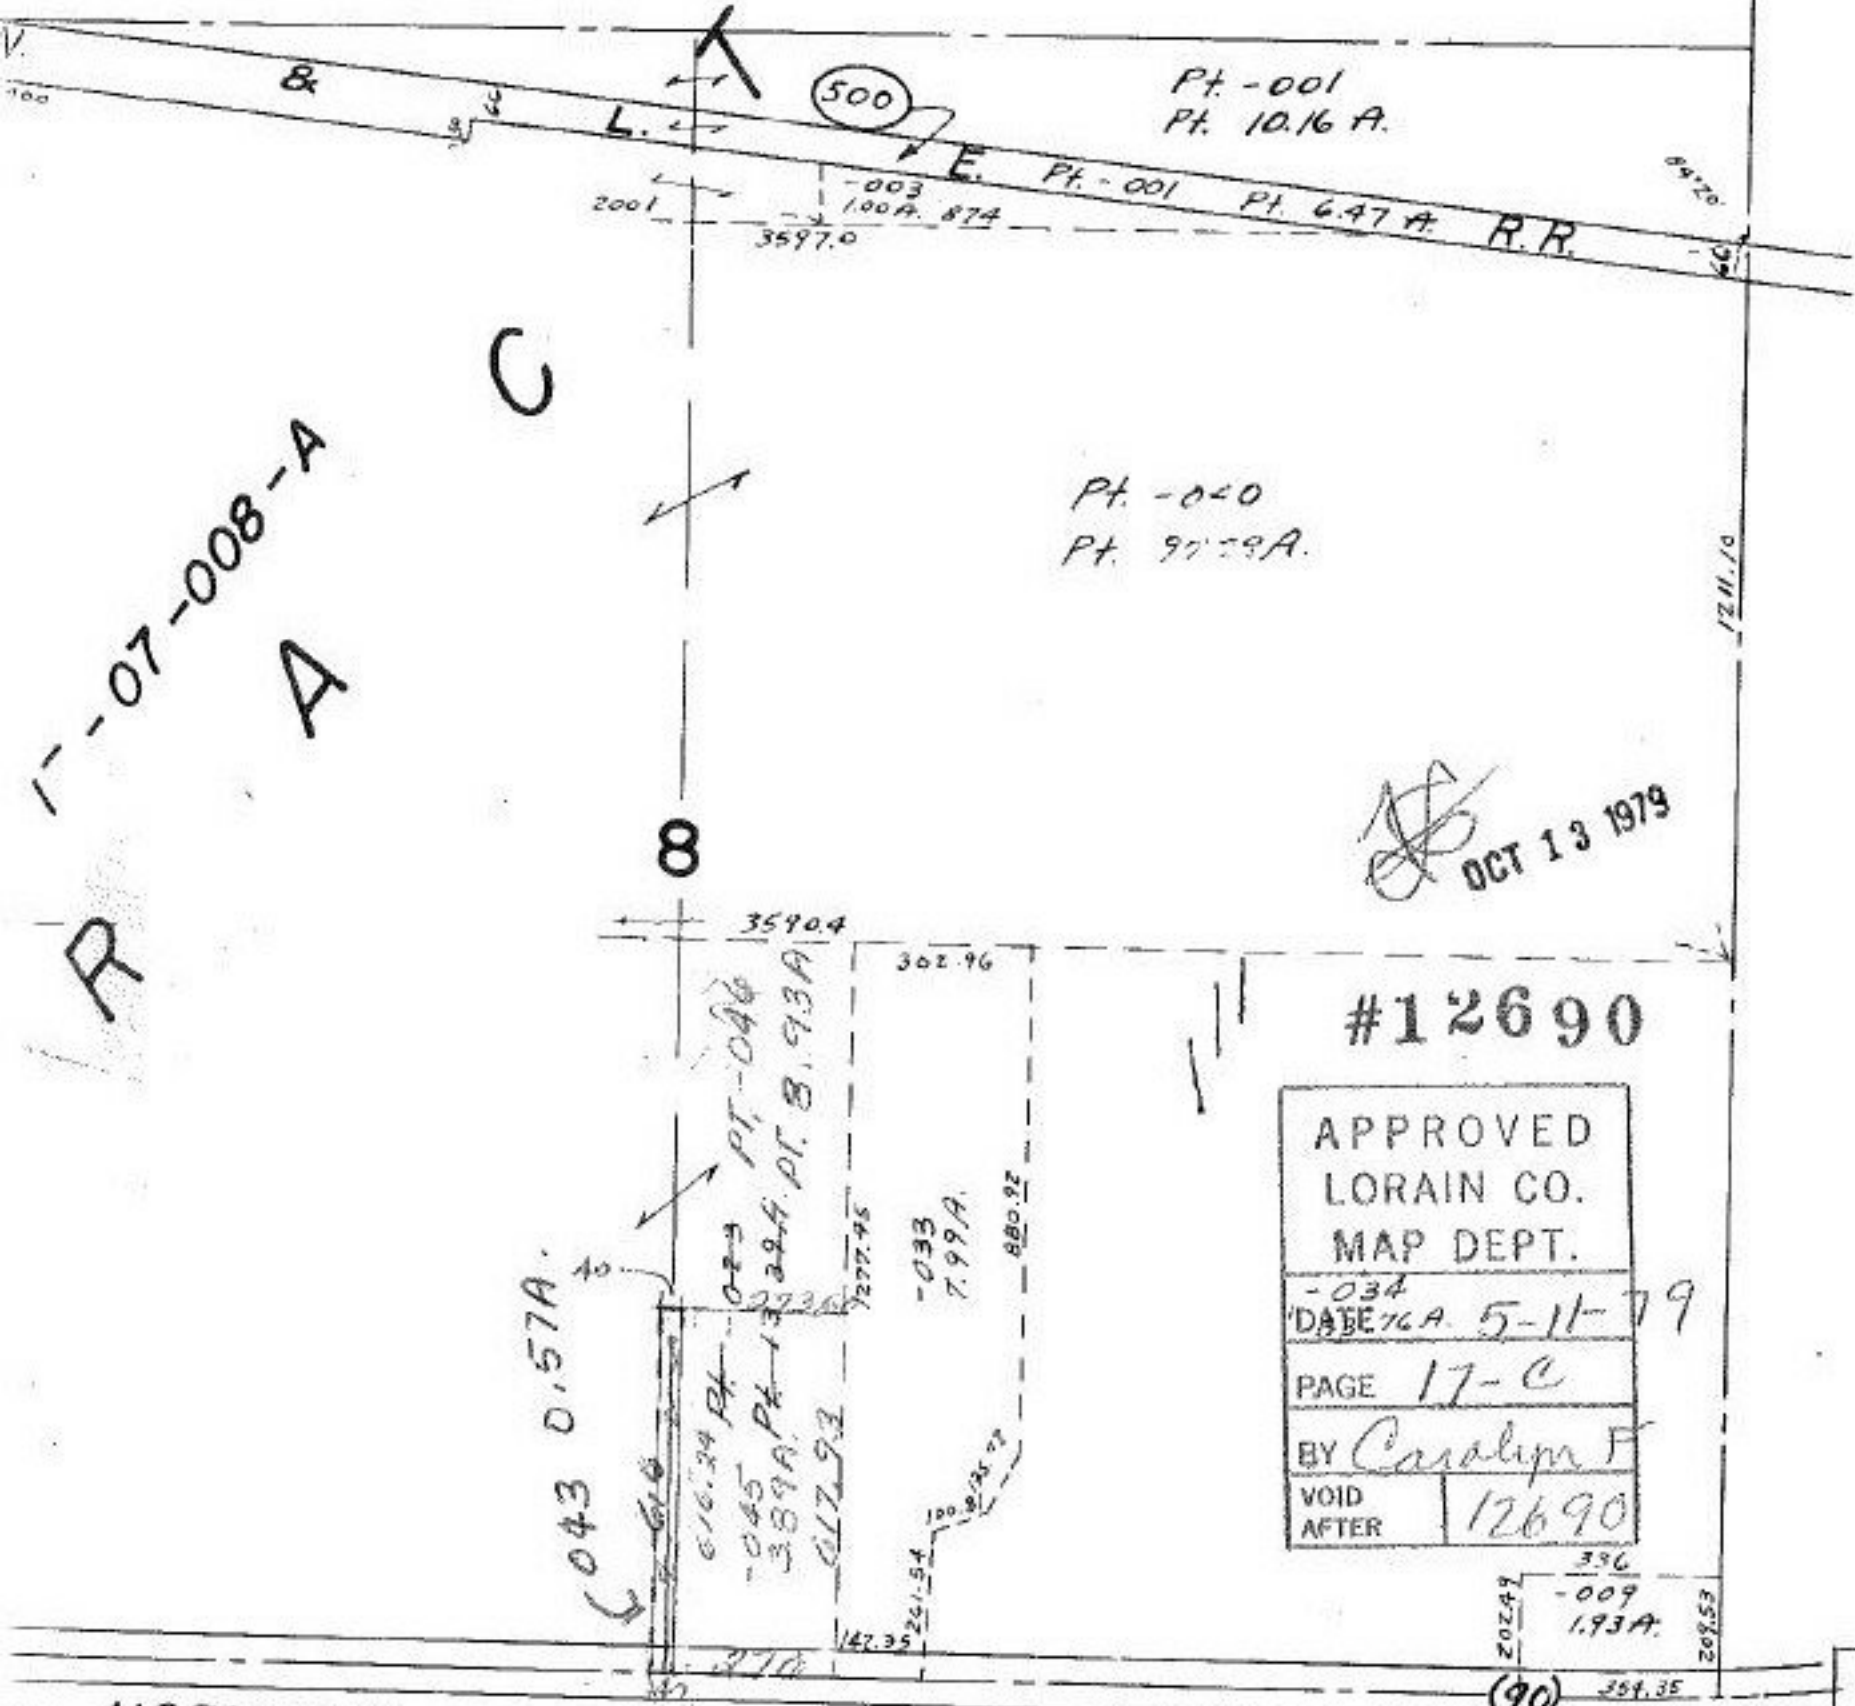

R
A
07-008-A

C

8

#12690

APPROVED
LORAIN CO.
MAP DEPT.

-034
DATE 7/6 A. 5-11-79

PAGE 17-C

BY Carolyn F

VOID
AFTER 12690

NORWALK

RD.

18

WP.

893
389
12.82

TRACT 7 LOTS 3, 8
" 8 " 23, 2