


#12724

250.68
180.68

70.00

E 18-00-021-A

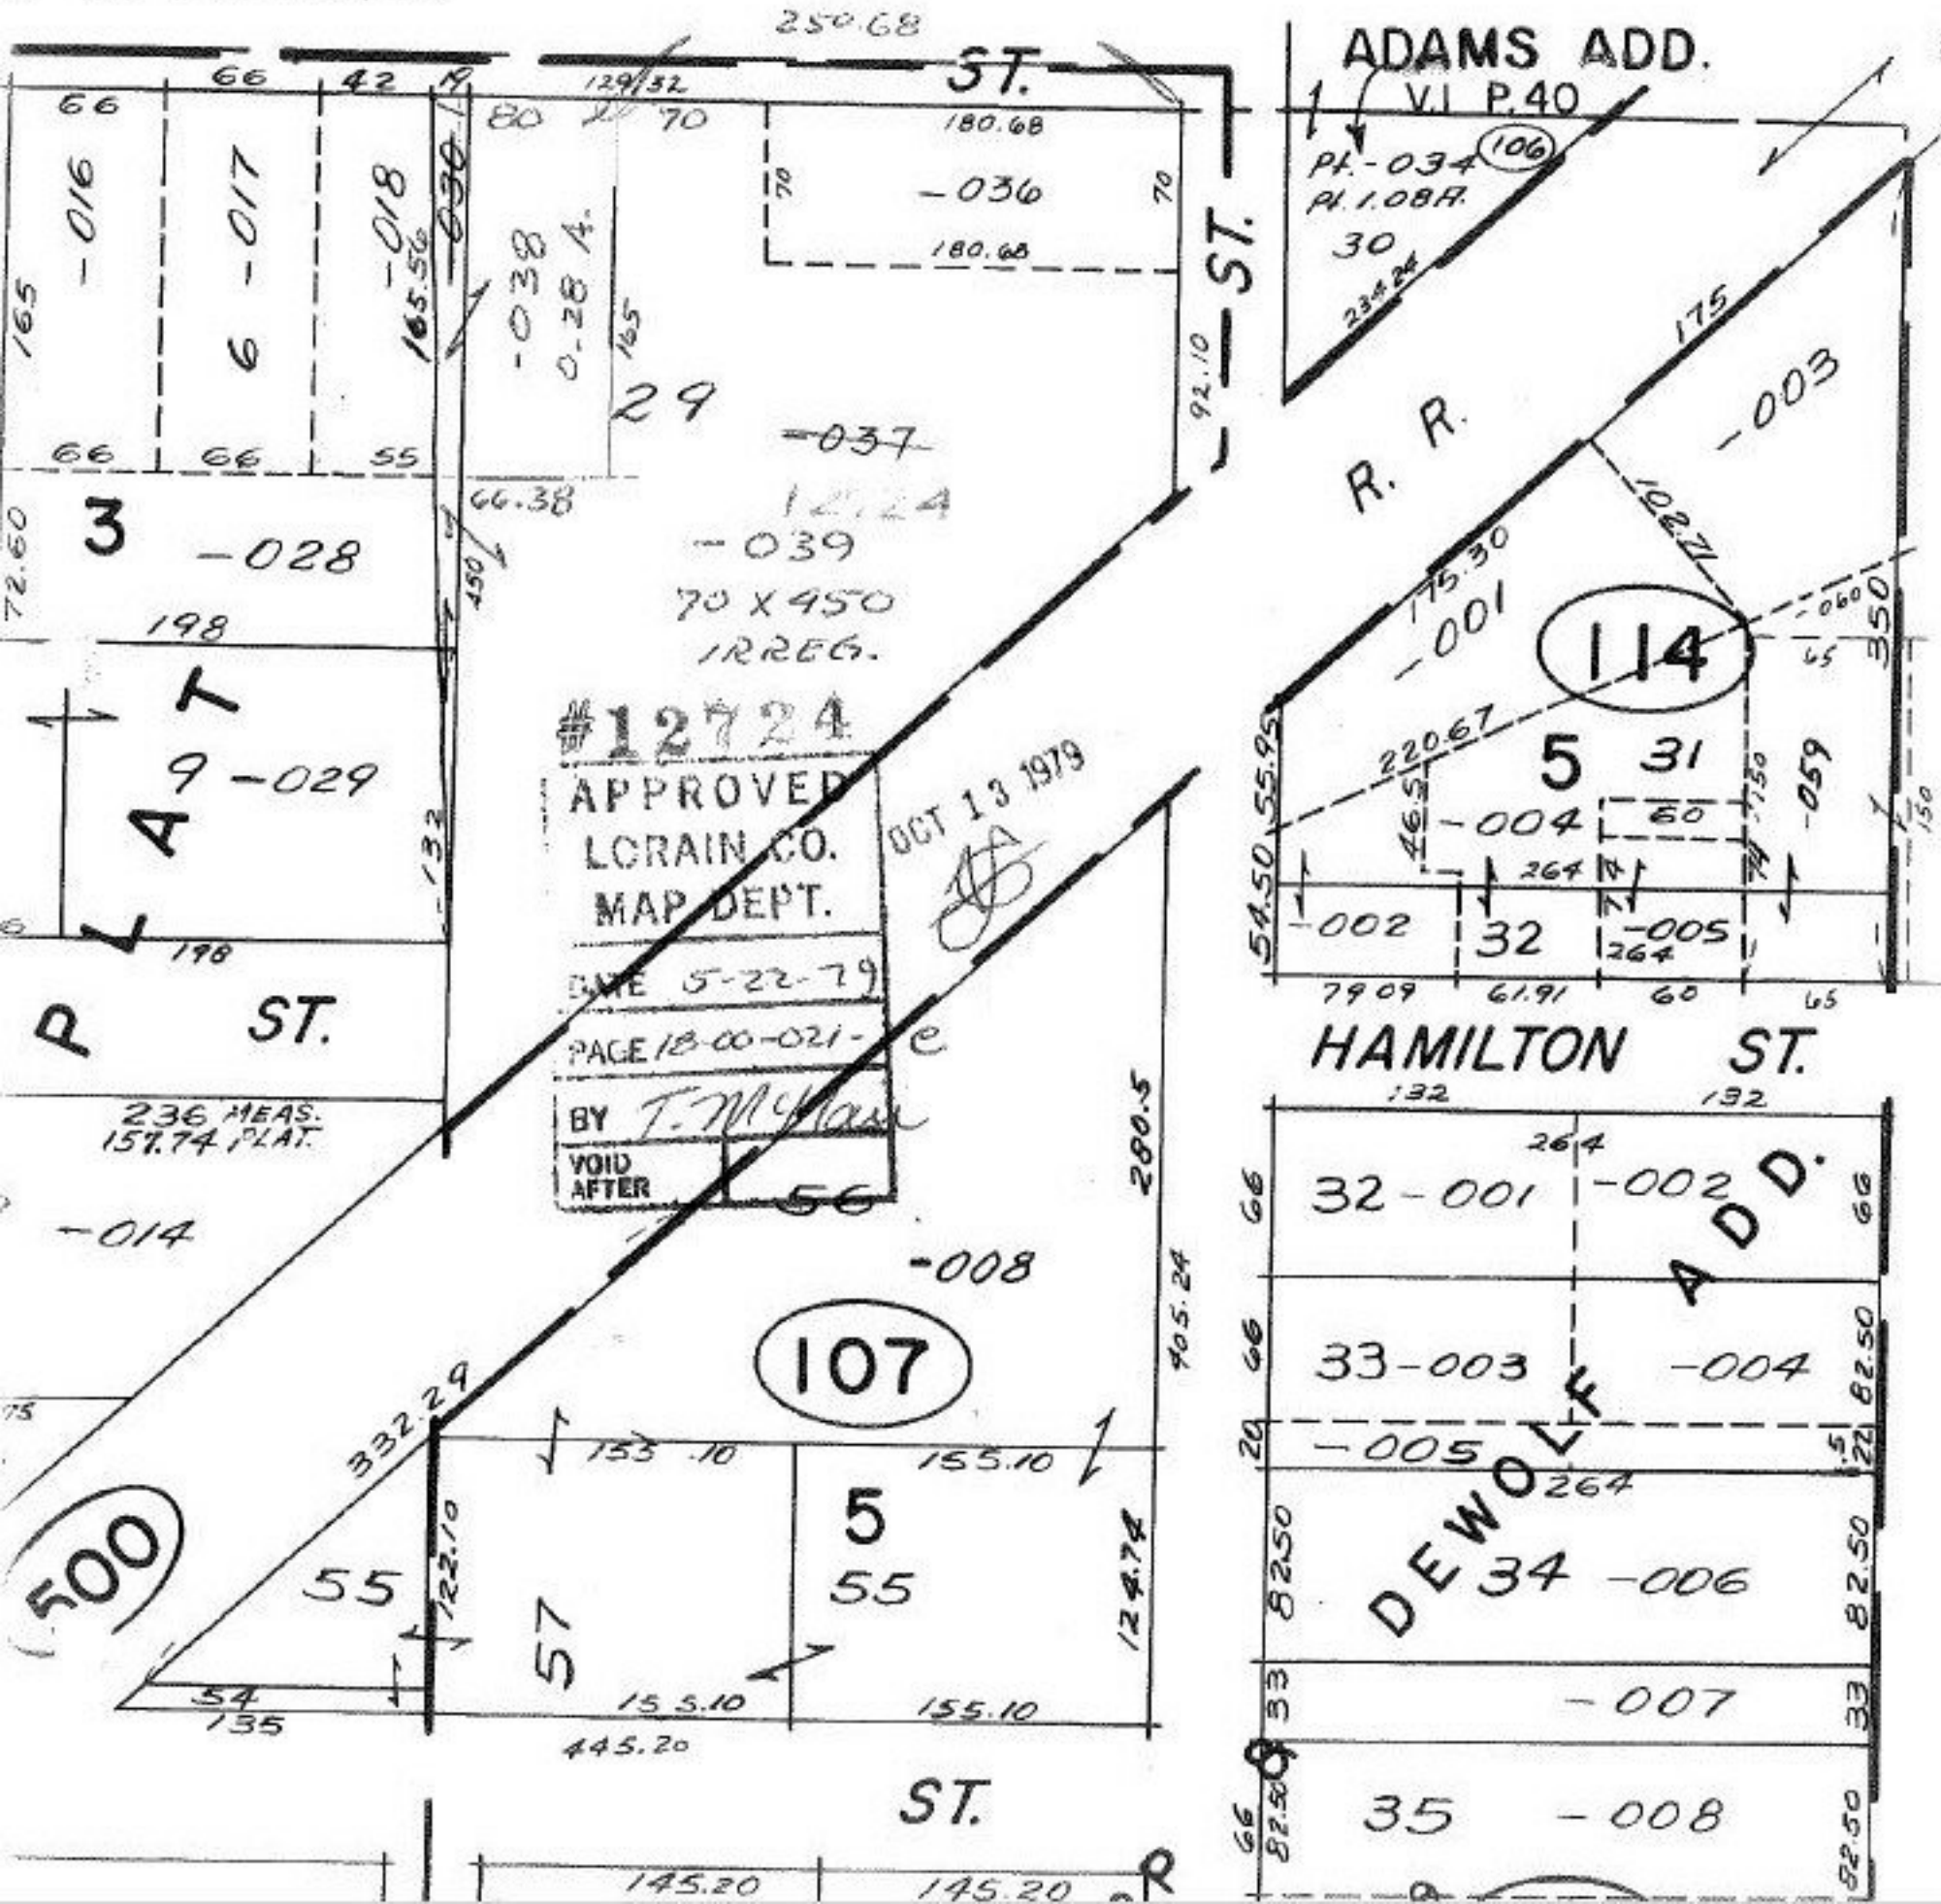

#12724
 APPROVED
 LORAIN CO.
 MAP DEPT.
 OCT 13 1979
 BY T. Mylan
 VOID AFTER 5-22-79
 PAGE 18-00-021-e

ADAMS ADD.

HAMILTON ST.

DEWOLF ADD.

3 -028
9 -029
A
198
198
ST.

107

114

500

5
55

5 31

ST.

35 -008