

#12729

Copyright 1962

13-11-025


~~006~~
~~40-91A~~
44.16 A

ACREAGE CORRECTION - PER SURVEY C.T. BIGGS.

-006 - TRIANGLES = NEW -006
45.86 - 1.06 = 44.16 A.

DATE OF TRANSFER 5-22-79
TRANSFER NO. 2

THIS ALSO CORRECTS ACREAGE ON
TRANSFER # 11 3-20-79

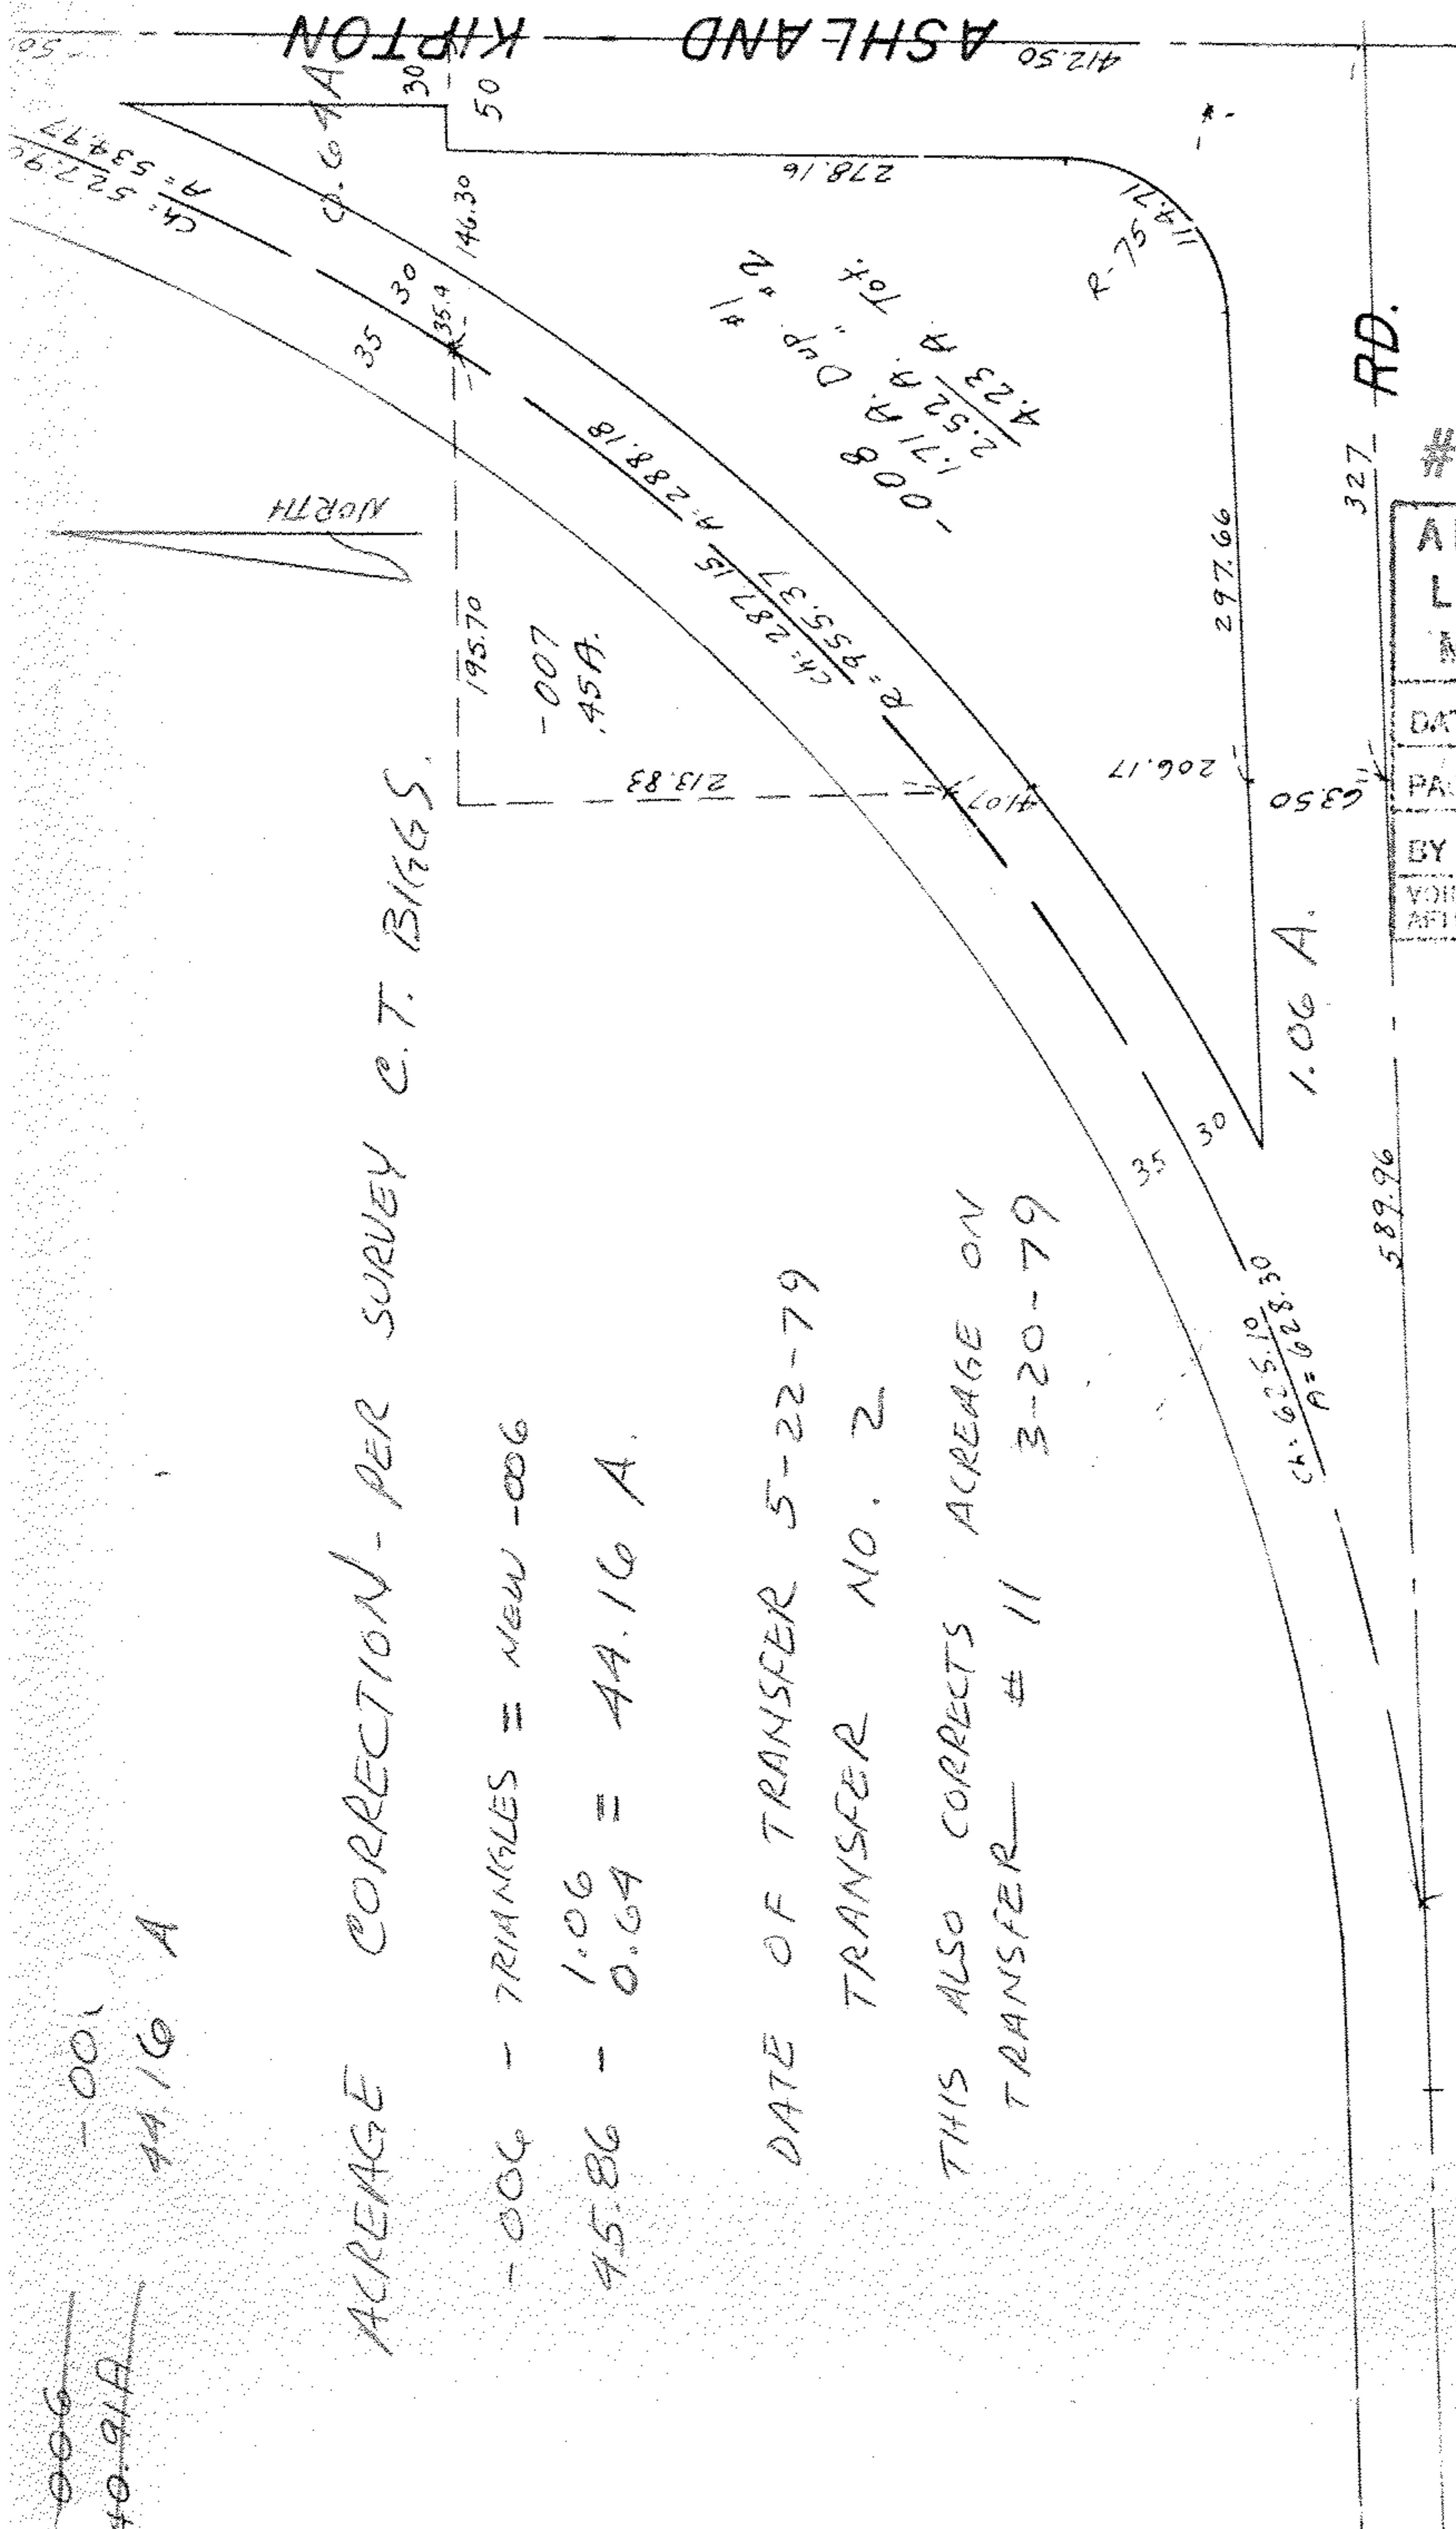

#12729

APPROVED
LORAIN CO.
MAP DEPT.

DATE 5-22-79

PAGE 13-11-025

BY T. McMain

VOID AFTER

OCT 19 1979

SEE 13-B

TRACT 11, LOT 25