


9 - 059

5.69 A.

#12739

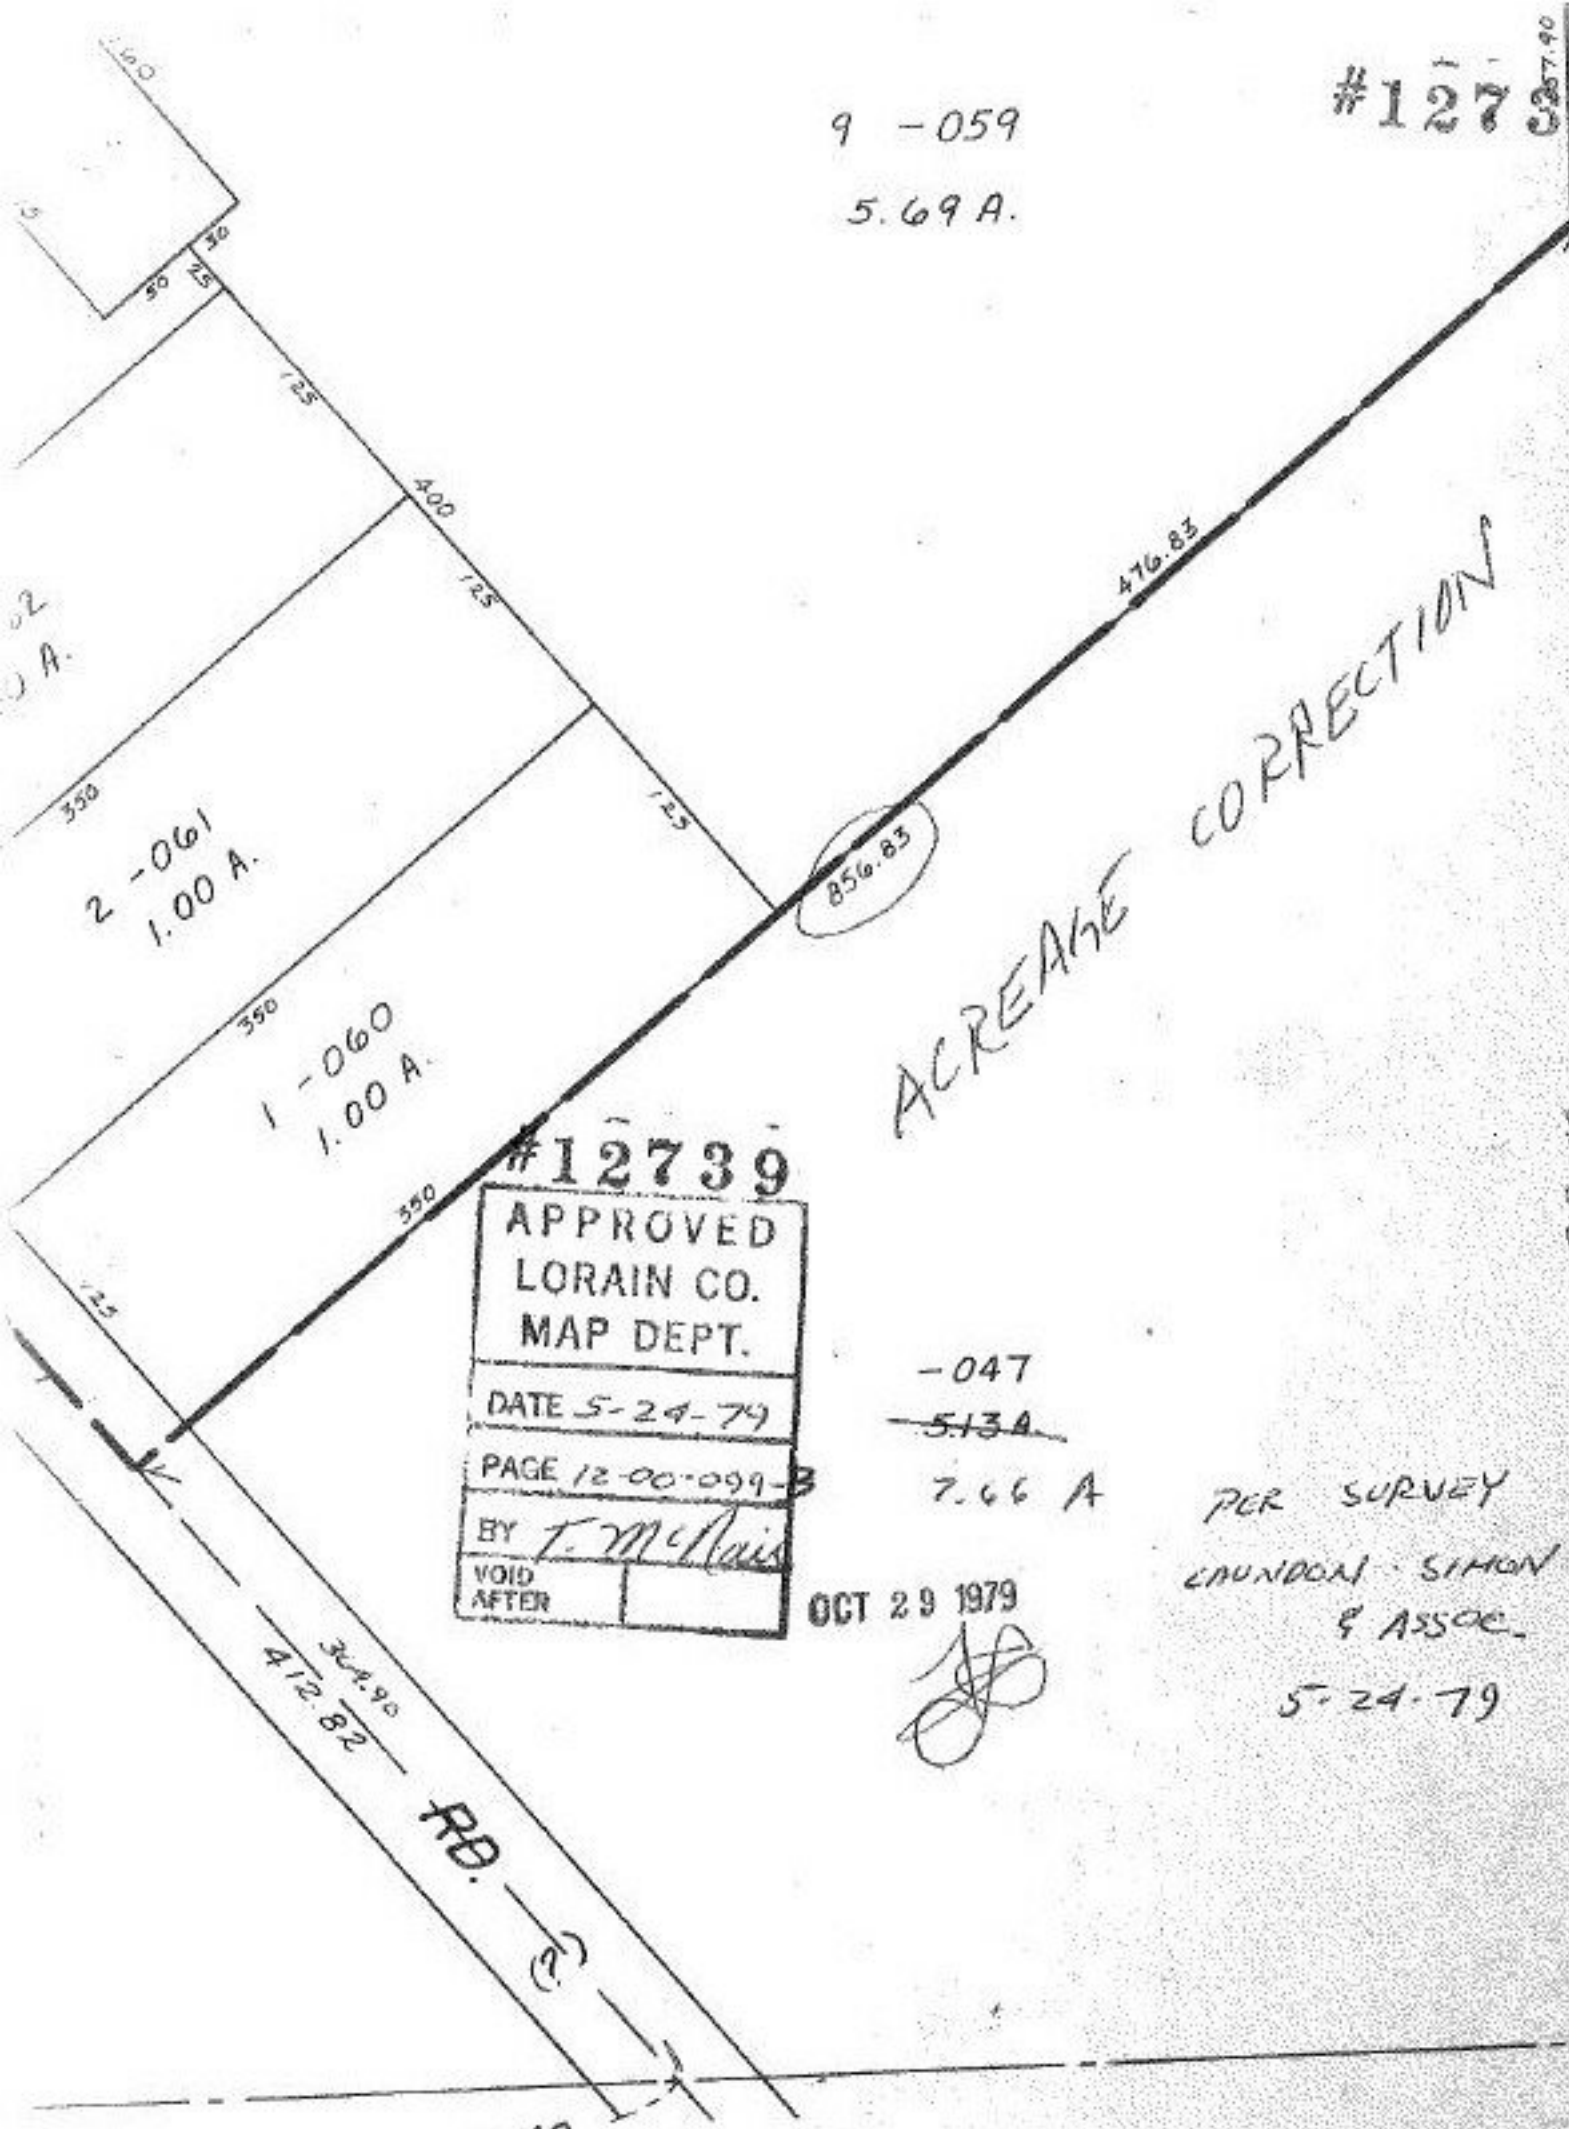

ACREAGE CORRECTION

#12739

APPROVED
LORAIN CO.
MAP DEPT.
DATE 5-24-79
PAGE 12-00-099-B
BY T. McNeil
VOID AFTER

-047

~~5.134~~

7.66 A

OCT 29 1979

PER SURVEY  
CAUNDON - SIMON - EARL  
& ASSOC.

5-24-79