


#12756

NOTE SURVEYED  
BY P. SHULSKY

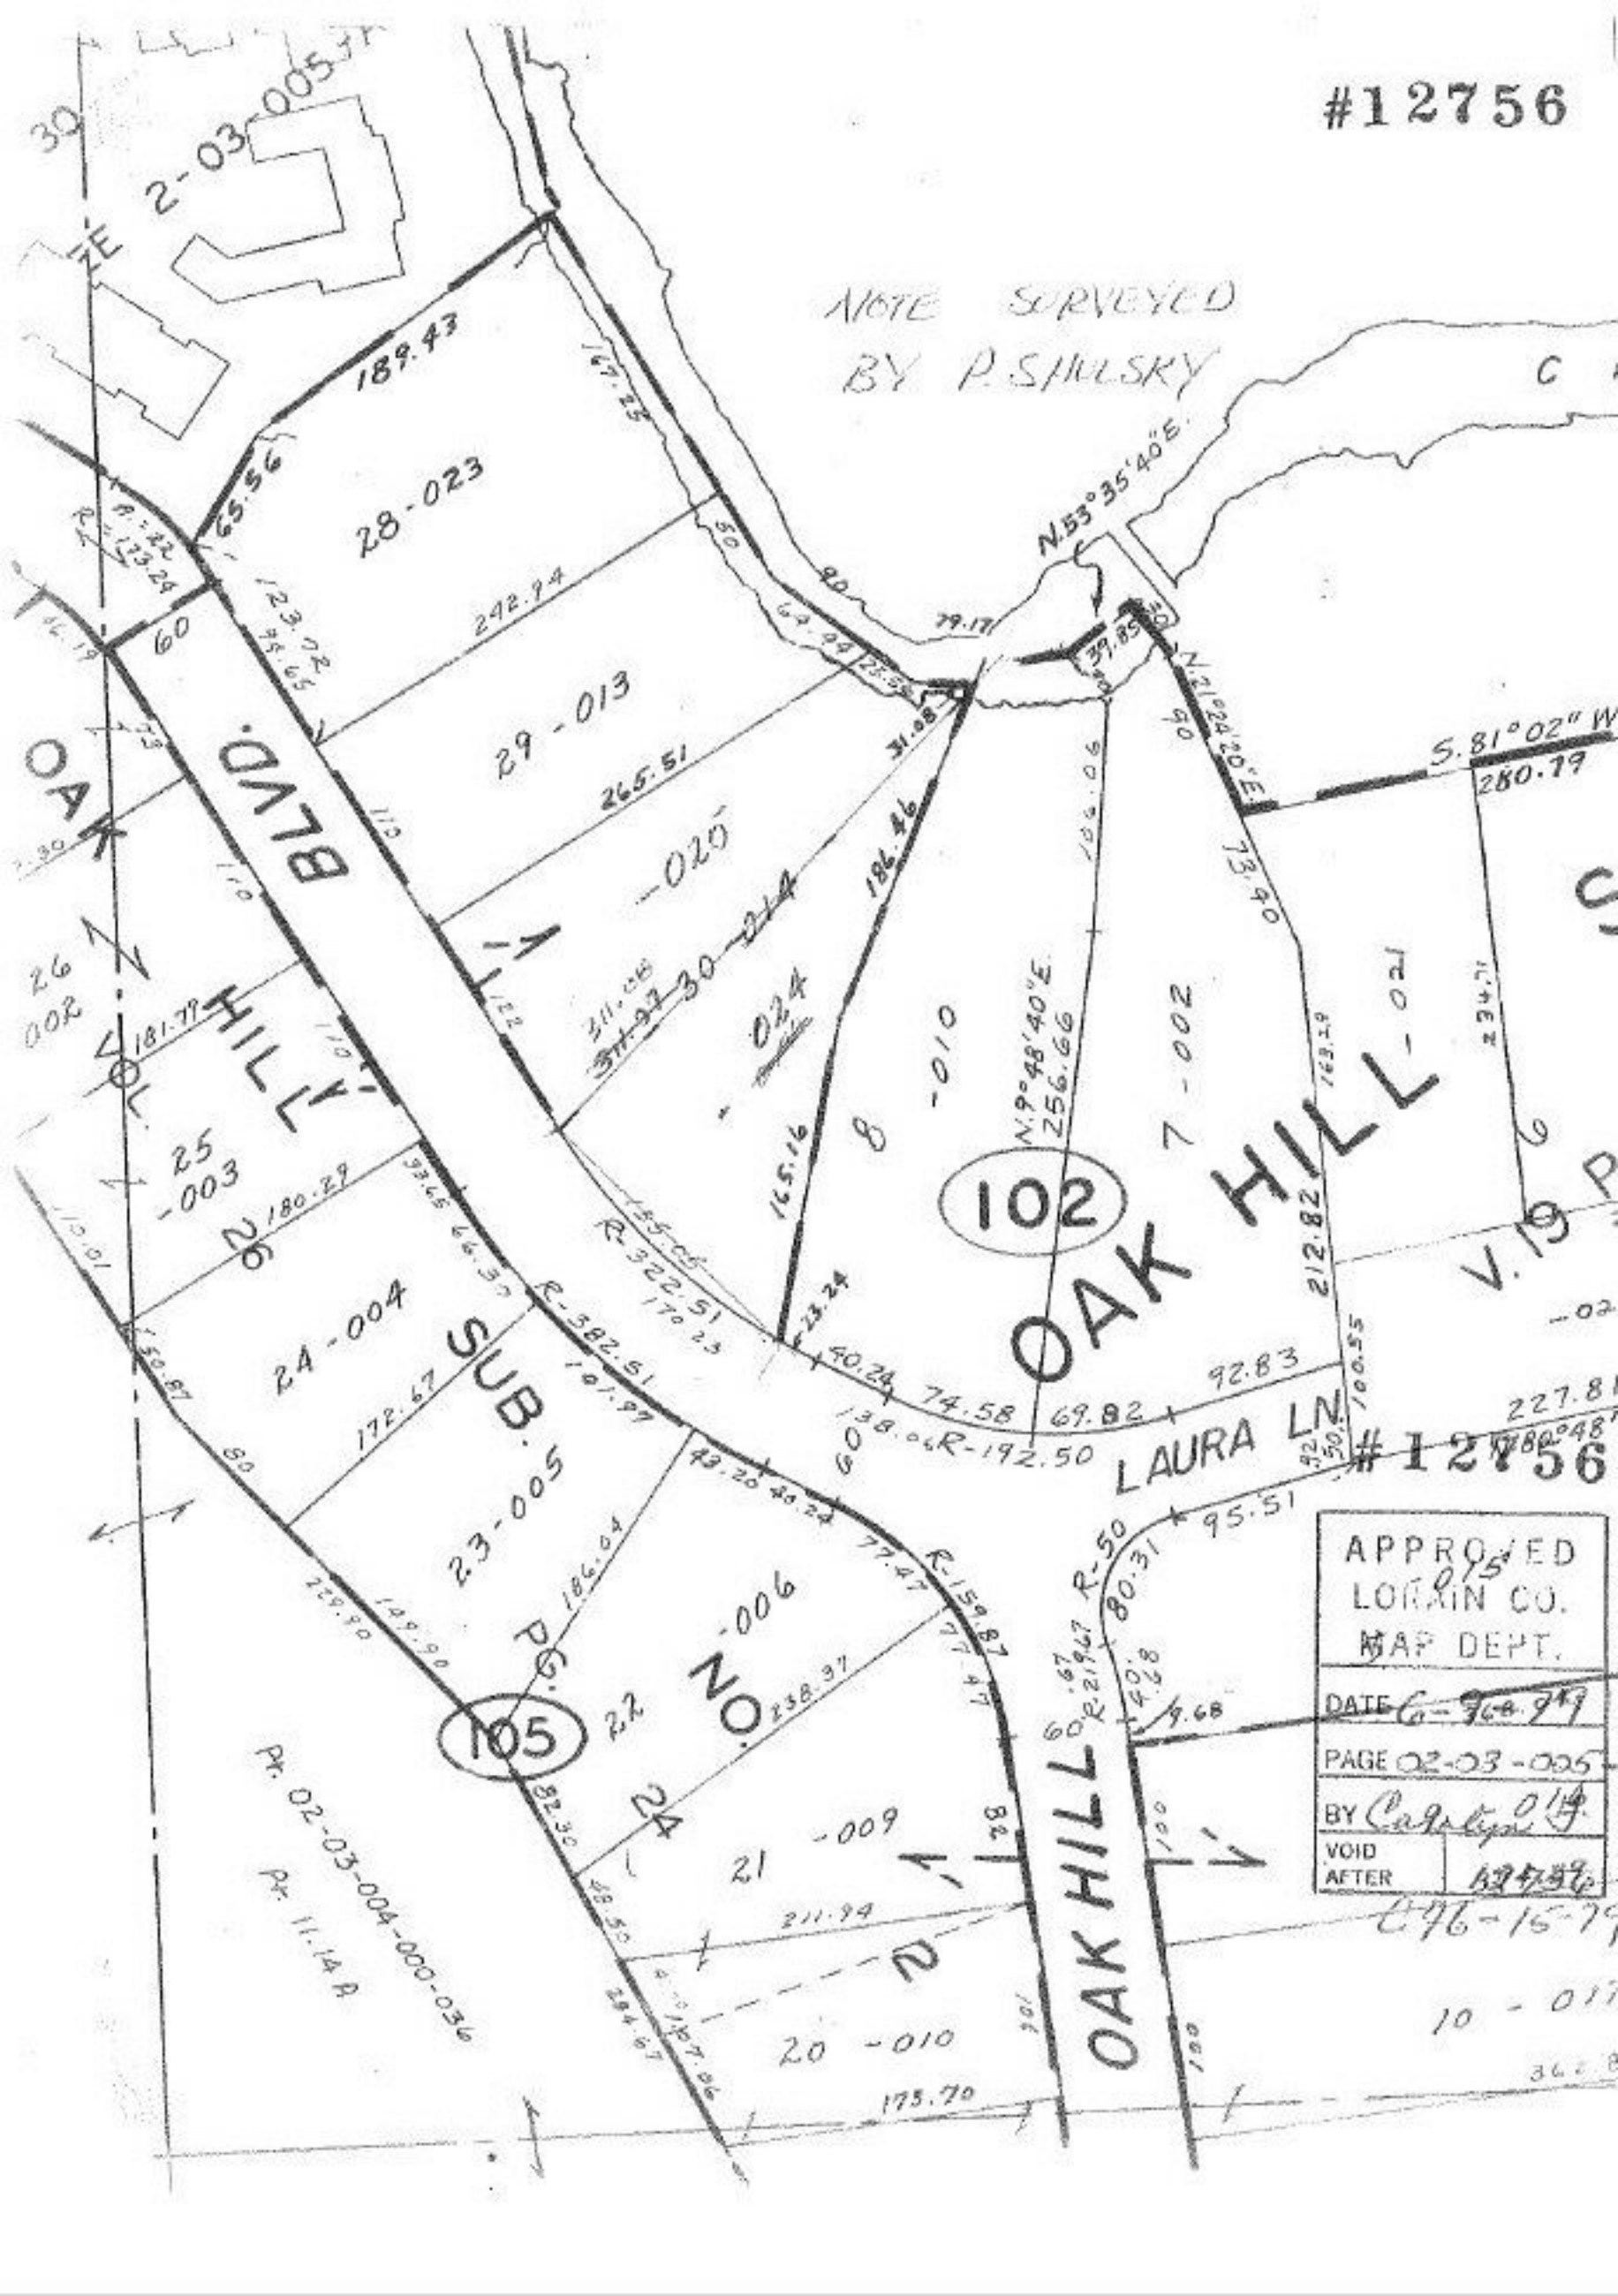

102

105

APPROVED	
LORAIN CO.	
MAP DEPT.	
DATE	6-9-68
PAGE	02-03-005
BY	Carlton J.
VOID AFTER	12756

#12756

276-15-79

10-011

360.8