


#12758

SEE 16-H

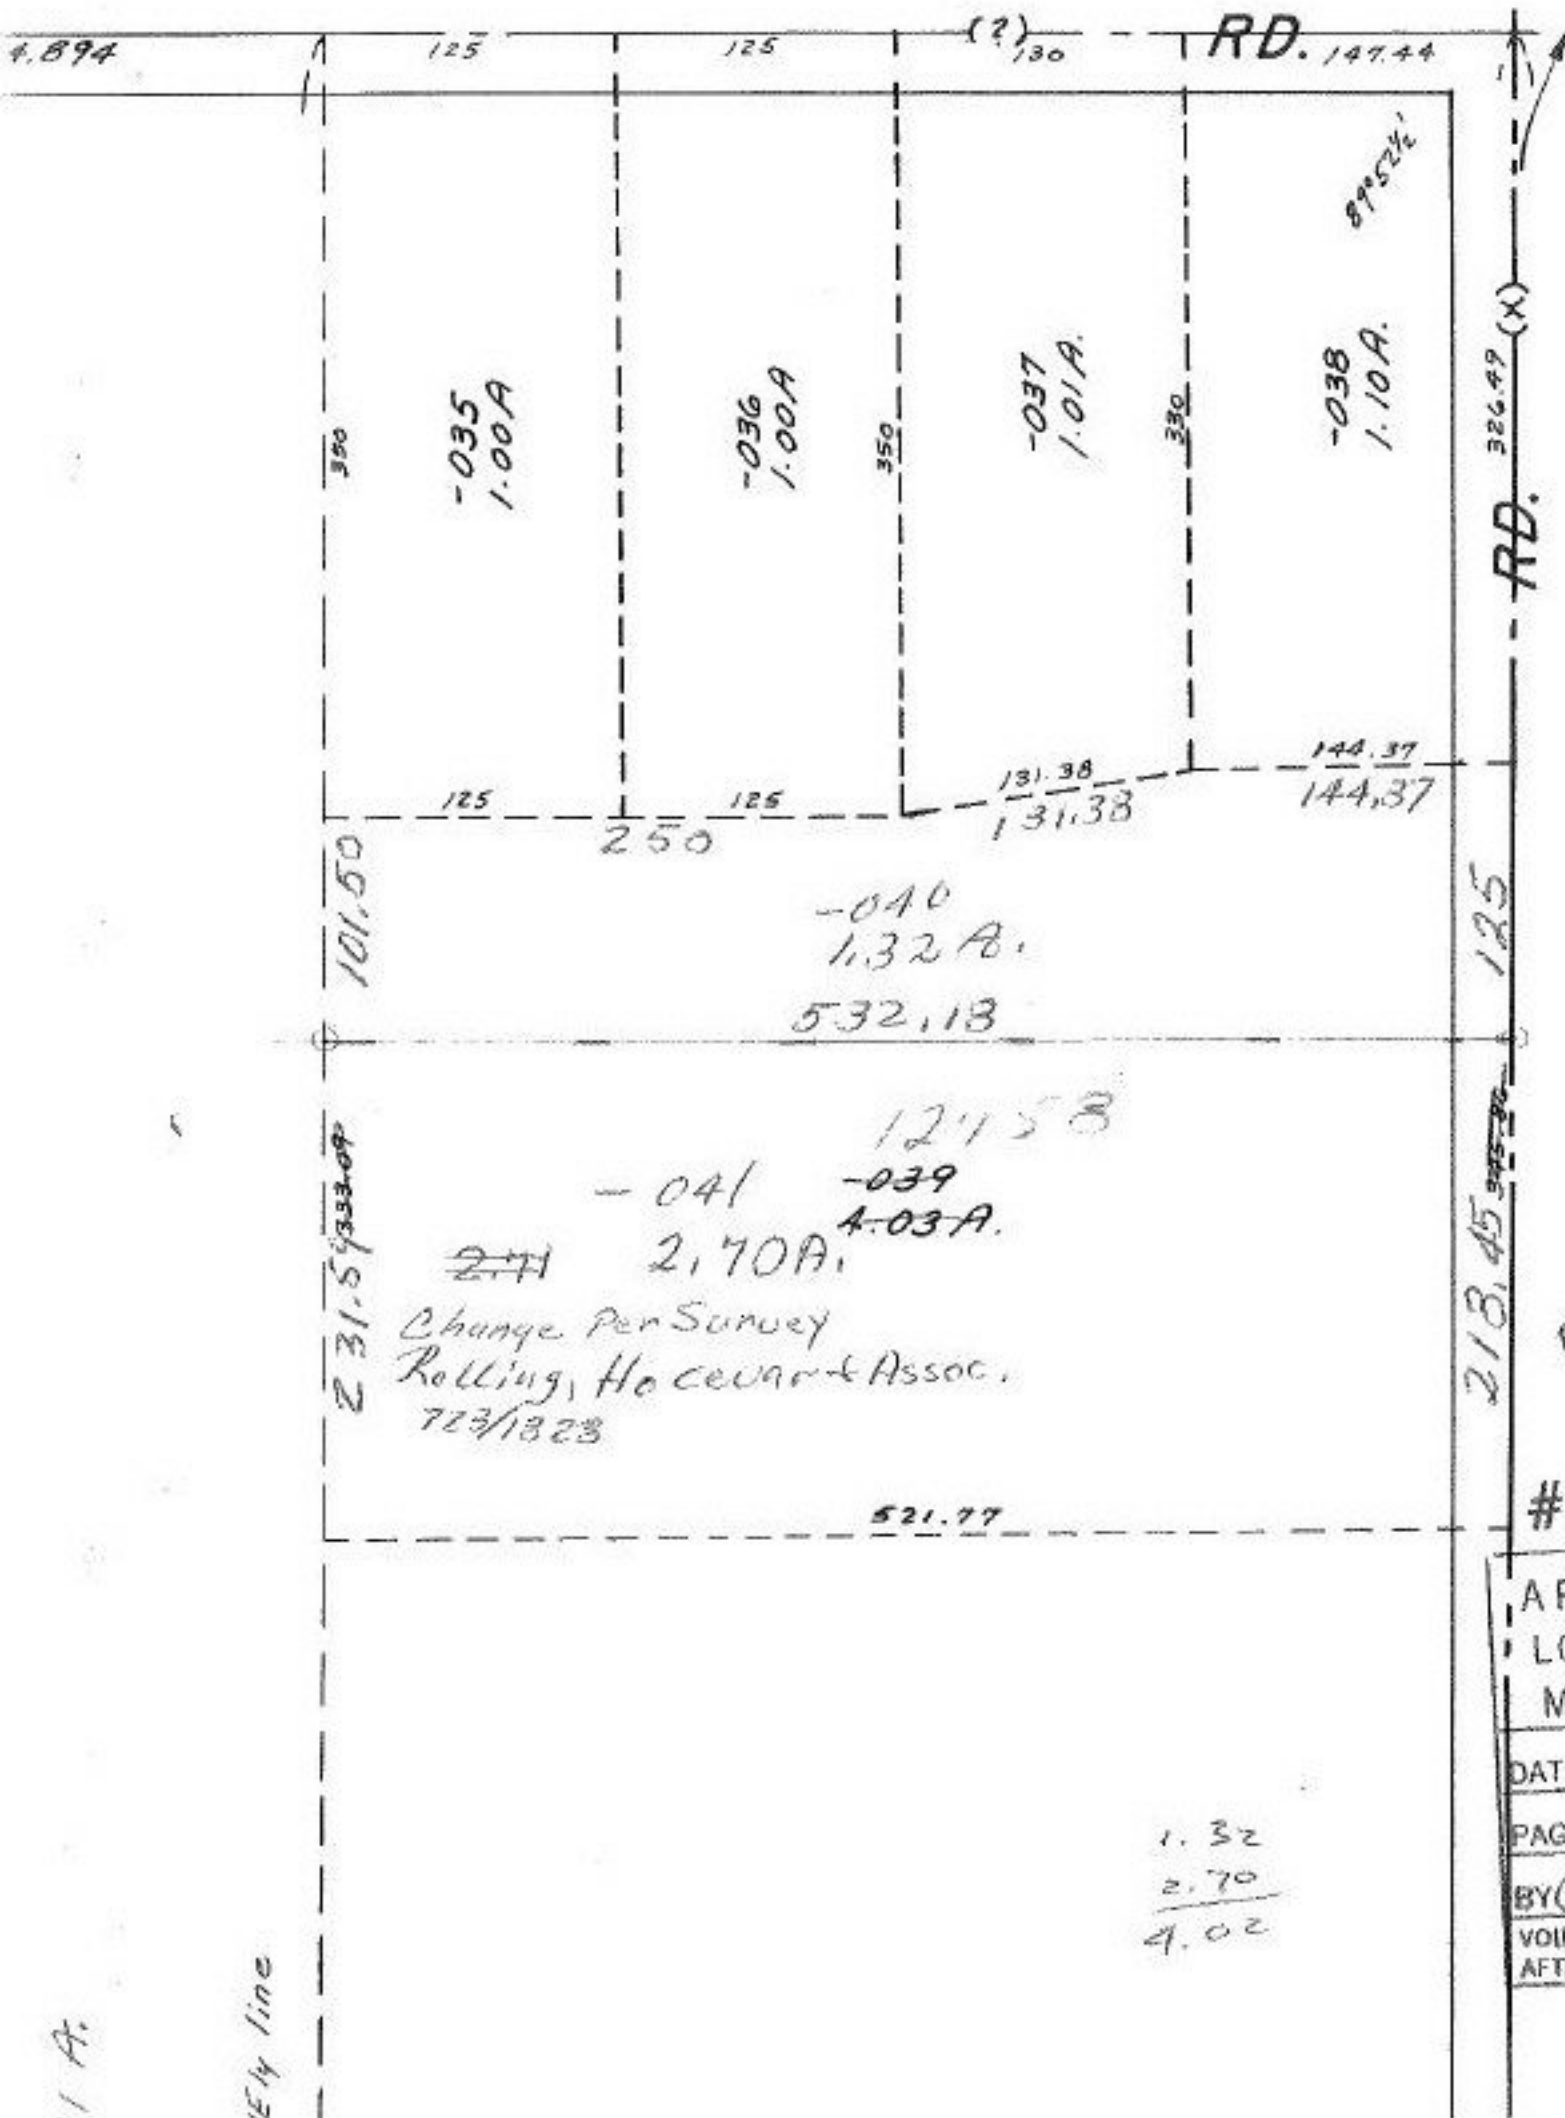

OCT 22 1979

#12758

APPROVED
LORAIN CO.
MAP DEPT.
DATE 6-1-79
PAGE 16-00-09
BY Carolyn D. [Signature]
VOID AFTER 12758