


SEE 18-00-021-C

*Booth*  
*Booth*

*McN*

9

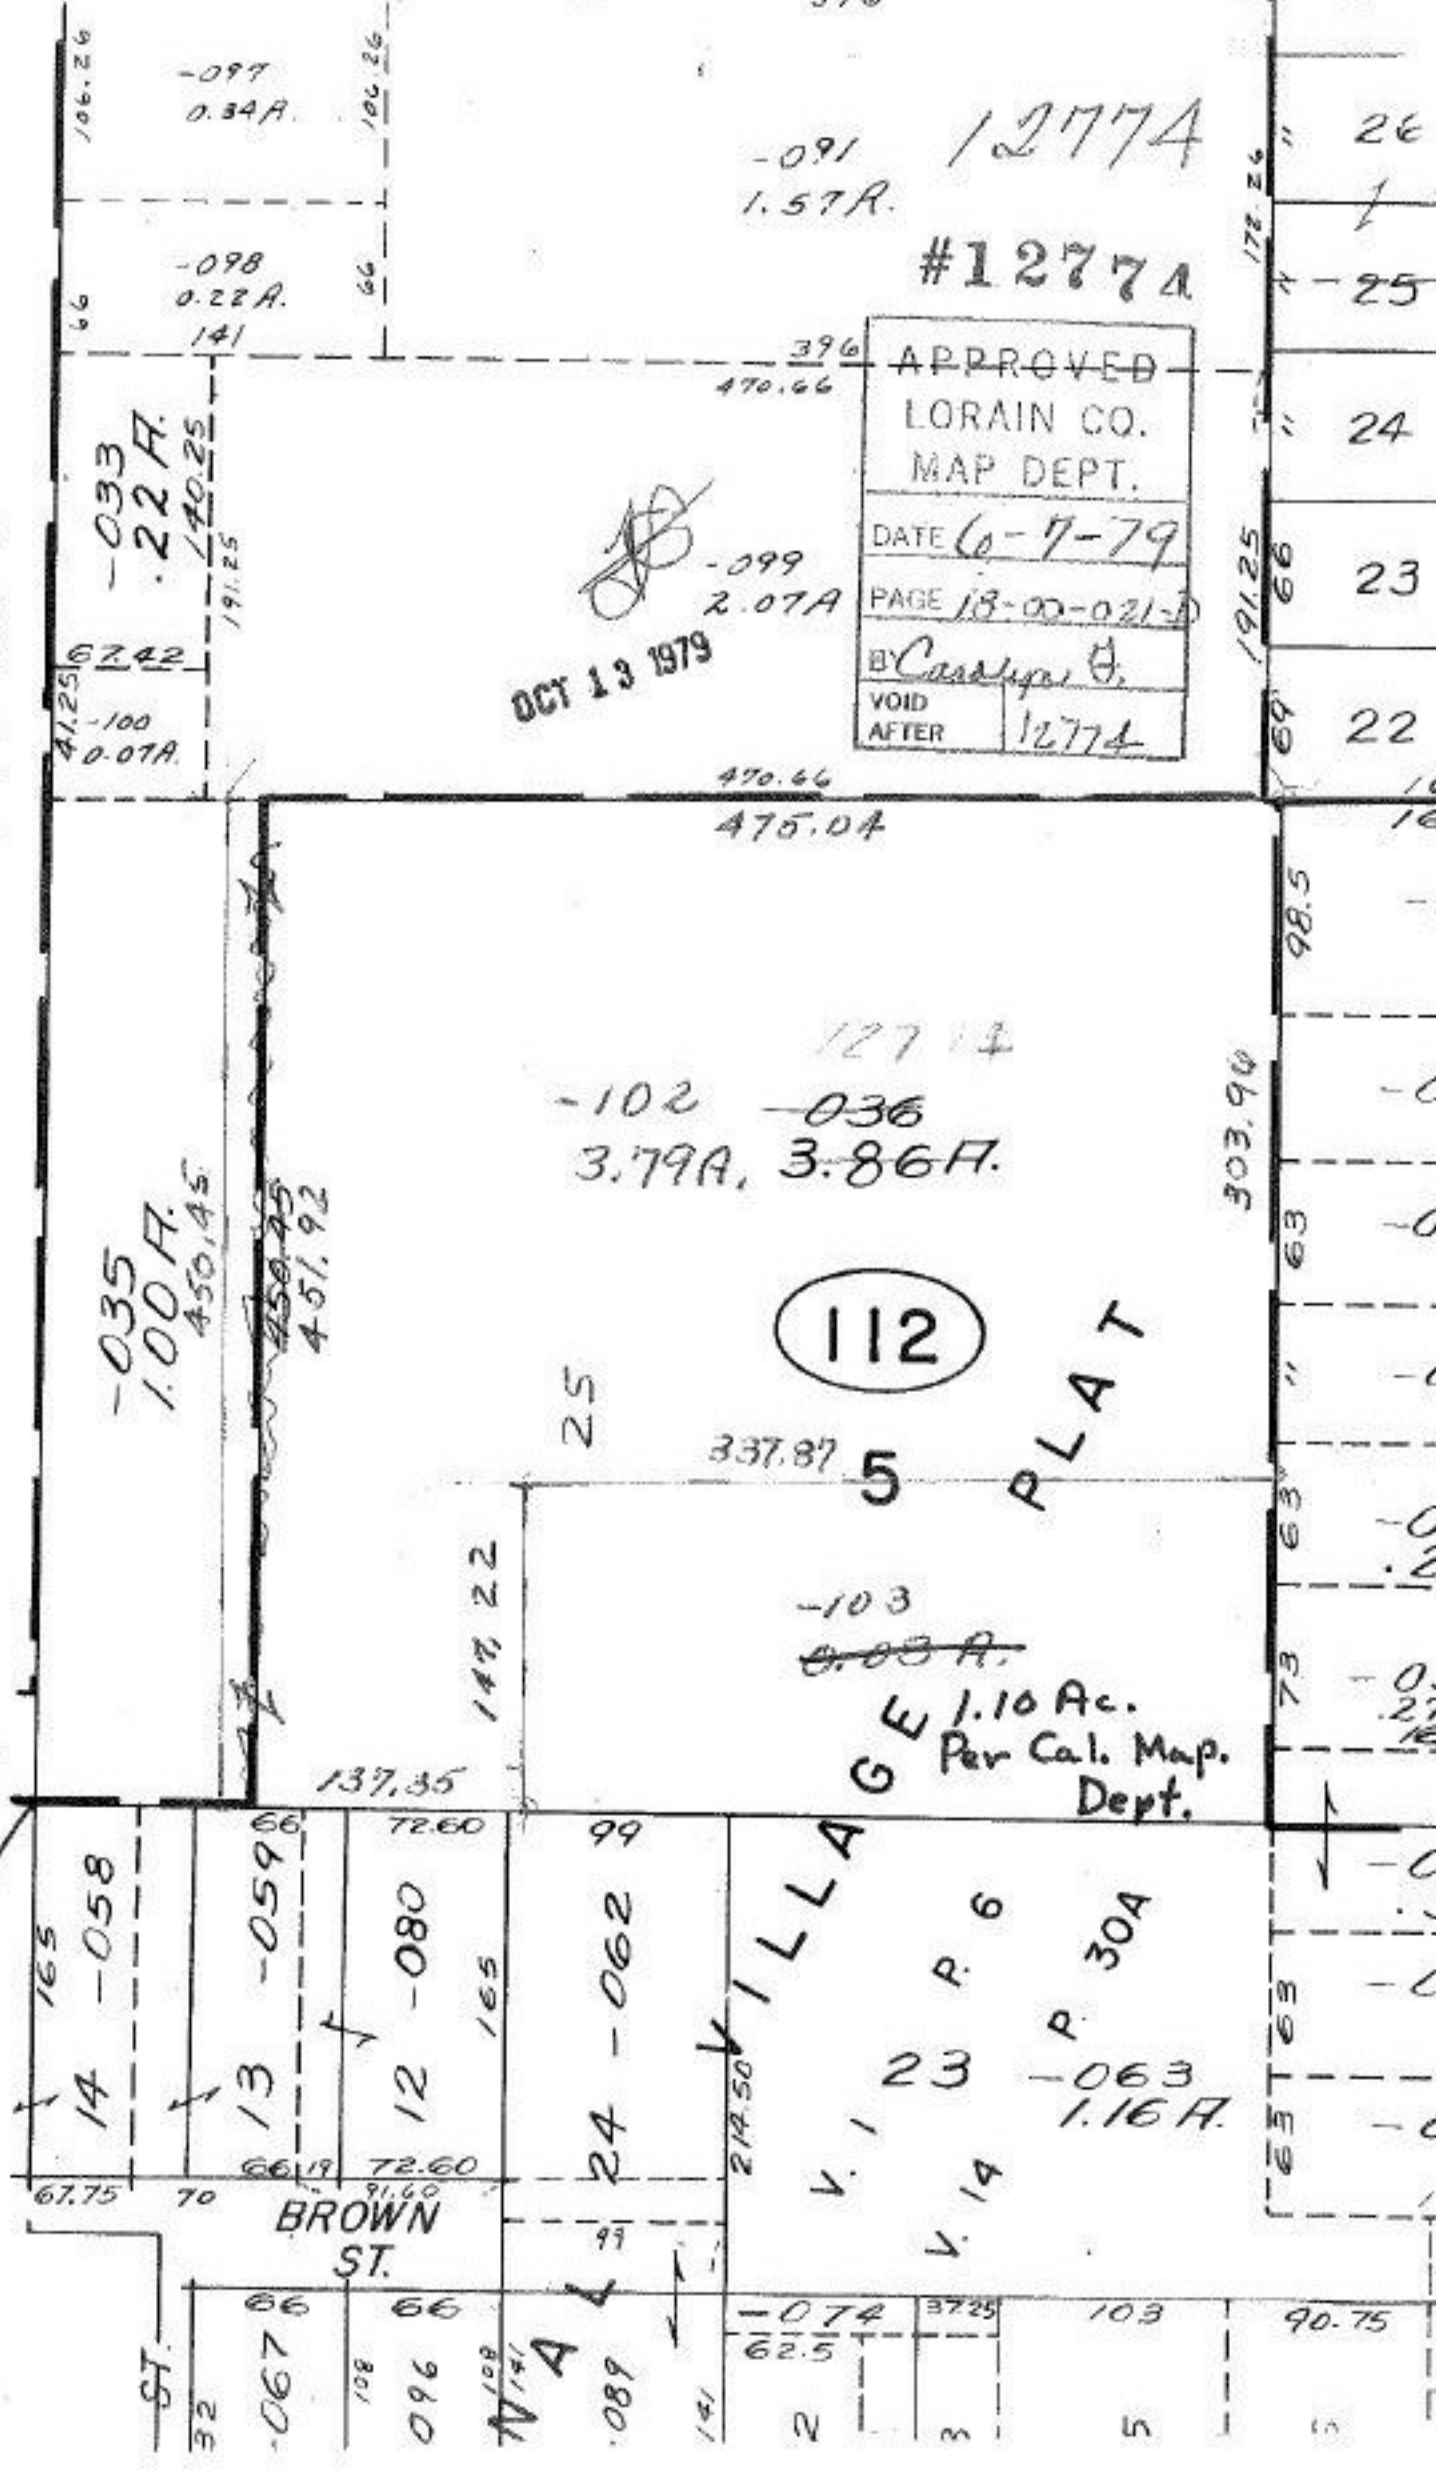

APPROVED  
LORAIN CO.  
MAP DEPT.  
DATE 6-7-79  
PAGE 18-00-021-C  
BY *Caroline G.*  
VOID AFTER 12774

OCT 13 1979

112

5 PLAT

GE 1.10 Ac.  
Per Cal. Map.  
Dept.

VILLAGE  
V. 1 P. 6  
V. 14 P. 30A

BROWN ST.

ST.

106.26  
-097  
0.34A  
66  
-098  
0.22A  
141  
66  
106.26  
-033  
22A  
140.25  
191.25  
67.42  
-100  
0.07A  
41.25

396  
470.66

-099  
2.07A

470.66  
475.04

12714  
-102 -036  
3.79A, 3.86A

337.87

-103  
~~9.03A~~

137.35

147.22

165  
14 -058  
13 -059  
12 -080  
165  
24 -062  
99  
72.60  
72.60  
91.60  
66.19  
66.19  
66  
66  
108  
096  
108  
N 1/4  
089  
141

1074  
62.5  
3725  
103  
90.75