


67

68

69

#12775

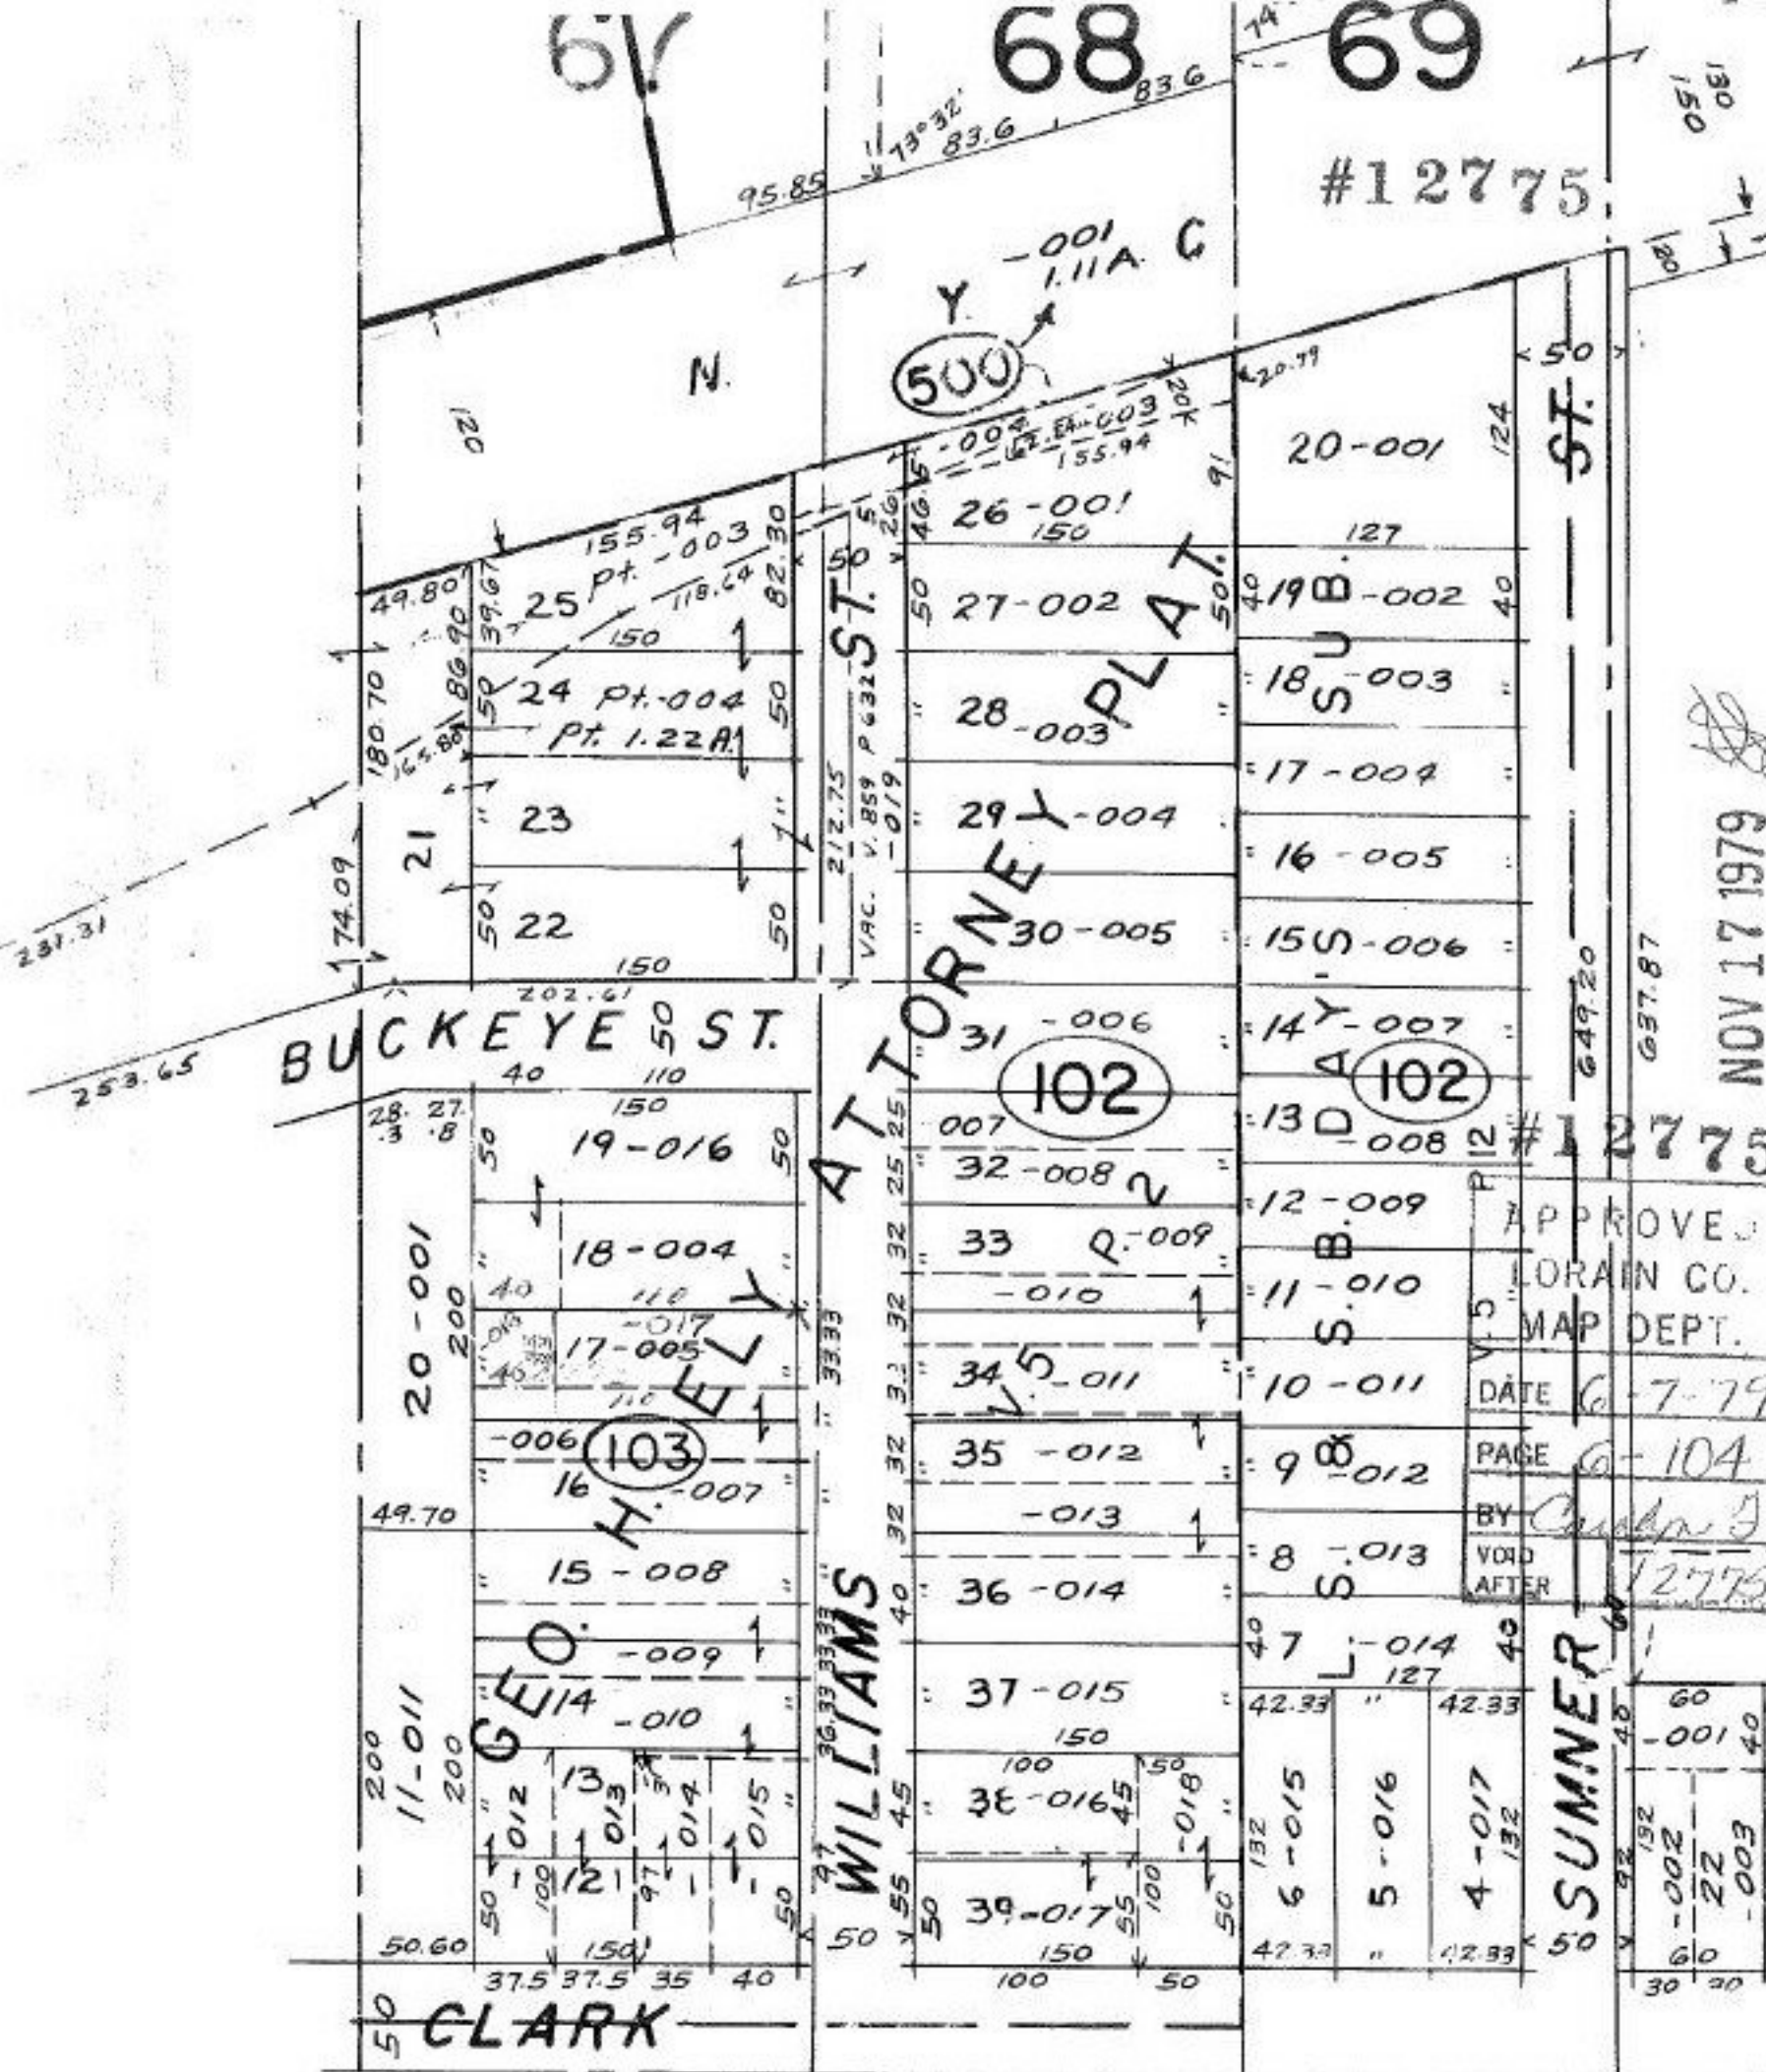

NOV 17 1979

APPROVED  
 LORAIN CO.  
 MAP DEPT.  
 DATE 6-7-79  
 PAGE 6-104  
 BY *Charles J*  
 VOID AFTER 12775

ELYRIA

EAST WY P