

SEE 11-00-089-A

R.D.


WHEELAND

#12808

55A-101-041
Pt. 11-00-093-101-041

Change per Survey
William L. Copas

~~8,688 A~~
8,333 A,
6/79

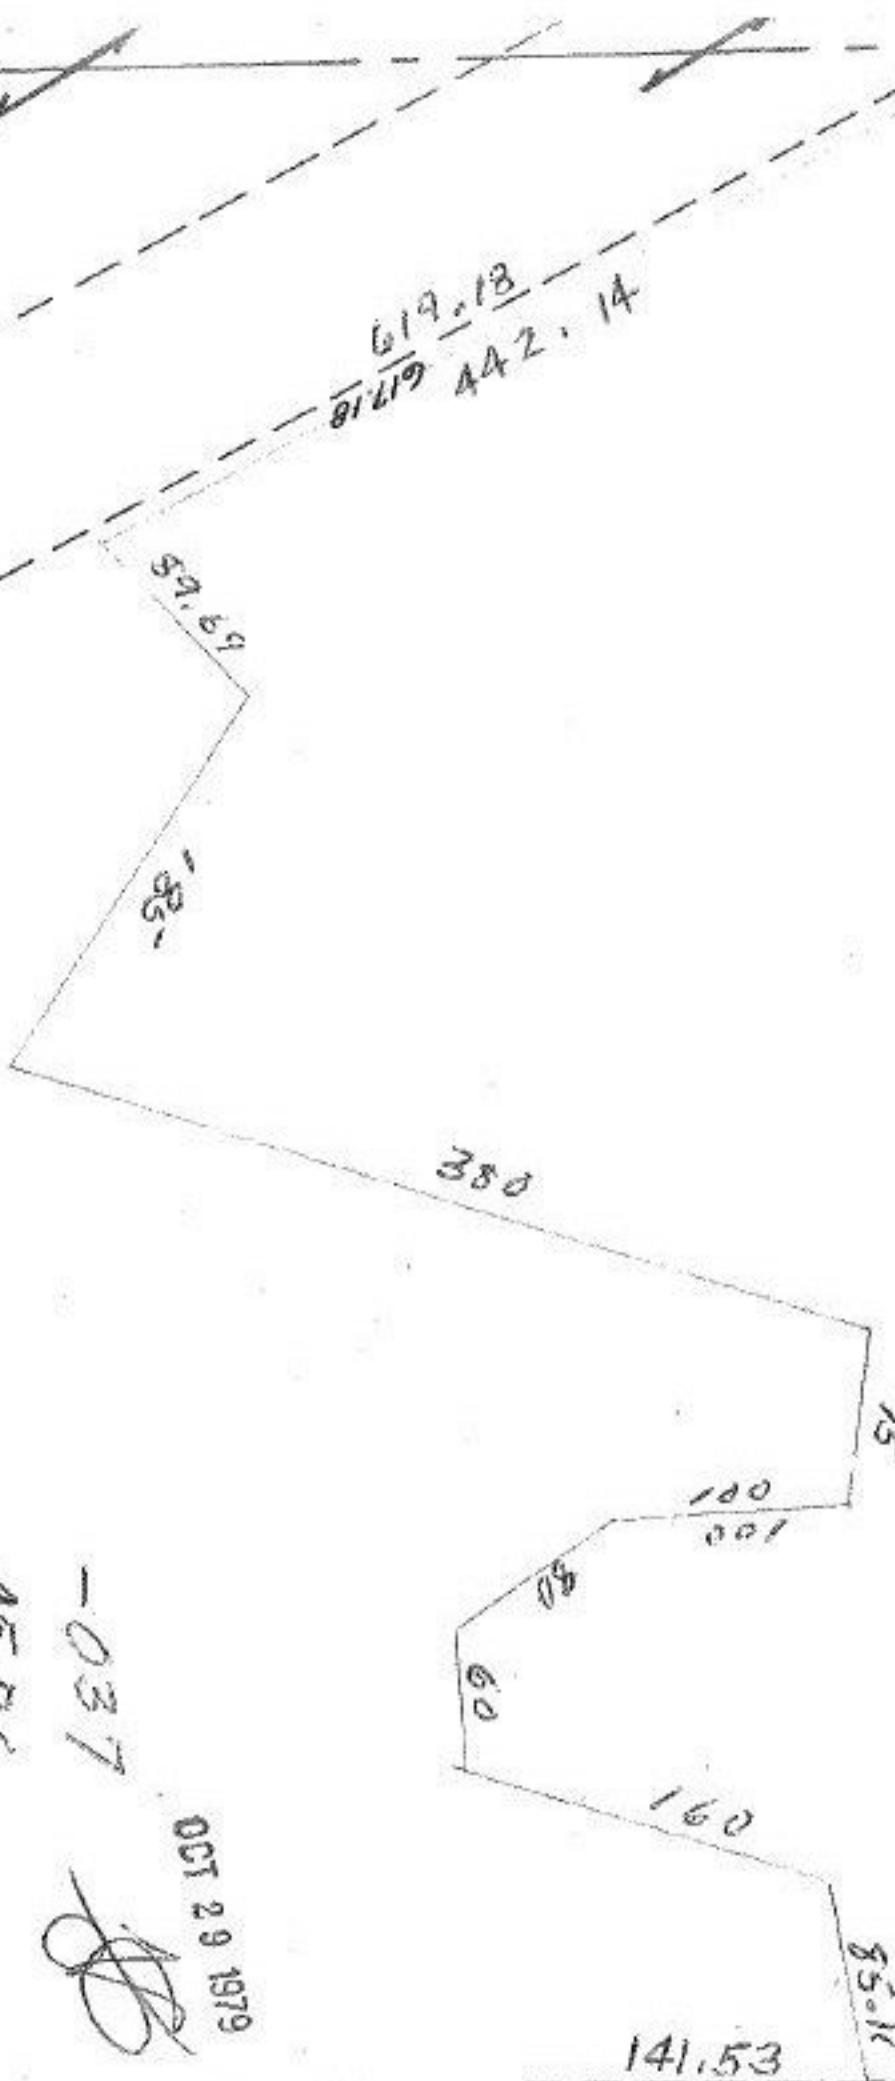

NEED TO REDRAW THIS PAGE

45.76
-037

OCT 29 1979

#12808	
APPROVED	
LORAIN CO.	
MAP DEPT.	
DATE	10-21-79
PAGE	11-00-089-A
BY	Carlynn F
VOID AFTER	12808

Pt. 11-00-089-000-023
Pt. 1.83A

Pt. 11-00-089-000-024
Pt. 5.28A