


#12814

(LAGRANGE RD.)

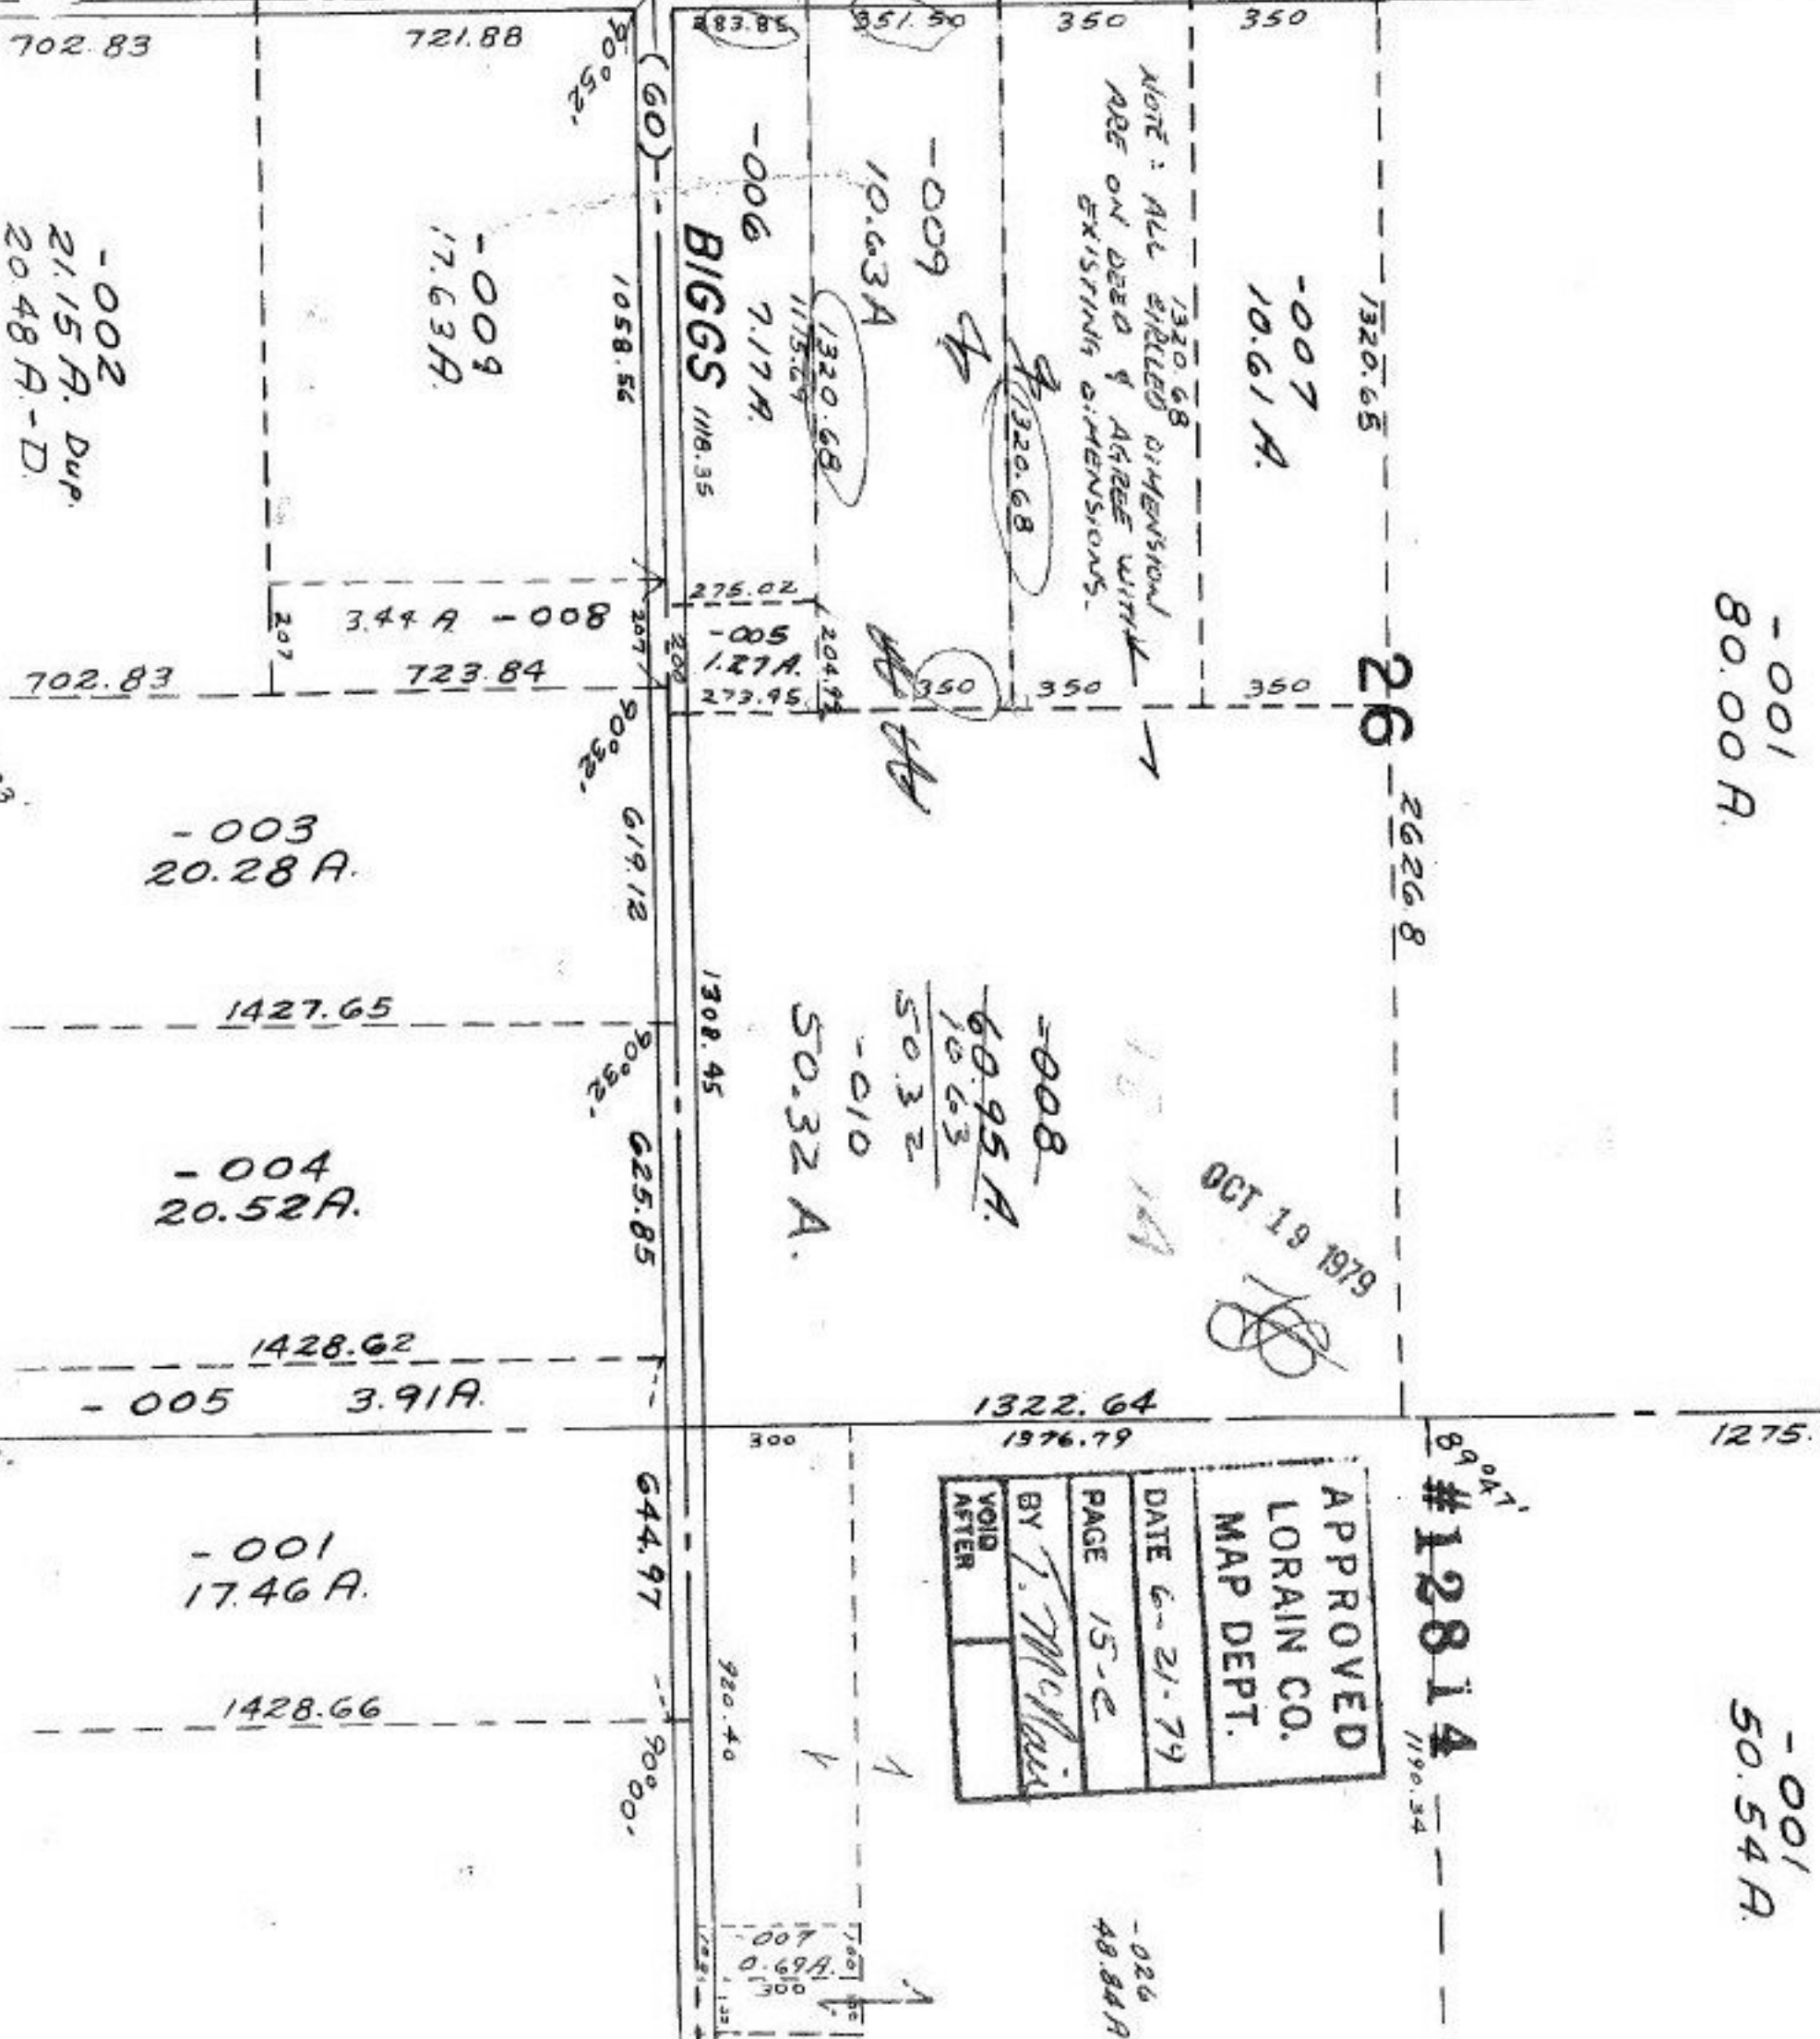

-001  
80.00 A.

-001  
50.54 A.

#12814

APPROVED  
 LORAIN CO.  
 MAP DEPT.  
 DATE 6-21-79  
 PAGE 15-C  
 BY J. McNeill  
 VOID AFTER

OCT 19 1979

NOTE: ALL ENCLOSED DIMENSIONS ARE ON DEED & AGREE WITH EXISTING DIMENSIONS.

BIGGS

-002  
21.15 A. Dup.  
20.48 A.-D.

-003  
20.28 A.

-004  
20.52 A.

-005  
3.91 A.

-001  
17.46 A.

-026  
48.84 A.