


MEDINA - NORWALK

18

60

#12842

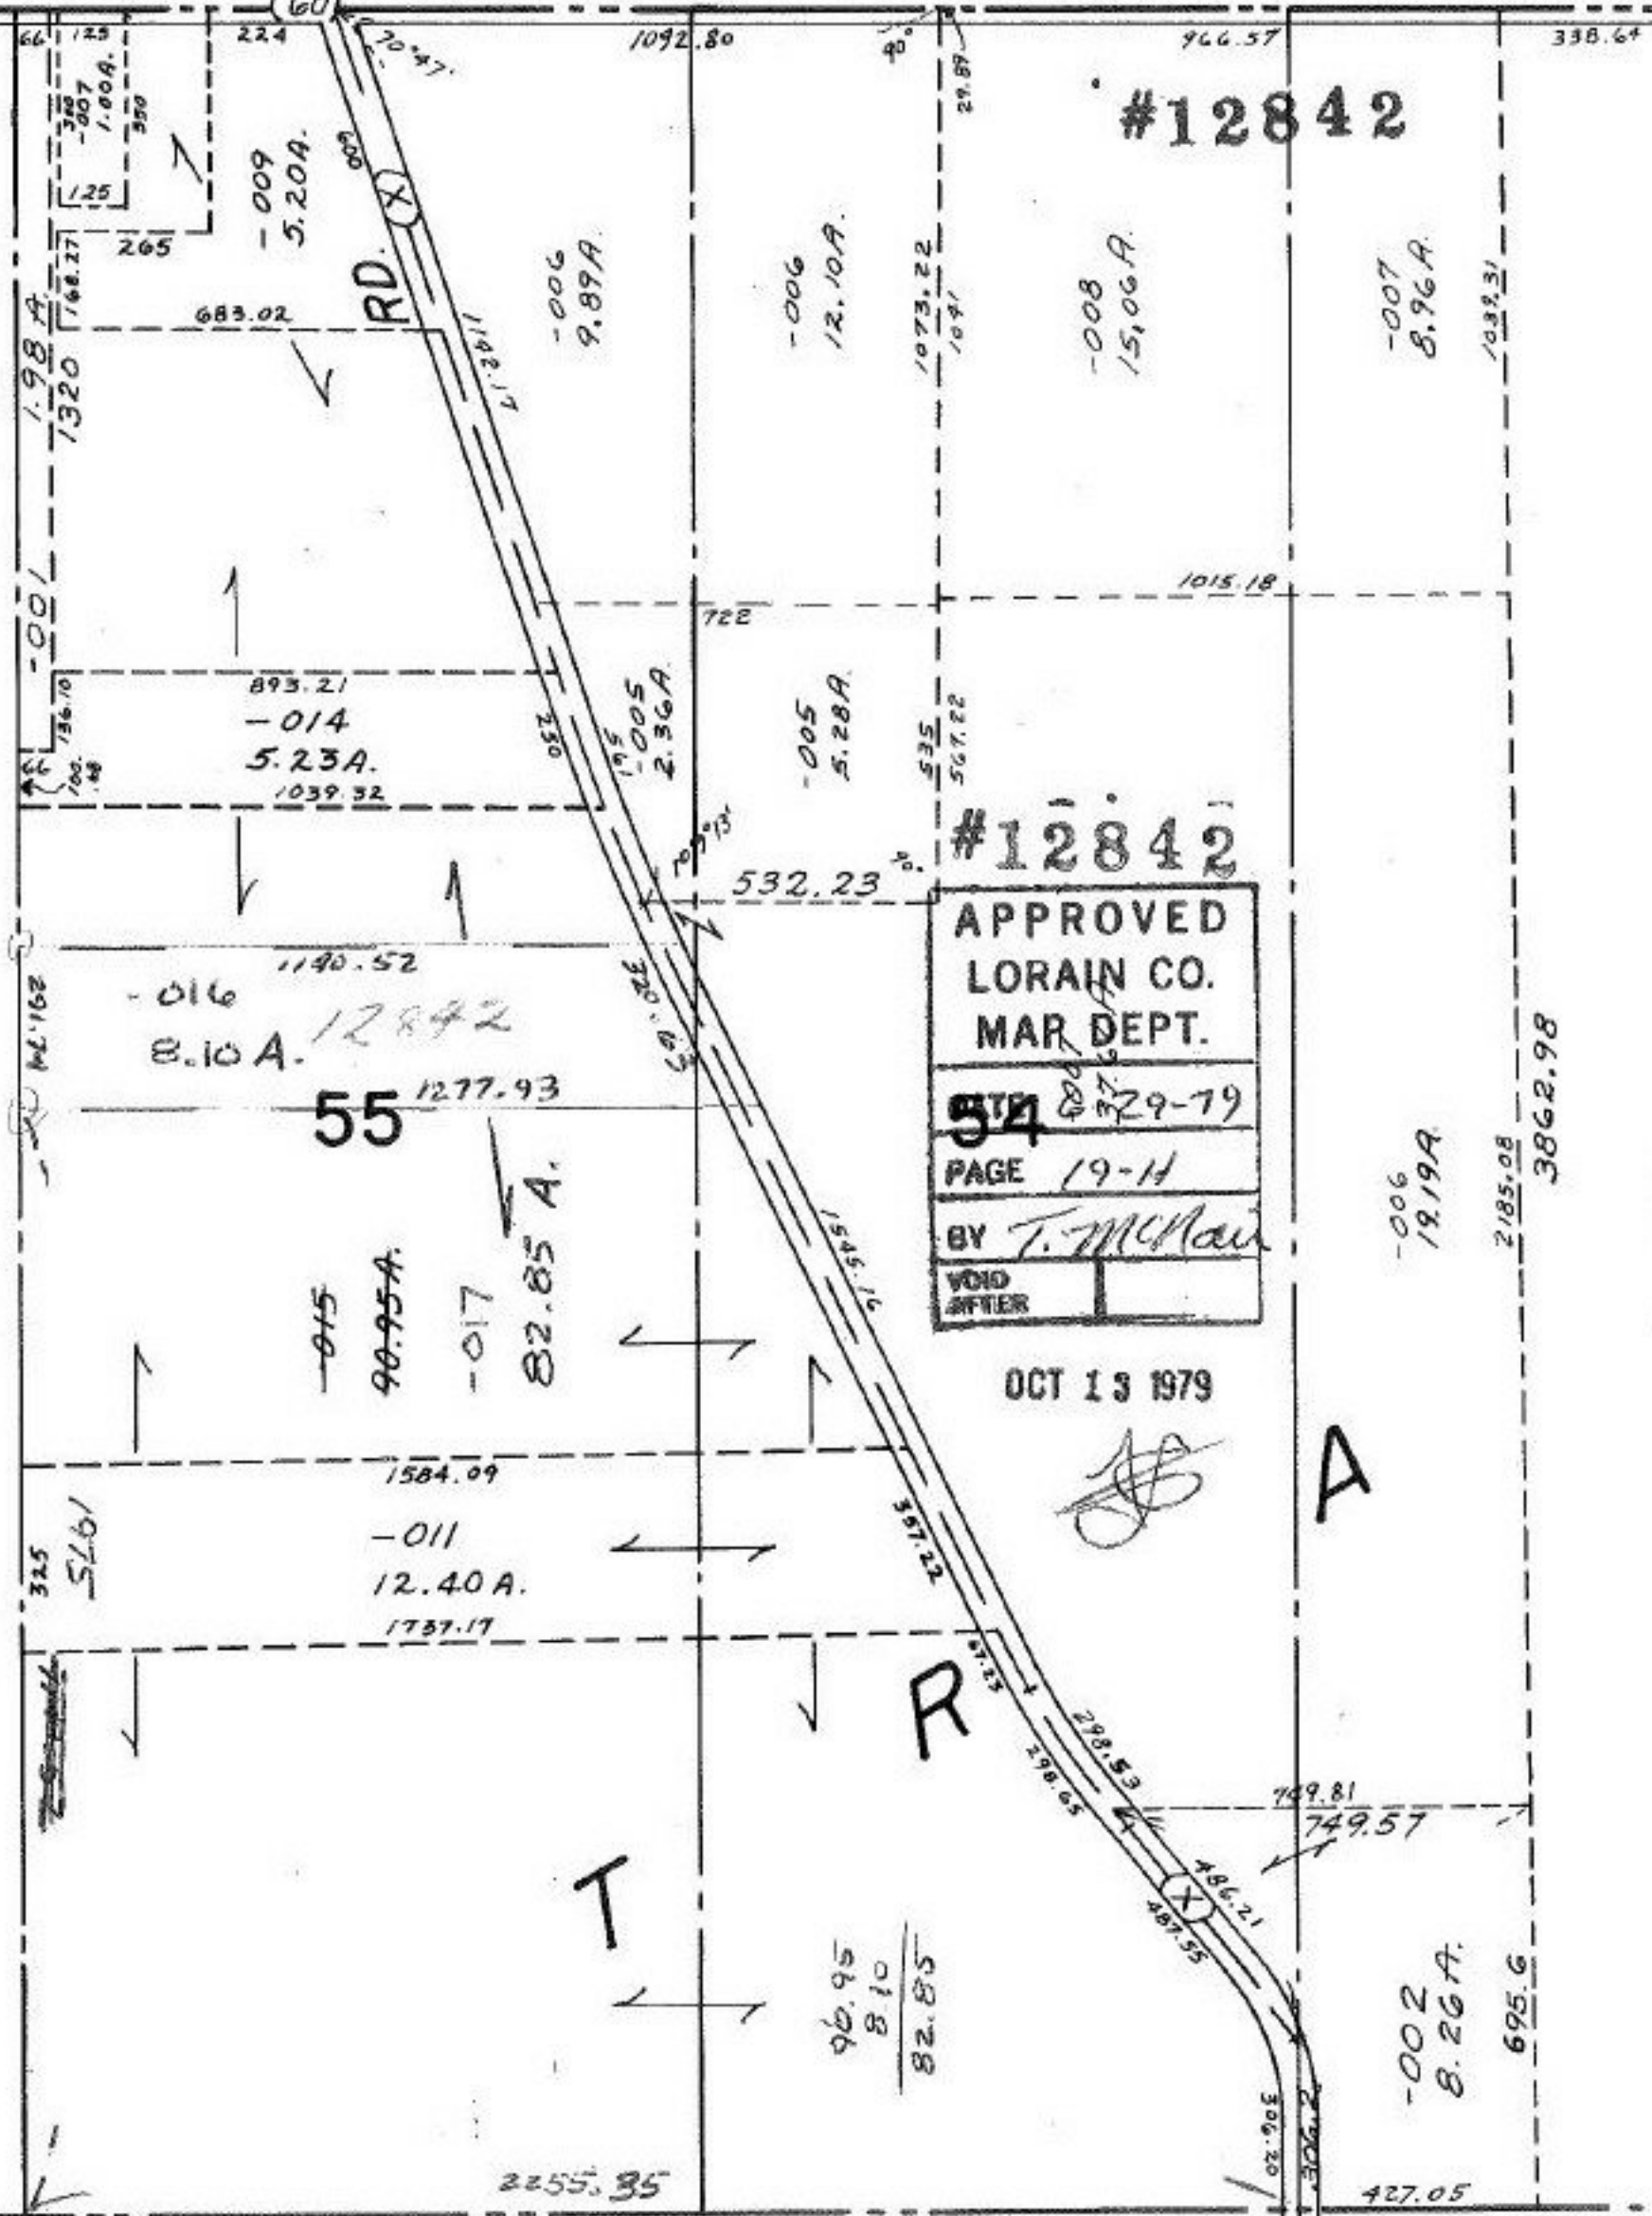

#12842
 APPROVED
 LORAIN CO.
 MAR. DEPT.
 5TH 8-29-79
 PAGE 19-14
 BY T. McNeil
 VOID AFTER

OCT 13 1979

A

R

T